


462




HARMONY MINING COMPANY
MINE NO. 1
LOWER FREEPORT COAL SEAM
PORTAGE & SUMMERHILL TWP. CAMBRIA COUNTY PA.
SCALE 1" = 200' DATE 2-1-83

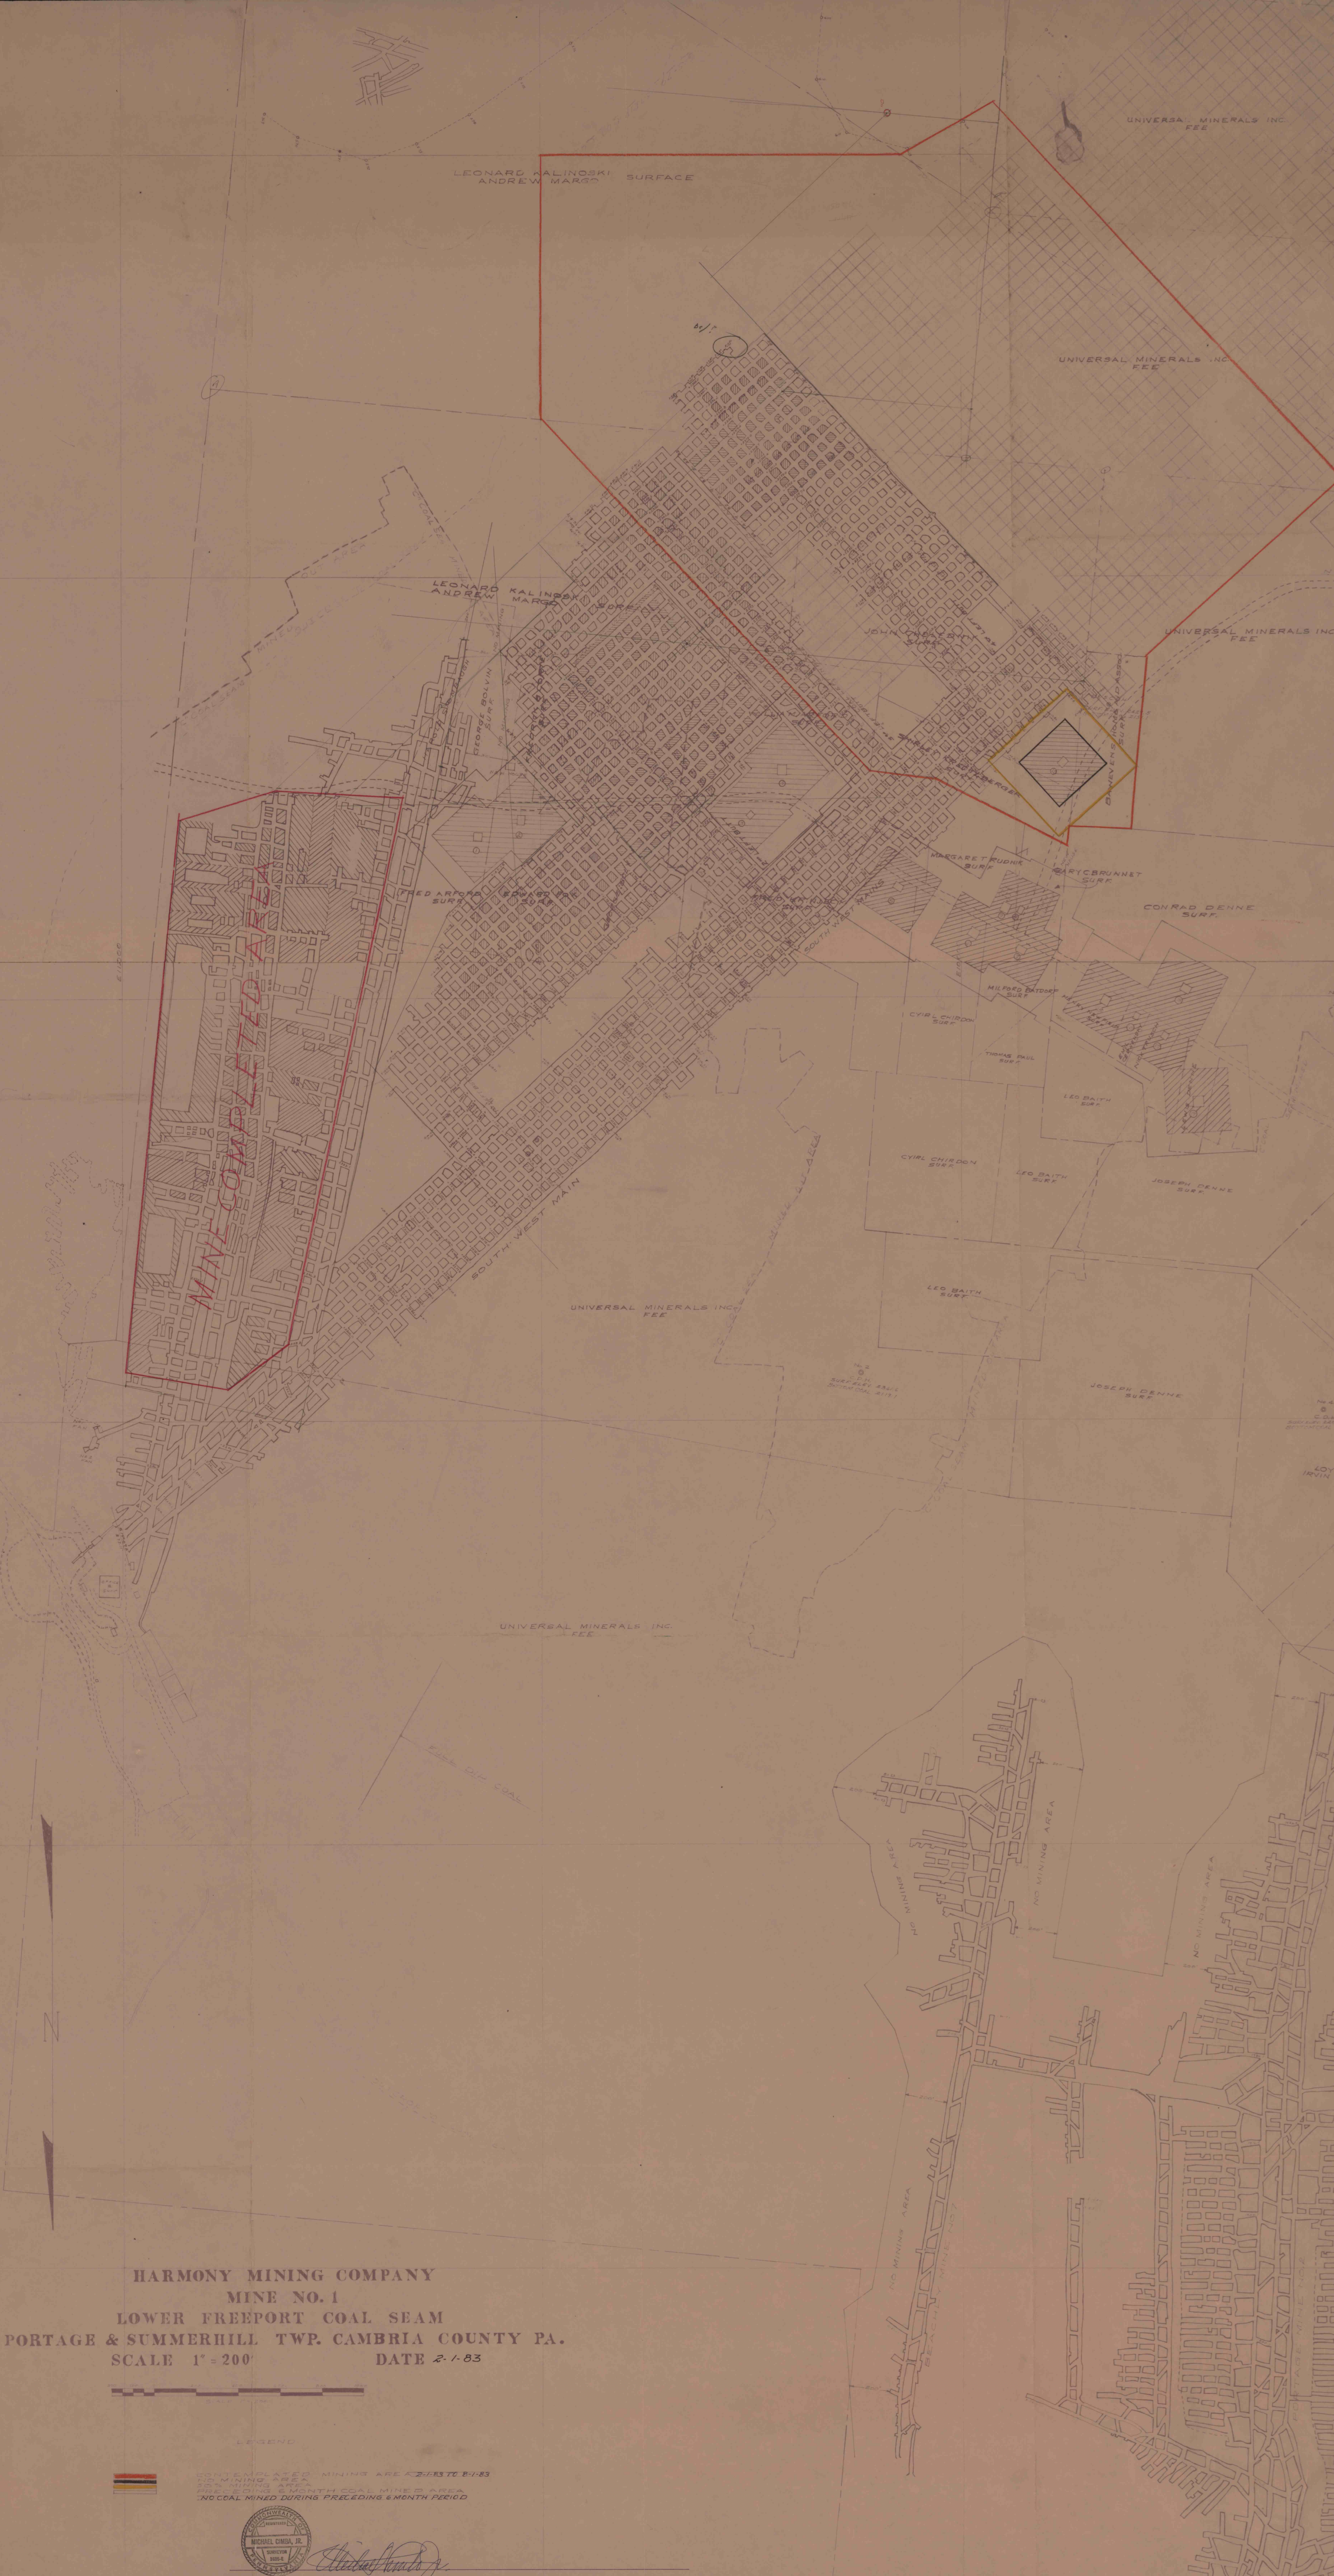

LEGEND

CONVEYED MINING AREA 2-1-83
NO MINING AREA
NO COAL MINED DURING PRECEDING 6 MONTH PERIOD

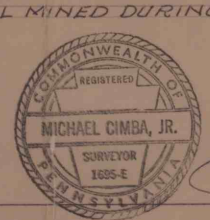

Charles H. Hodge

MAP MADE BY ENGINEERING DEPARTMENT HARMONY MINING COMPANY
B.C. Hodge

SHEET NO. 1