


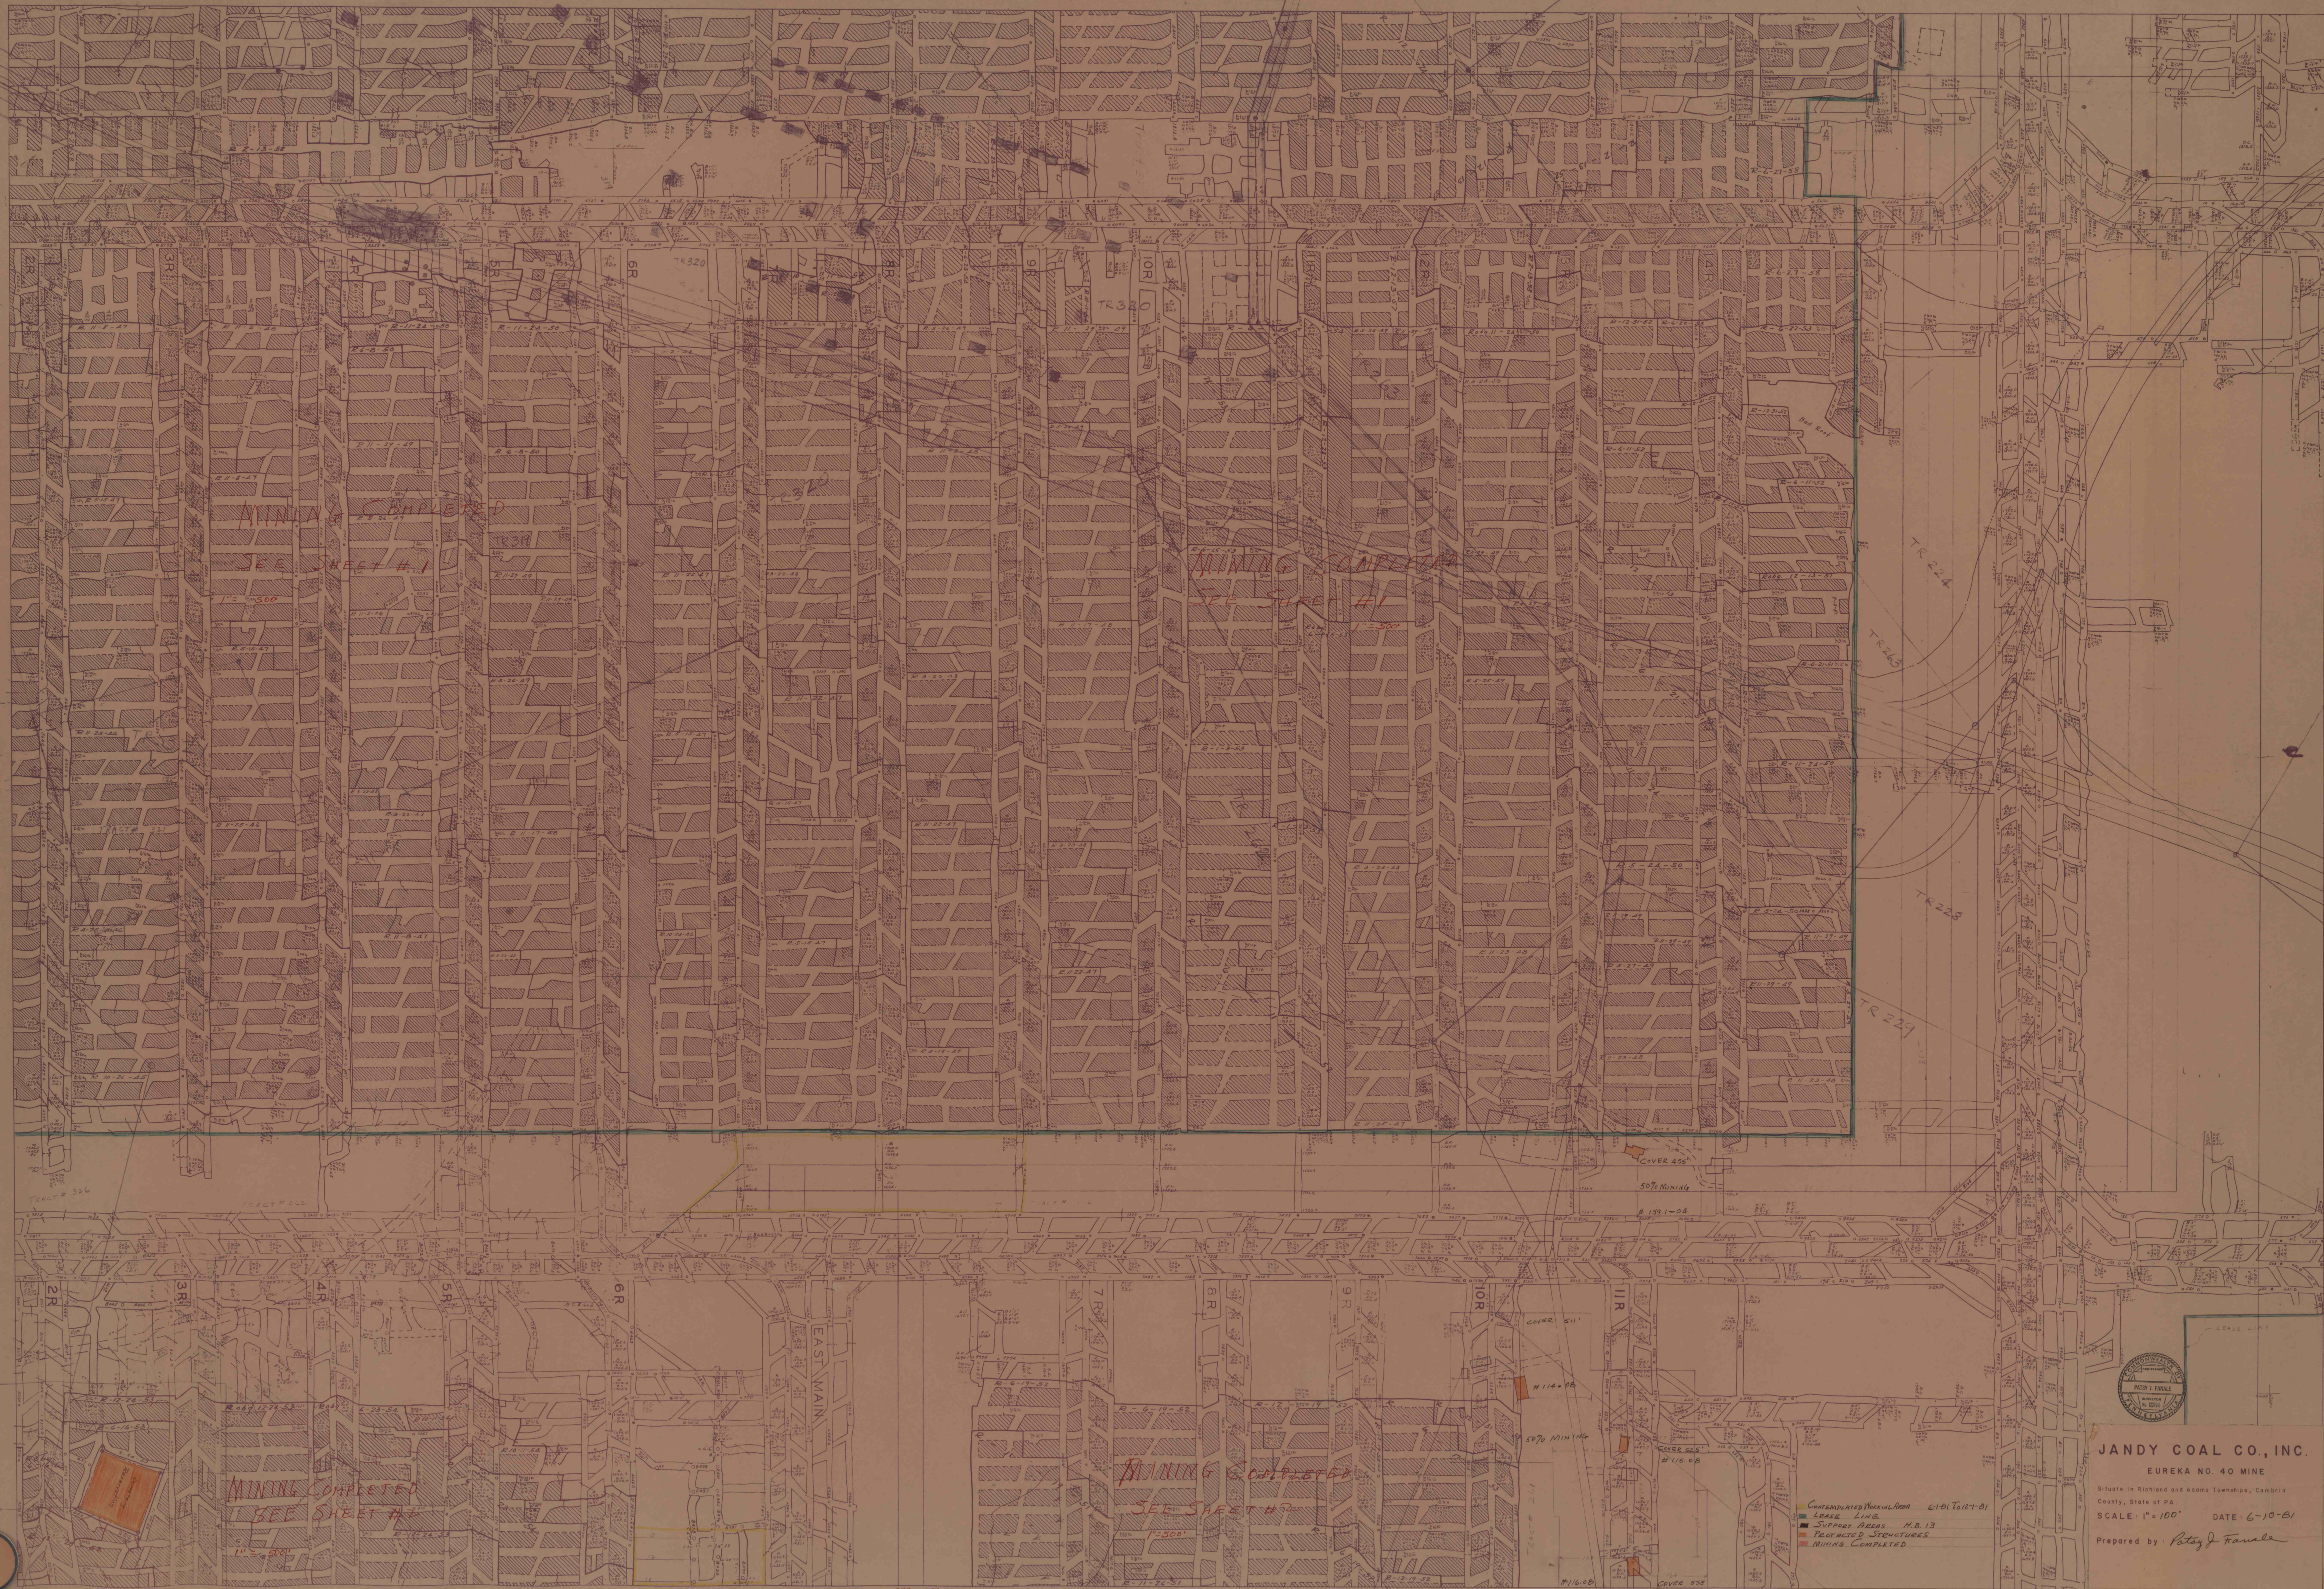

JANDY COAL CO., INC.
EUREKA NO. 40 MINE

Situate in Richmond and Adams Townships, Cambria County, State of PA.

SCALE: 1" = 100' DATE: 6-10-81

Prepared by: Patsy J. Farnale