


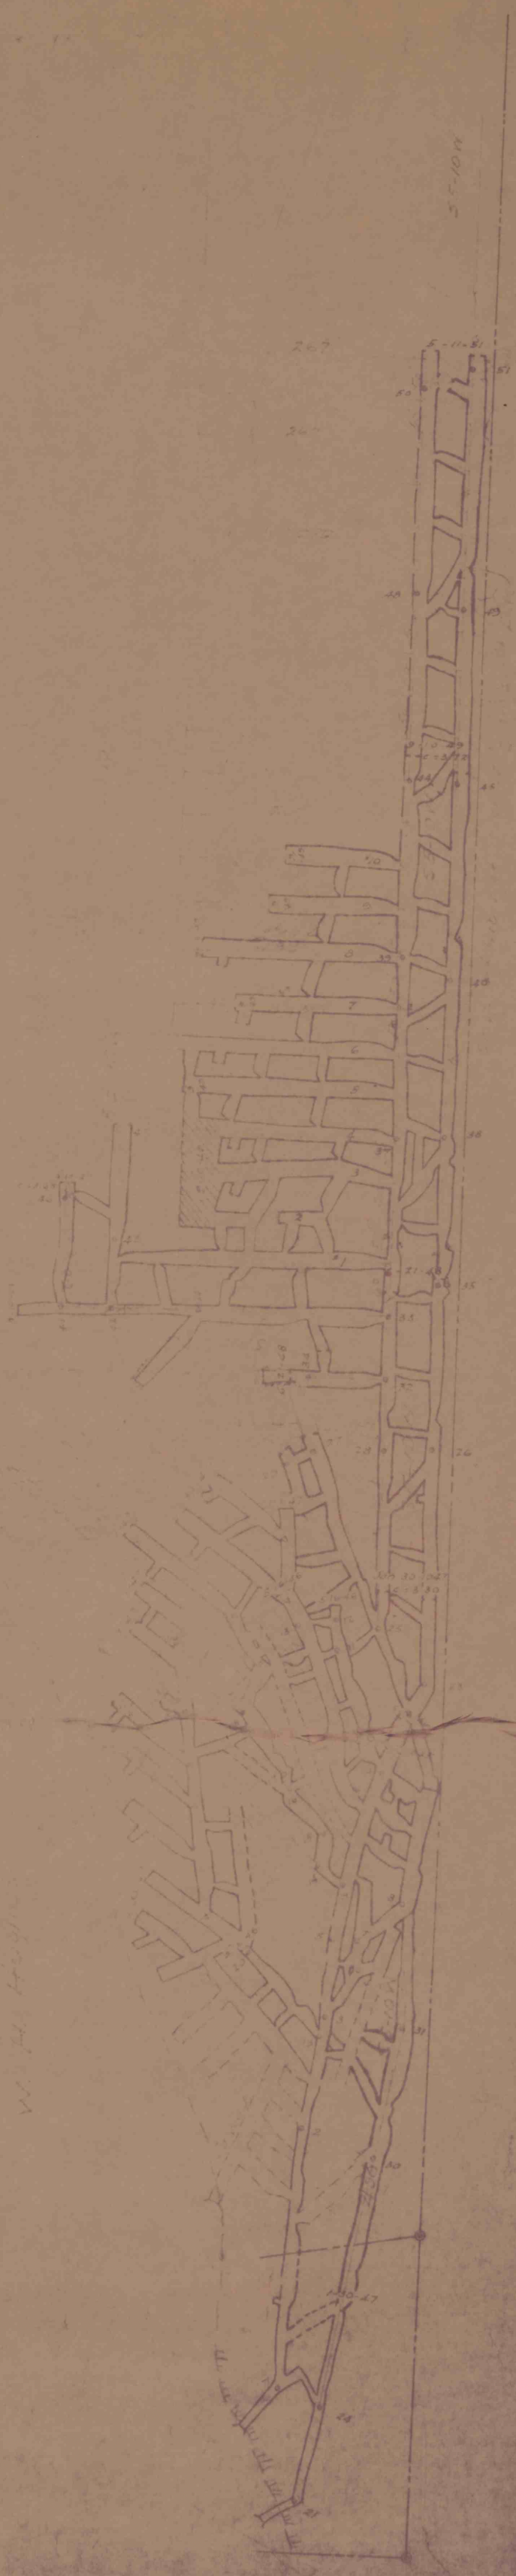

25-100 ft

W.H. Hughes


W.H. HUGHES
449