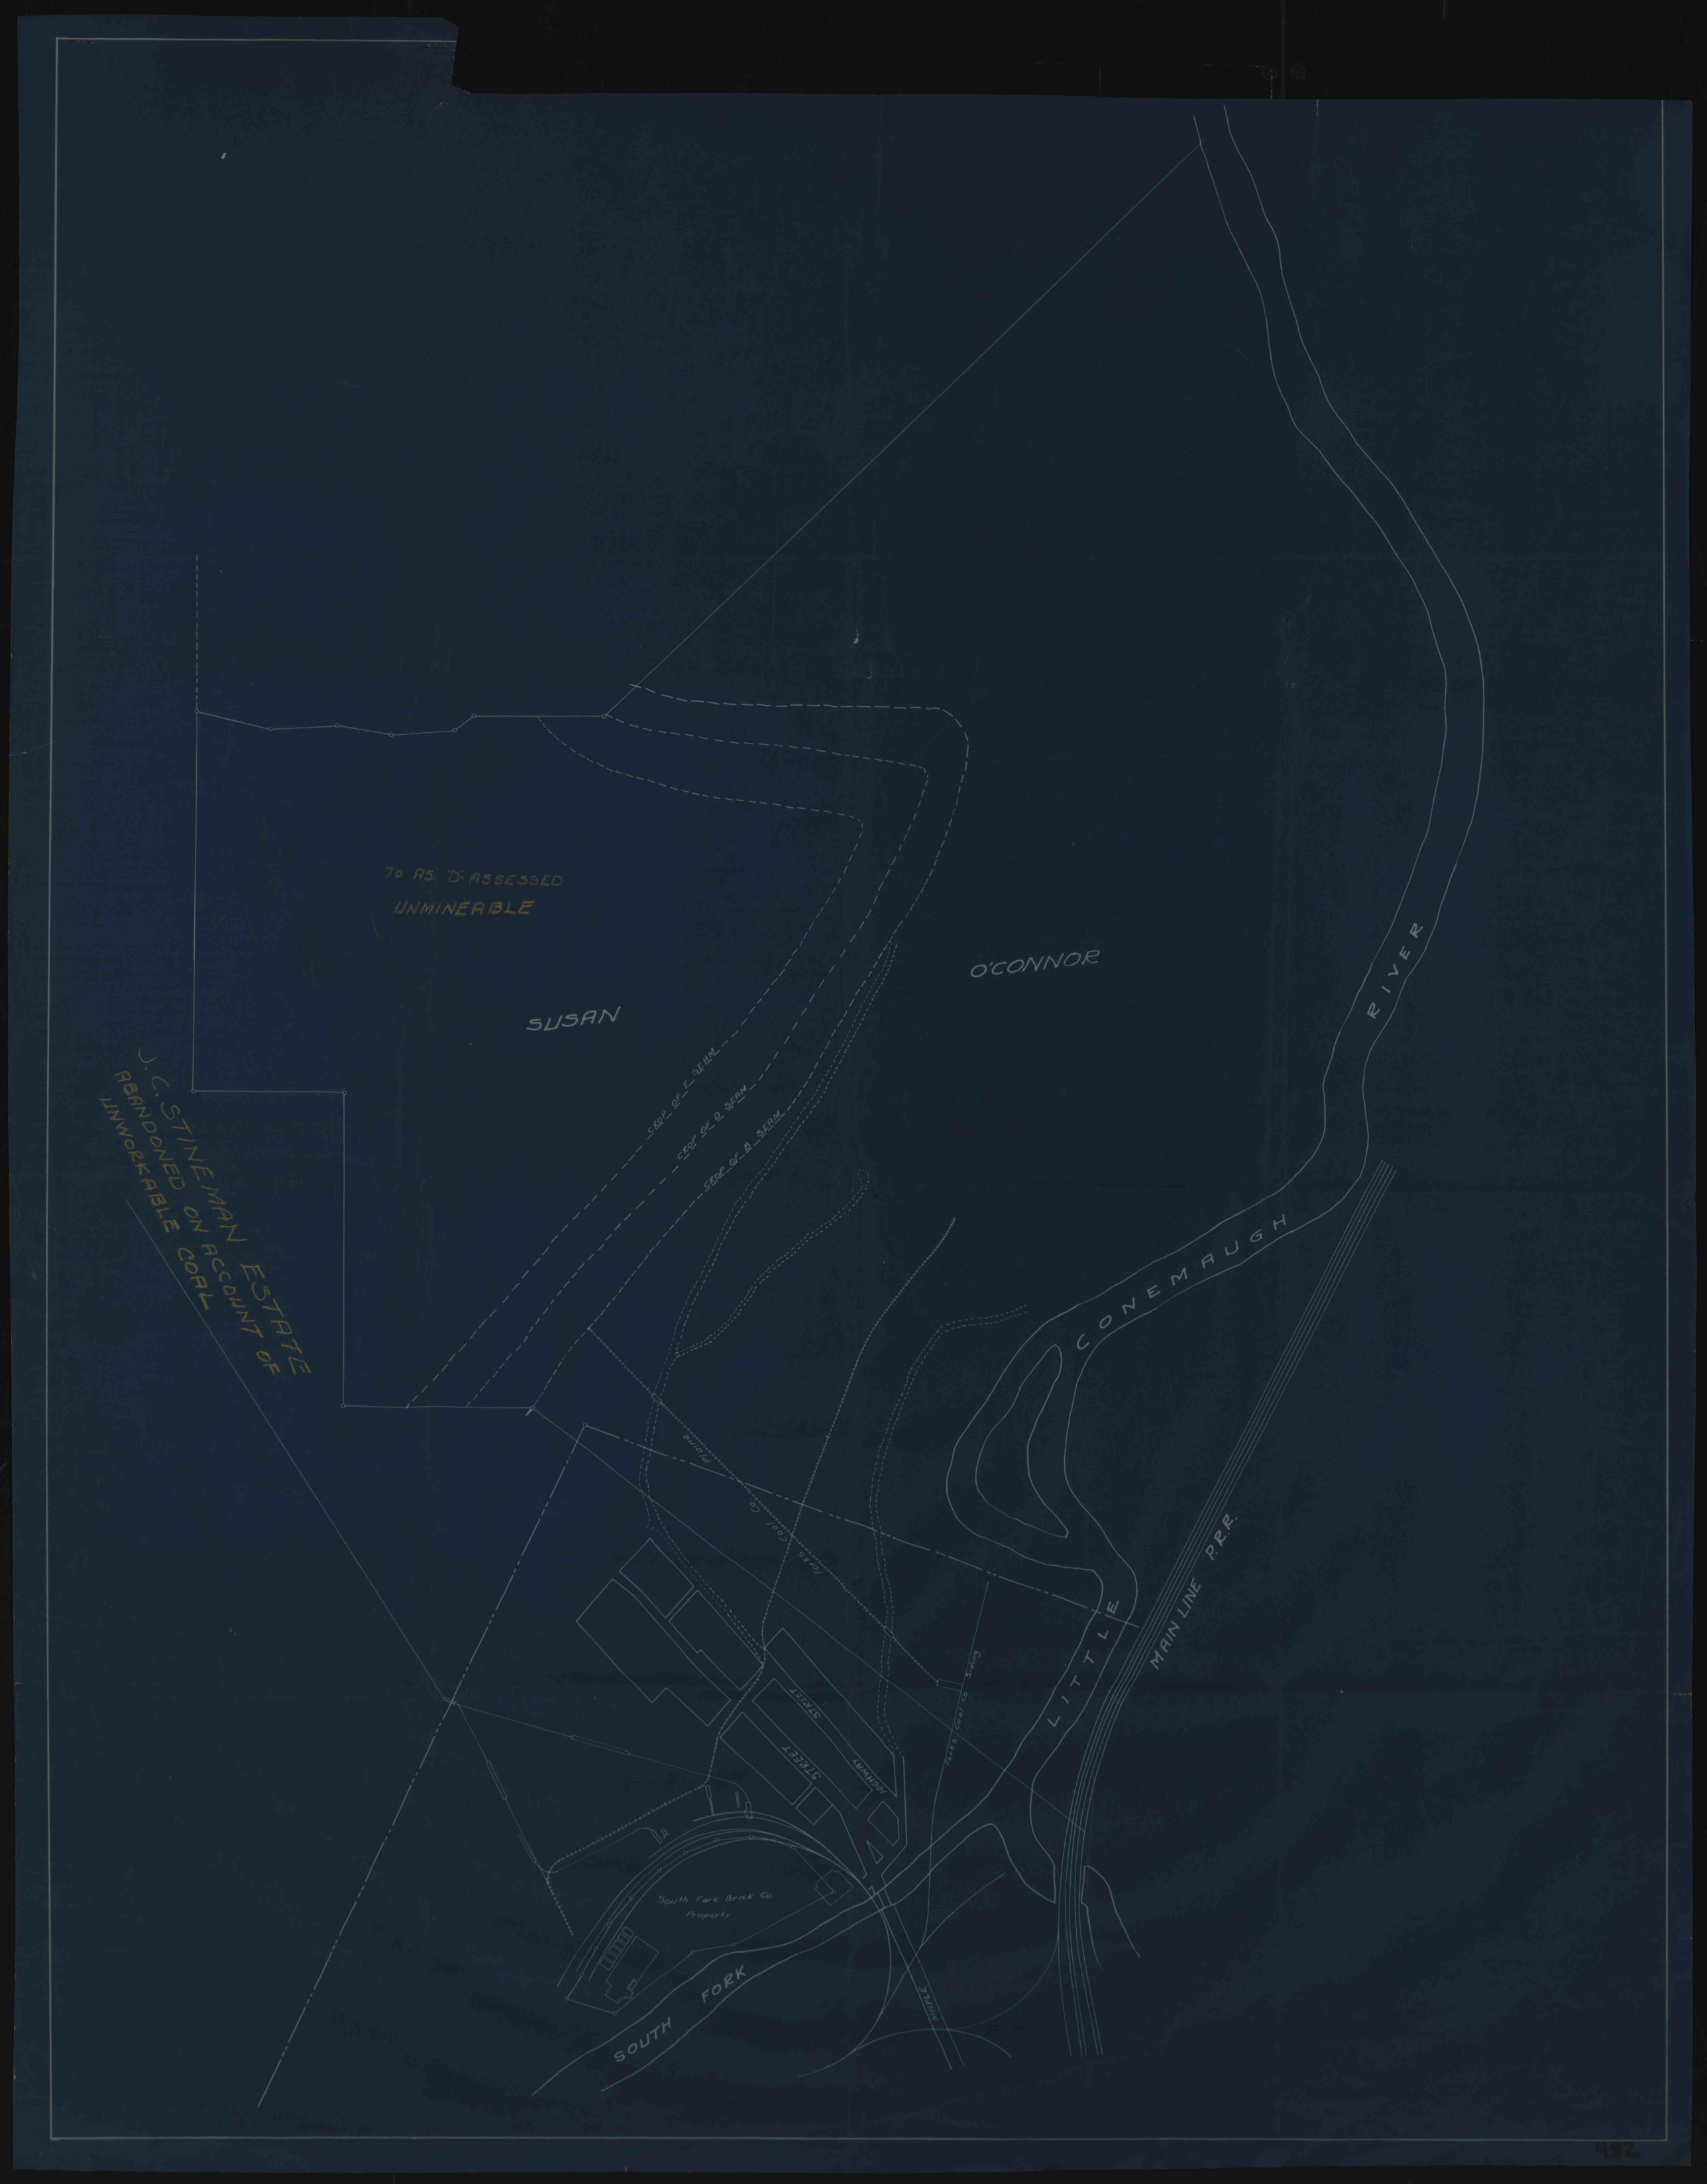
70 AS. 'D' ASSESSED
UNMINEABLE
SUSAN
O'CONNOR
RIVER
CONEMAUGH
LITTLE
MAIN LINE P.R.R.
CROP OF E SEAM
CROP OF D SEAM
CROP OF B SEAM
J. C. STINEMAN ESTATE
ABANDONED ON ACCOUNT OF
UNWORKABLE COAL
Forks Coal Co
Forks Coal Co Siding
HIGHWAY
STREET
South Fork Brick Co.
Property
SOUTH FORK
MAINE