

JOHN A. CREE

JOHN A. & DAVID K. CREE

JOHN TROXELL

SCHOOL LOT
CHURCH LOT

GLASGOW STATION

PENNA. NORTH-WESTERN

JOHN PETERSON

Flem Mulhollem Tract
1000 Acres

George L. Davis Tract
7900 Acres


Flem Mulhollem Tract
5000 Acres

JOHN HOMER

GLASGOW COAL MINING CO.

SHOWING
MINING OPERATIONS

Situate in
Roade Township, Cambria County, Penna.
Scale 1/4" = 1 Mile
Civil & Mining Engineers
June 22, 1921

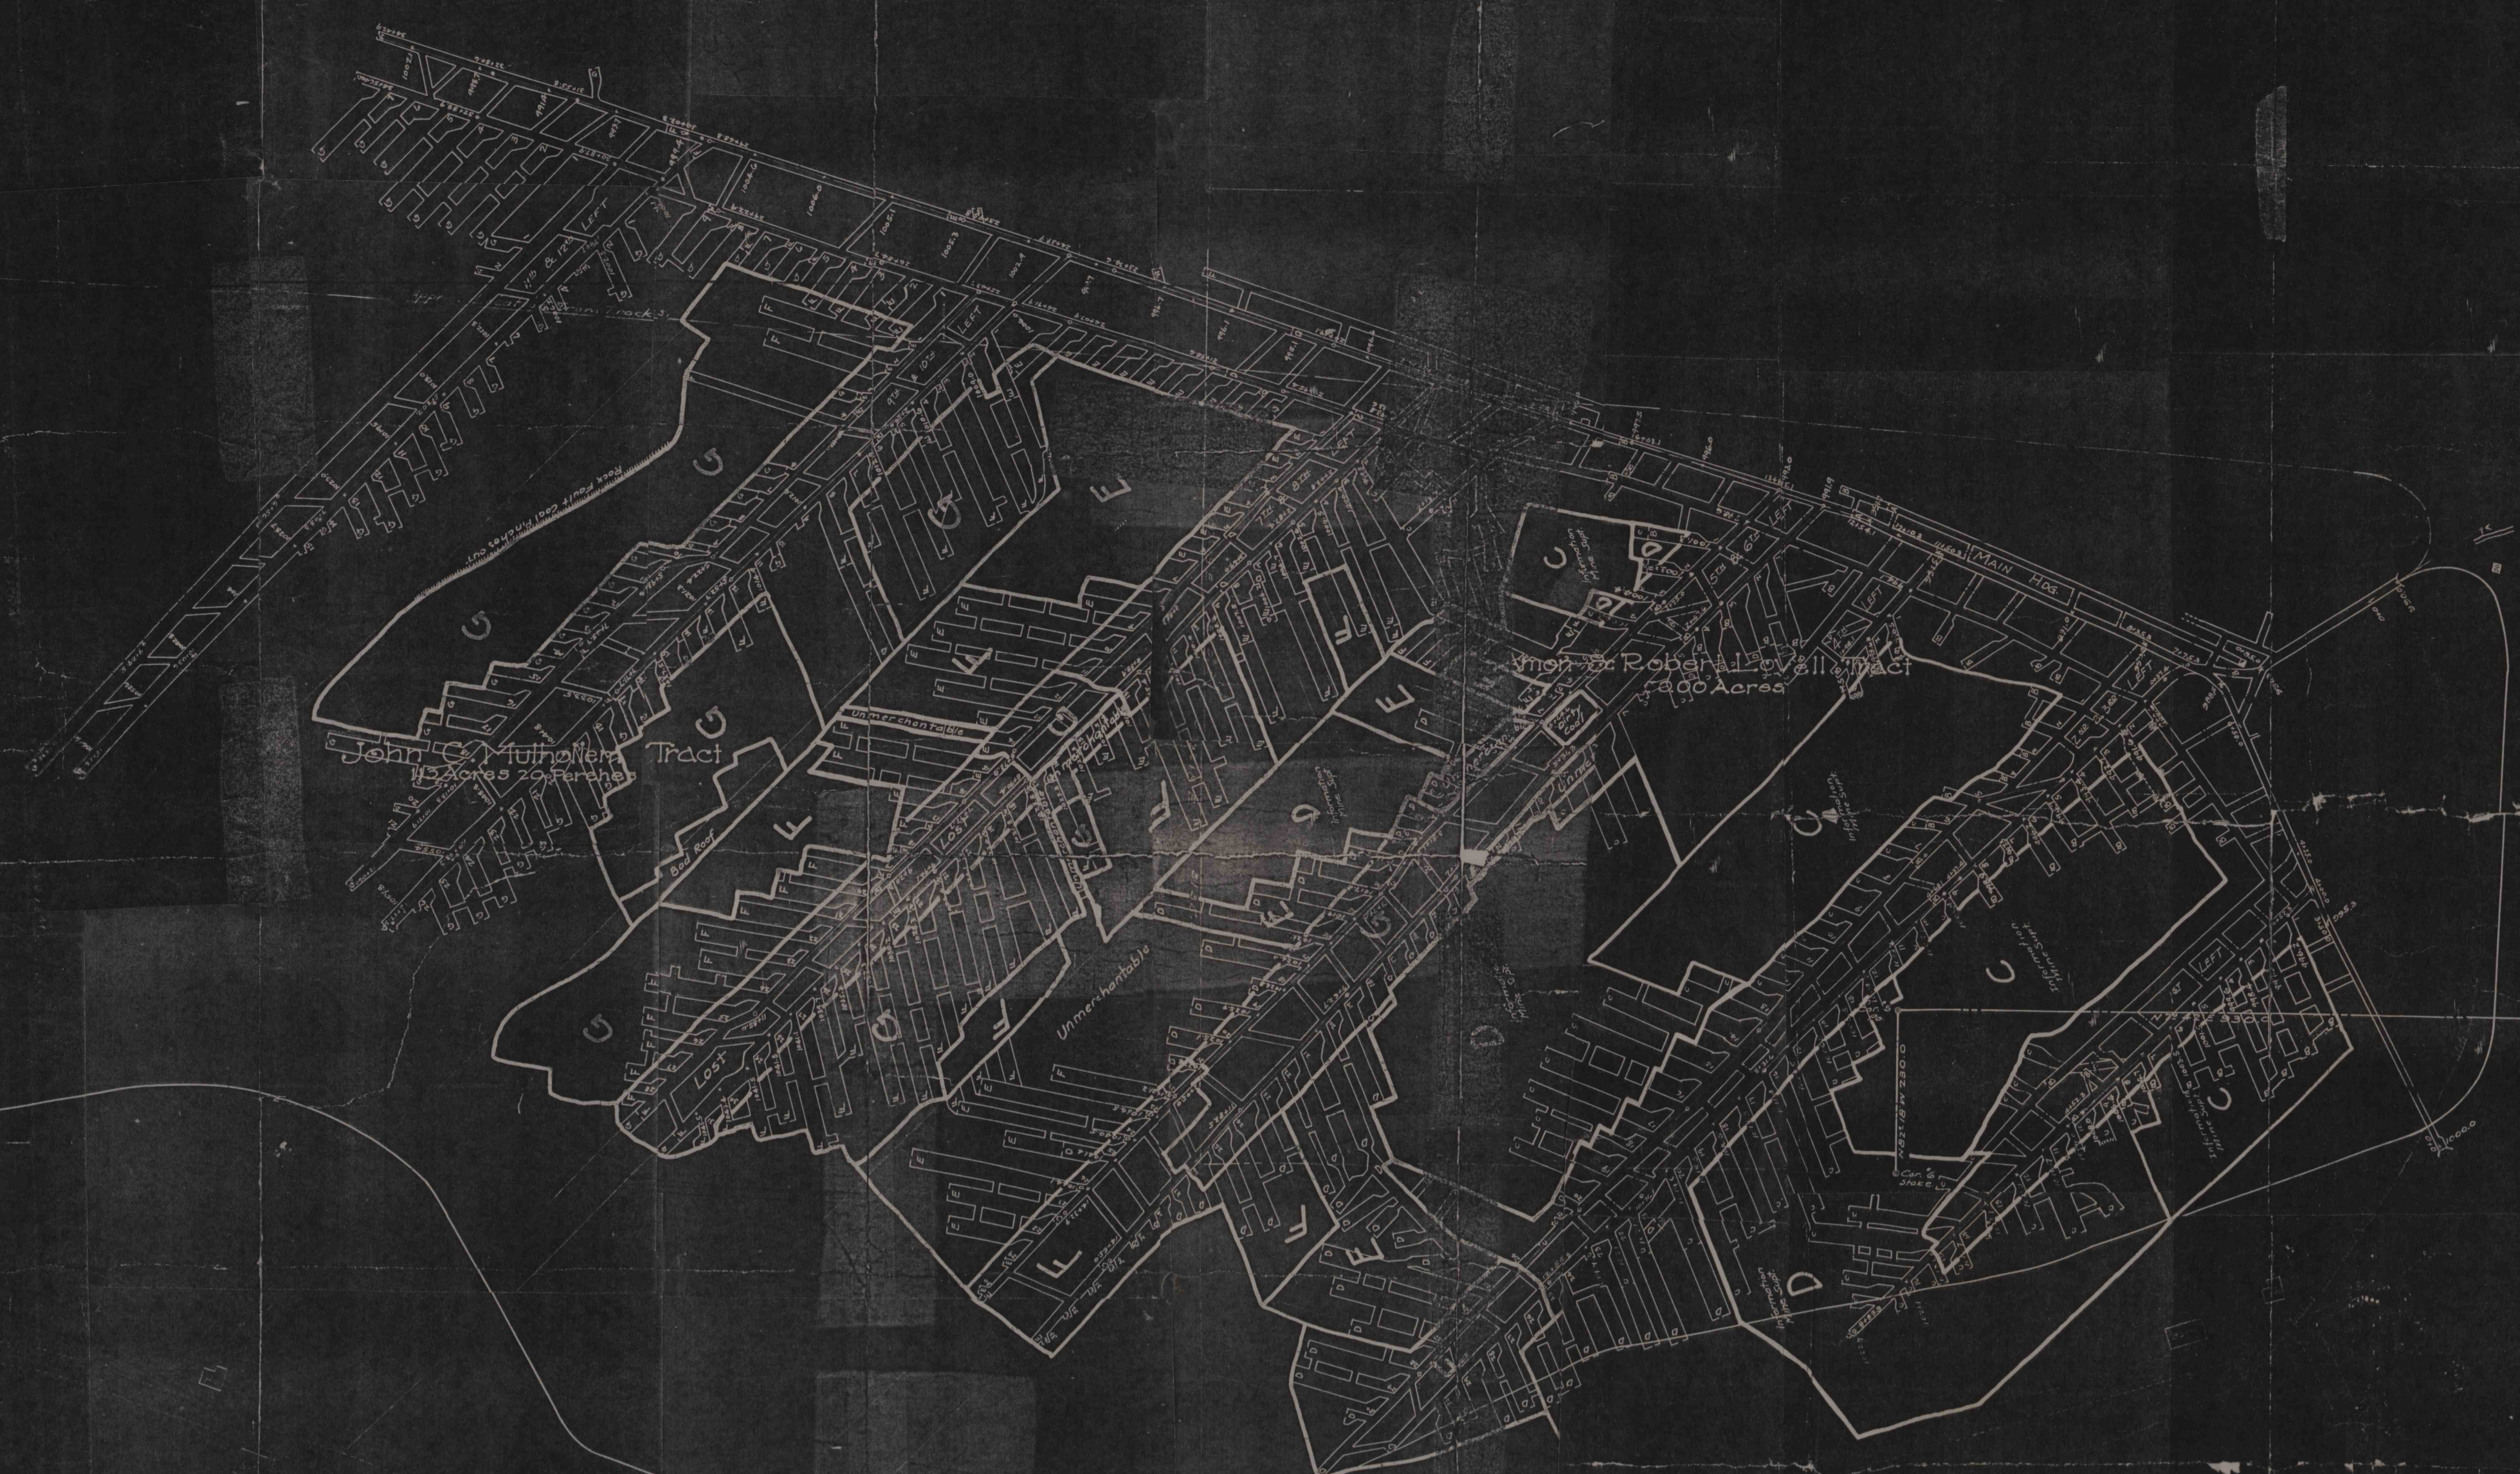

Irwin Tract
5500 Acres

INDEX TO SURVEYS			
Letter	Date	Surveyed by	Plotted by
A	June 14, 1921	D. H. Adams	D. H. Adams
B	Jan. 8, 1922	Tract 2 West	Tract 2 West
C	May 27, 1922	D. H. Adams	D. H. Adams
D	June 8, 1922	Tract 2 West	Tract 2 West