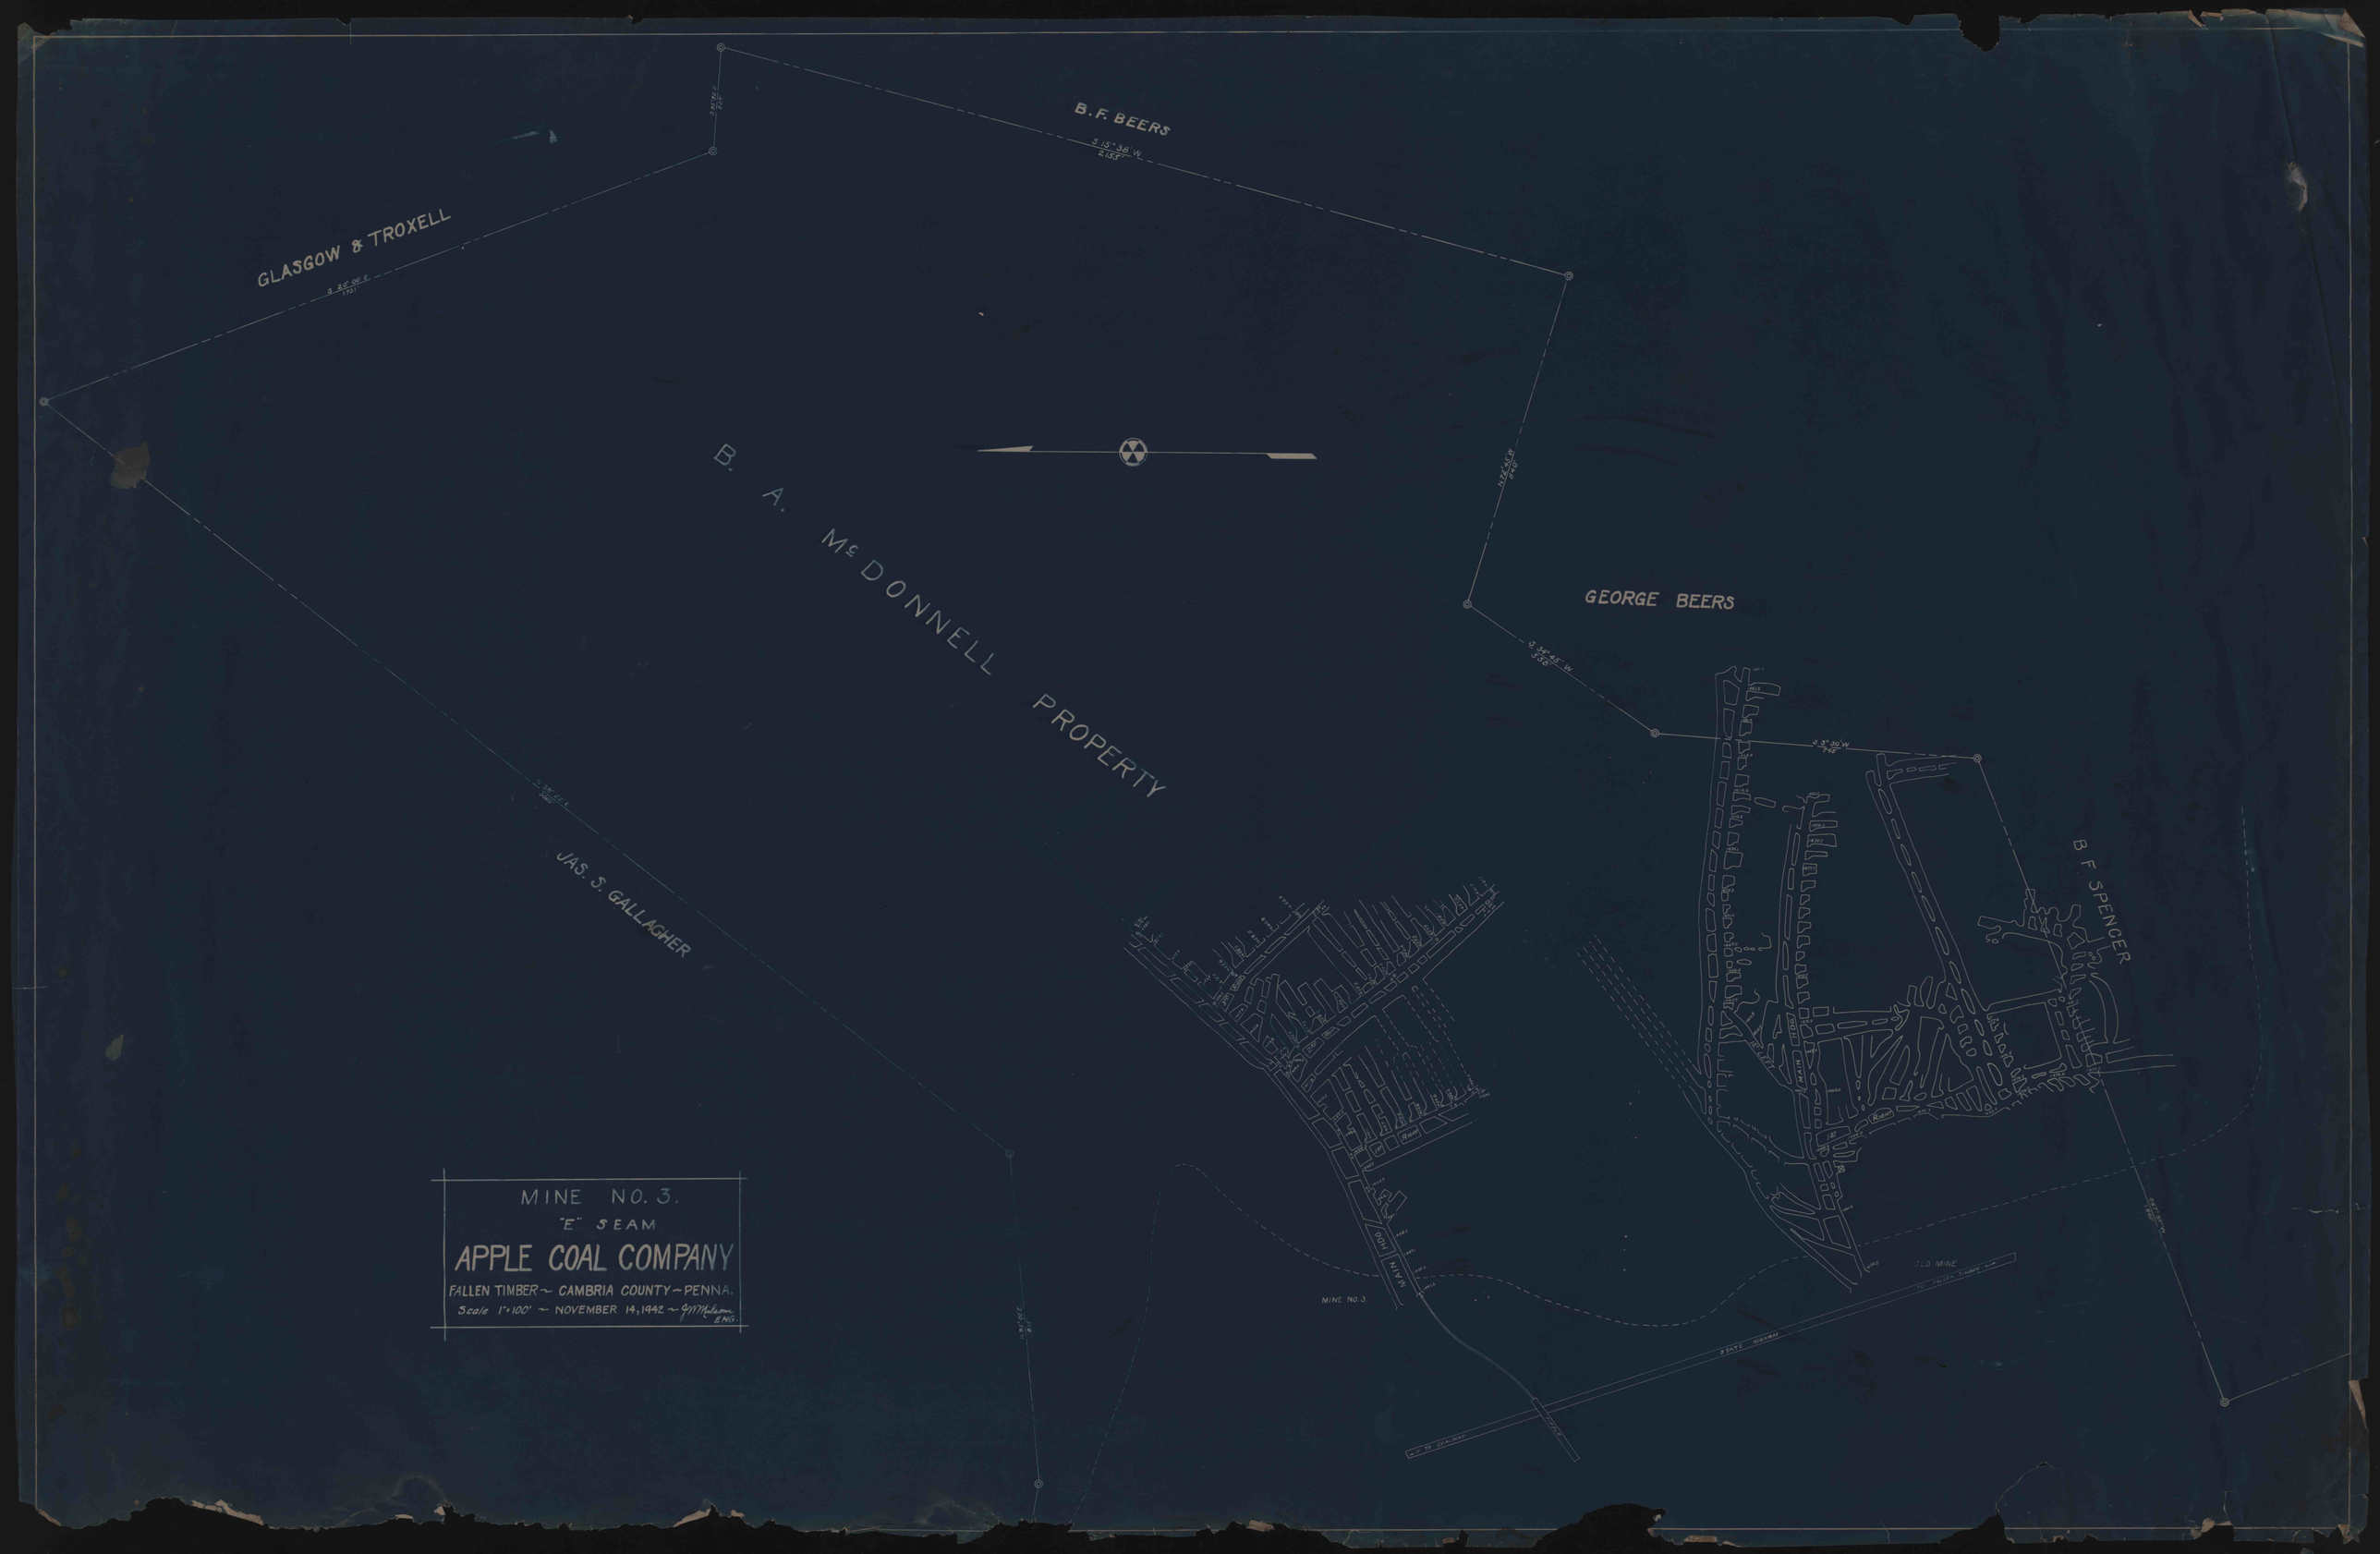
B.F. BEERS
S 15° 38' W
GLASGOW & TROXELL
S 25° 00' E
1931'
B. A. McDONNELL PROPERTY
GEORGE BEERS
S 34° 45' W
336'
S 3° 30' W
JAS. J. GALLAGHER
B F SPENCER
MINE NO. 3.
"E" SEAM
APPLE COAL COMPANY
FALLEN TIMBER ~ CAMBRIA COUNTY ~ PENNA.
Scale 1" = 100' ~ NOVEMBER 14, 1942 ~ G.M. McLean ENG.
MINE NO. 3.
MAIN
OLD MINE
STATE HIGHWAY