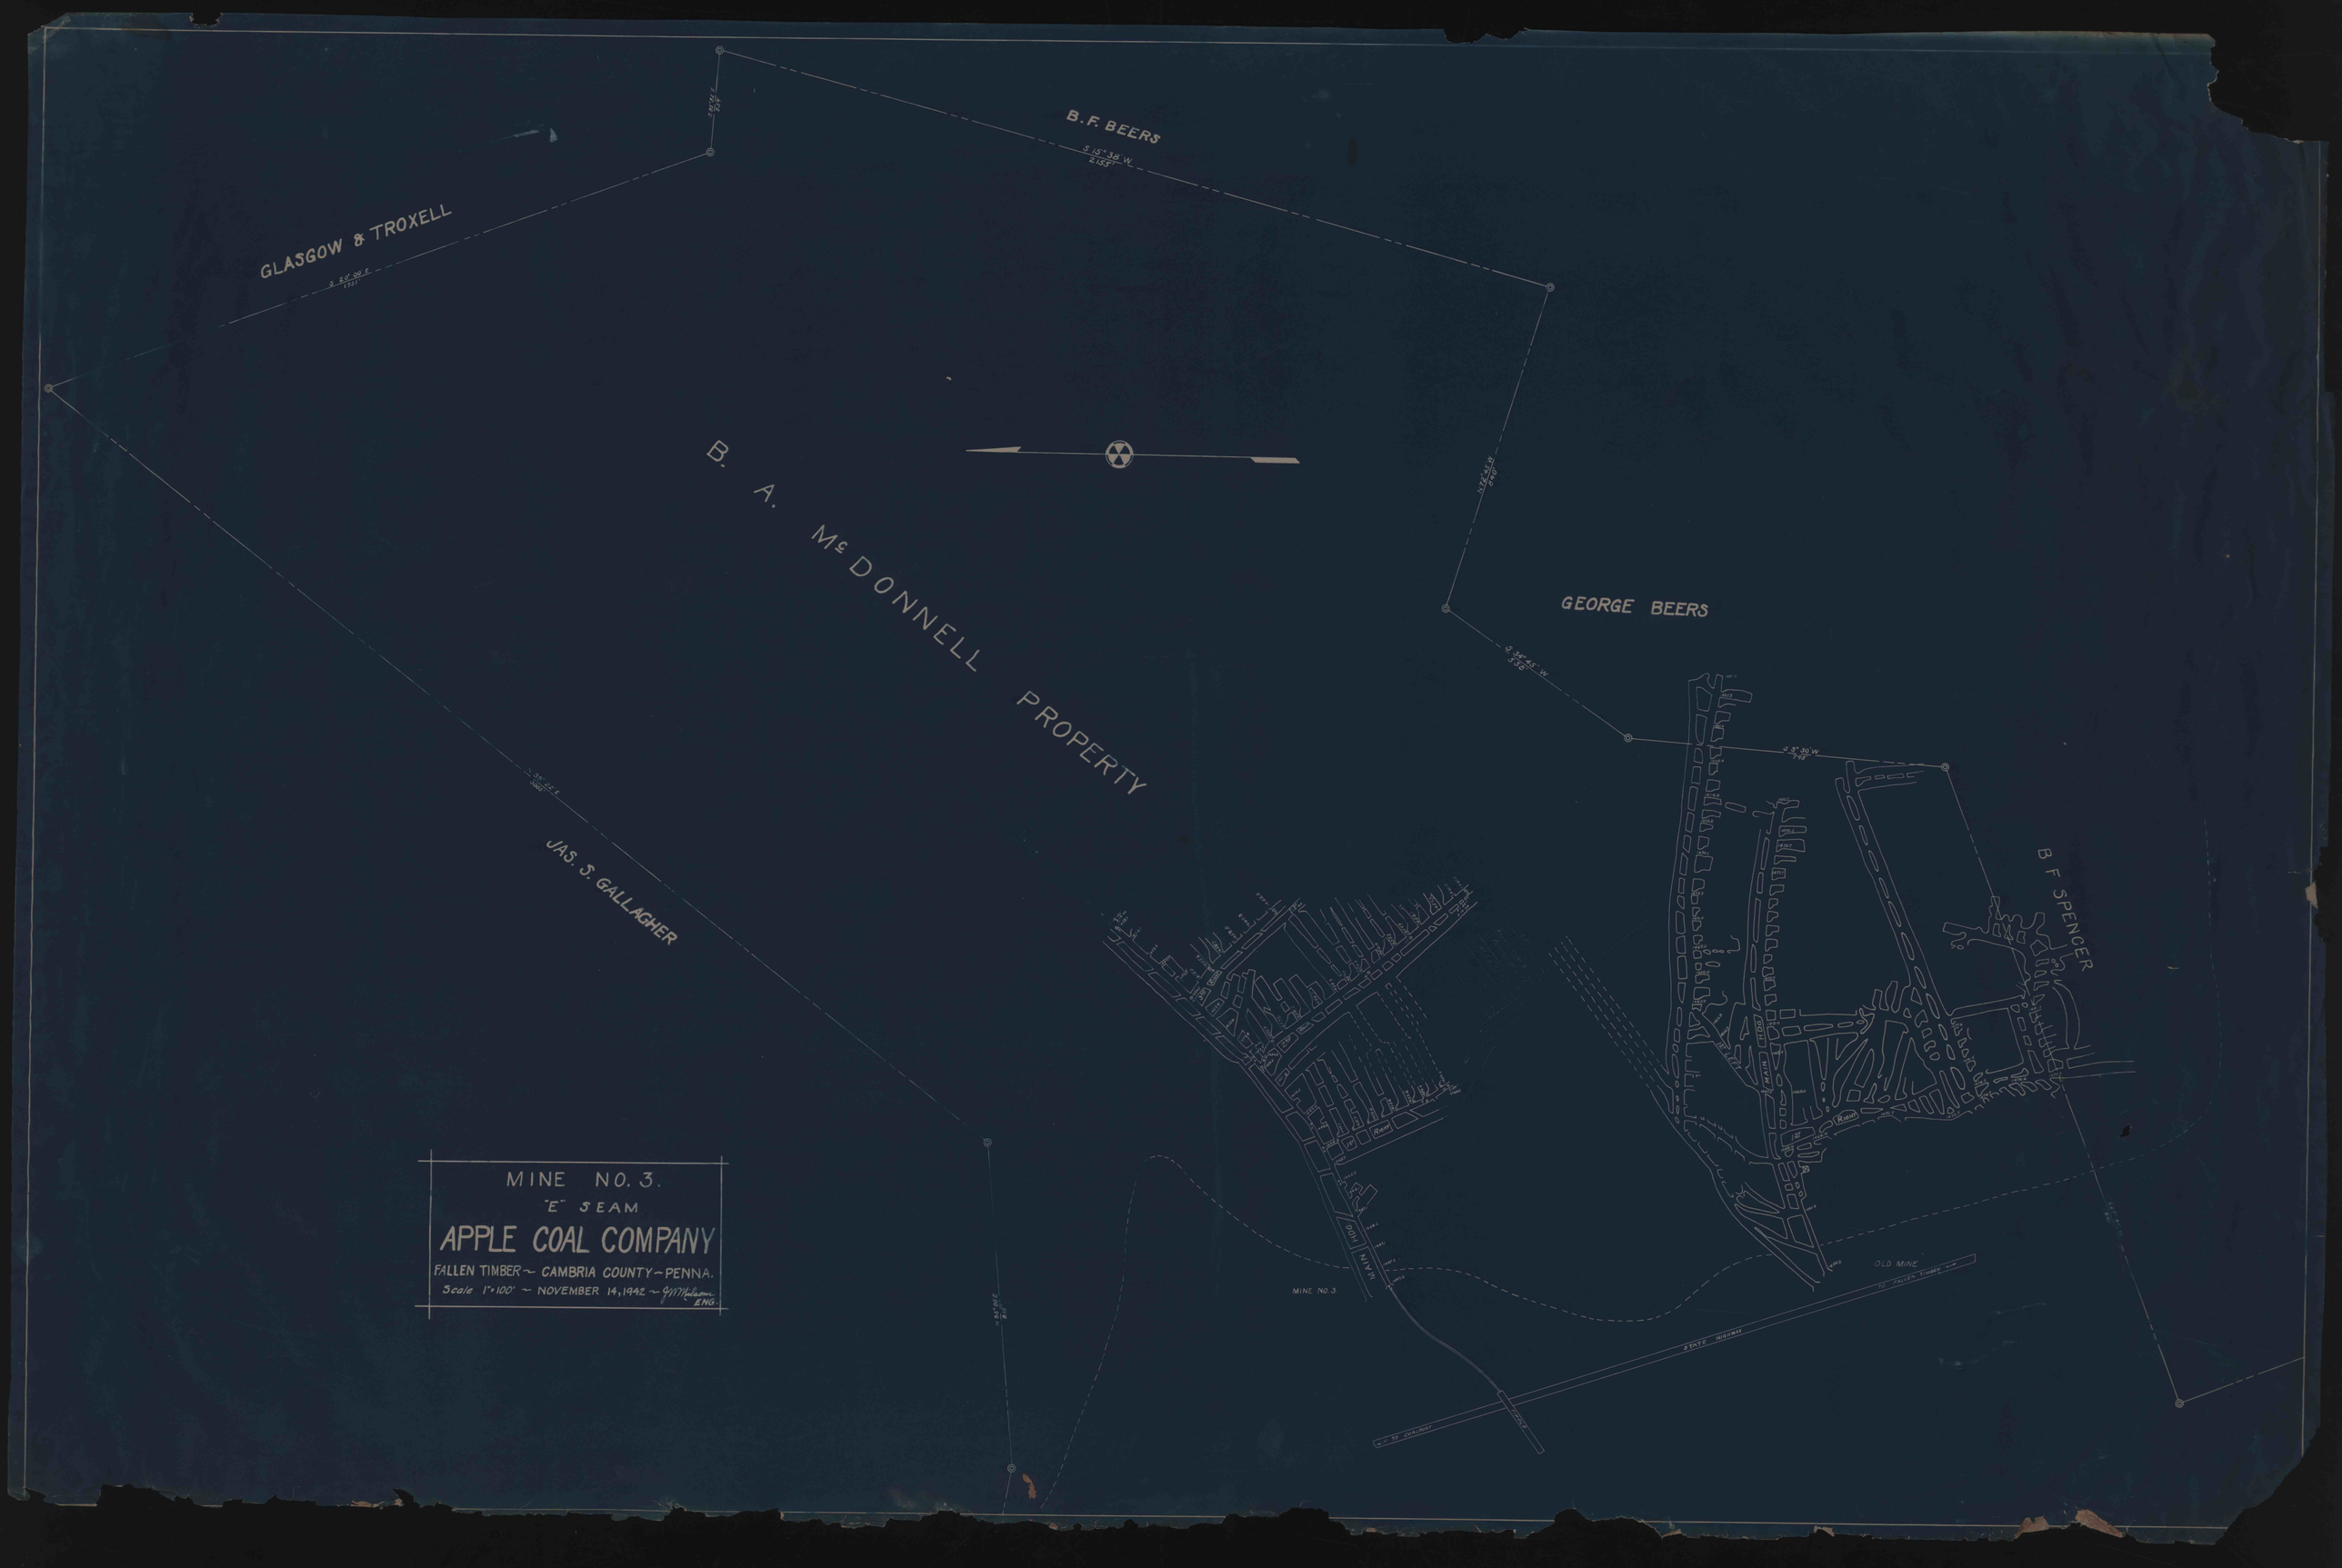
B.F. BEERS
S 15° 38' W
2165'
GLASGOW & TROXELL
S 20° 00' E
1721'
B. A. McDONNELL PROPERTY
GEORGE BEERS
S 34° 45' W
3.53'
S 31° 30' W
7.15'
JAS. J. GALLAGHER
B F SPENCER
MINE NO. 3.
"E" SEAM
APPLE COAL COMPANY
FALLEN TIMBER ~ CAMBRIA COUNTY ~ PENNA.
Scale 1" = 100' ~ NOVEMBER 14, 1942 ~ G.M. Nelson ENG.
MAIN ROAD
MINE NO. 3
OLD MINE
TO FALLEN TIMBER
STATE HIGHWAY
TO DUNLIMOT