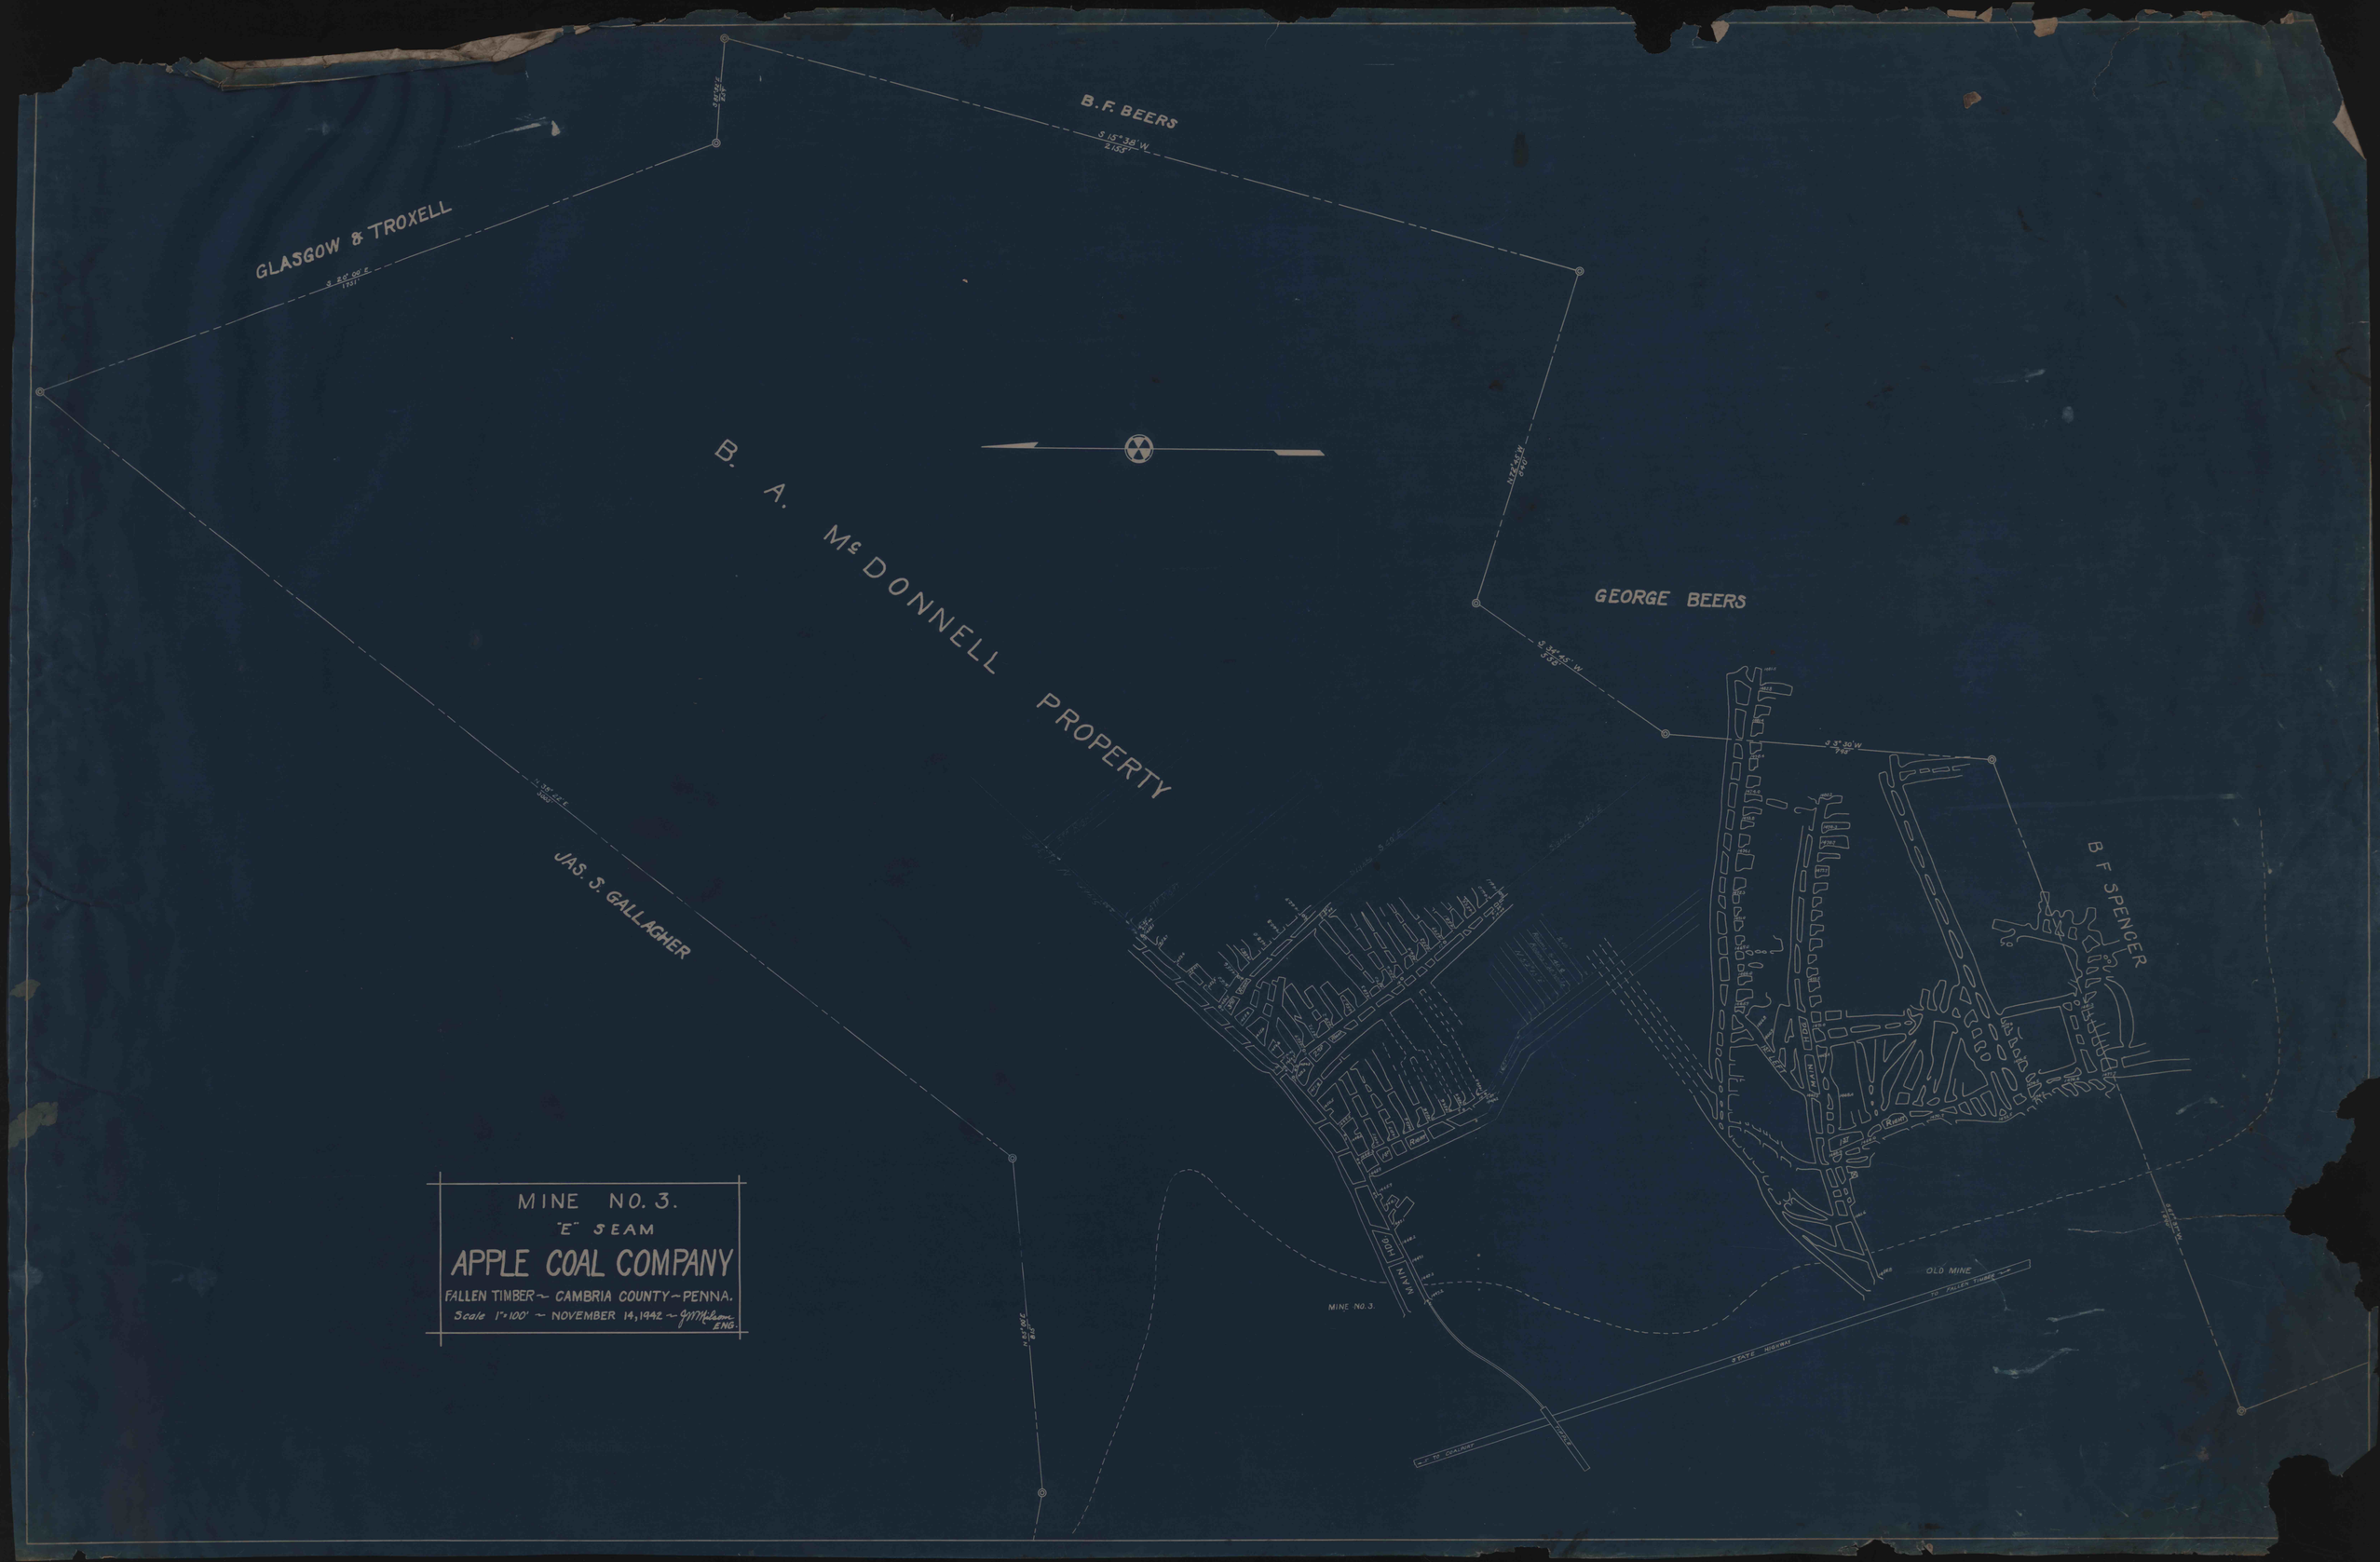
B. F. BEERS
S 15° 38' W.
GLASGOW & TROXELL
S 20° 00' E
1731'
B. A. McDONNELL PROPERTY
GEORGE BEERS
S 35° 45' W
353'
S 3° 30' W
740'
JAS. S. GALLAGHER
B F SPENCER
MINE NO. 3.
"E" SEAM
APPLE COAL COMPANY
FALLEN TIMBER ~ CAMBRIA COUNTY ~ PENNA.
Scale 1" = 100' ~ NOVEMBER 14, 1942 ~ G. M. McKeown ENG.
MAIN
MINE NO. 3.
OLD MINE
TO FALLEN TIMBER
STATE HIGHWAY
R.R. TO COAL RAY