


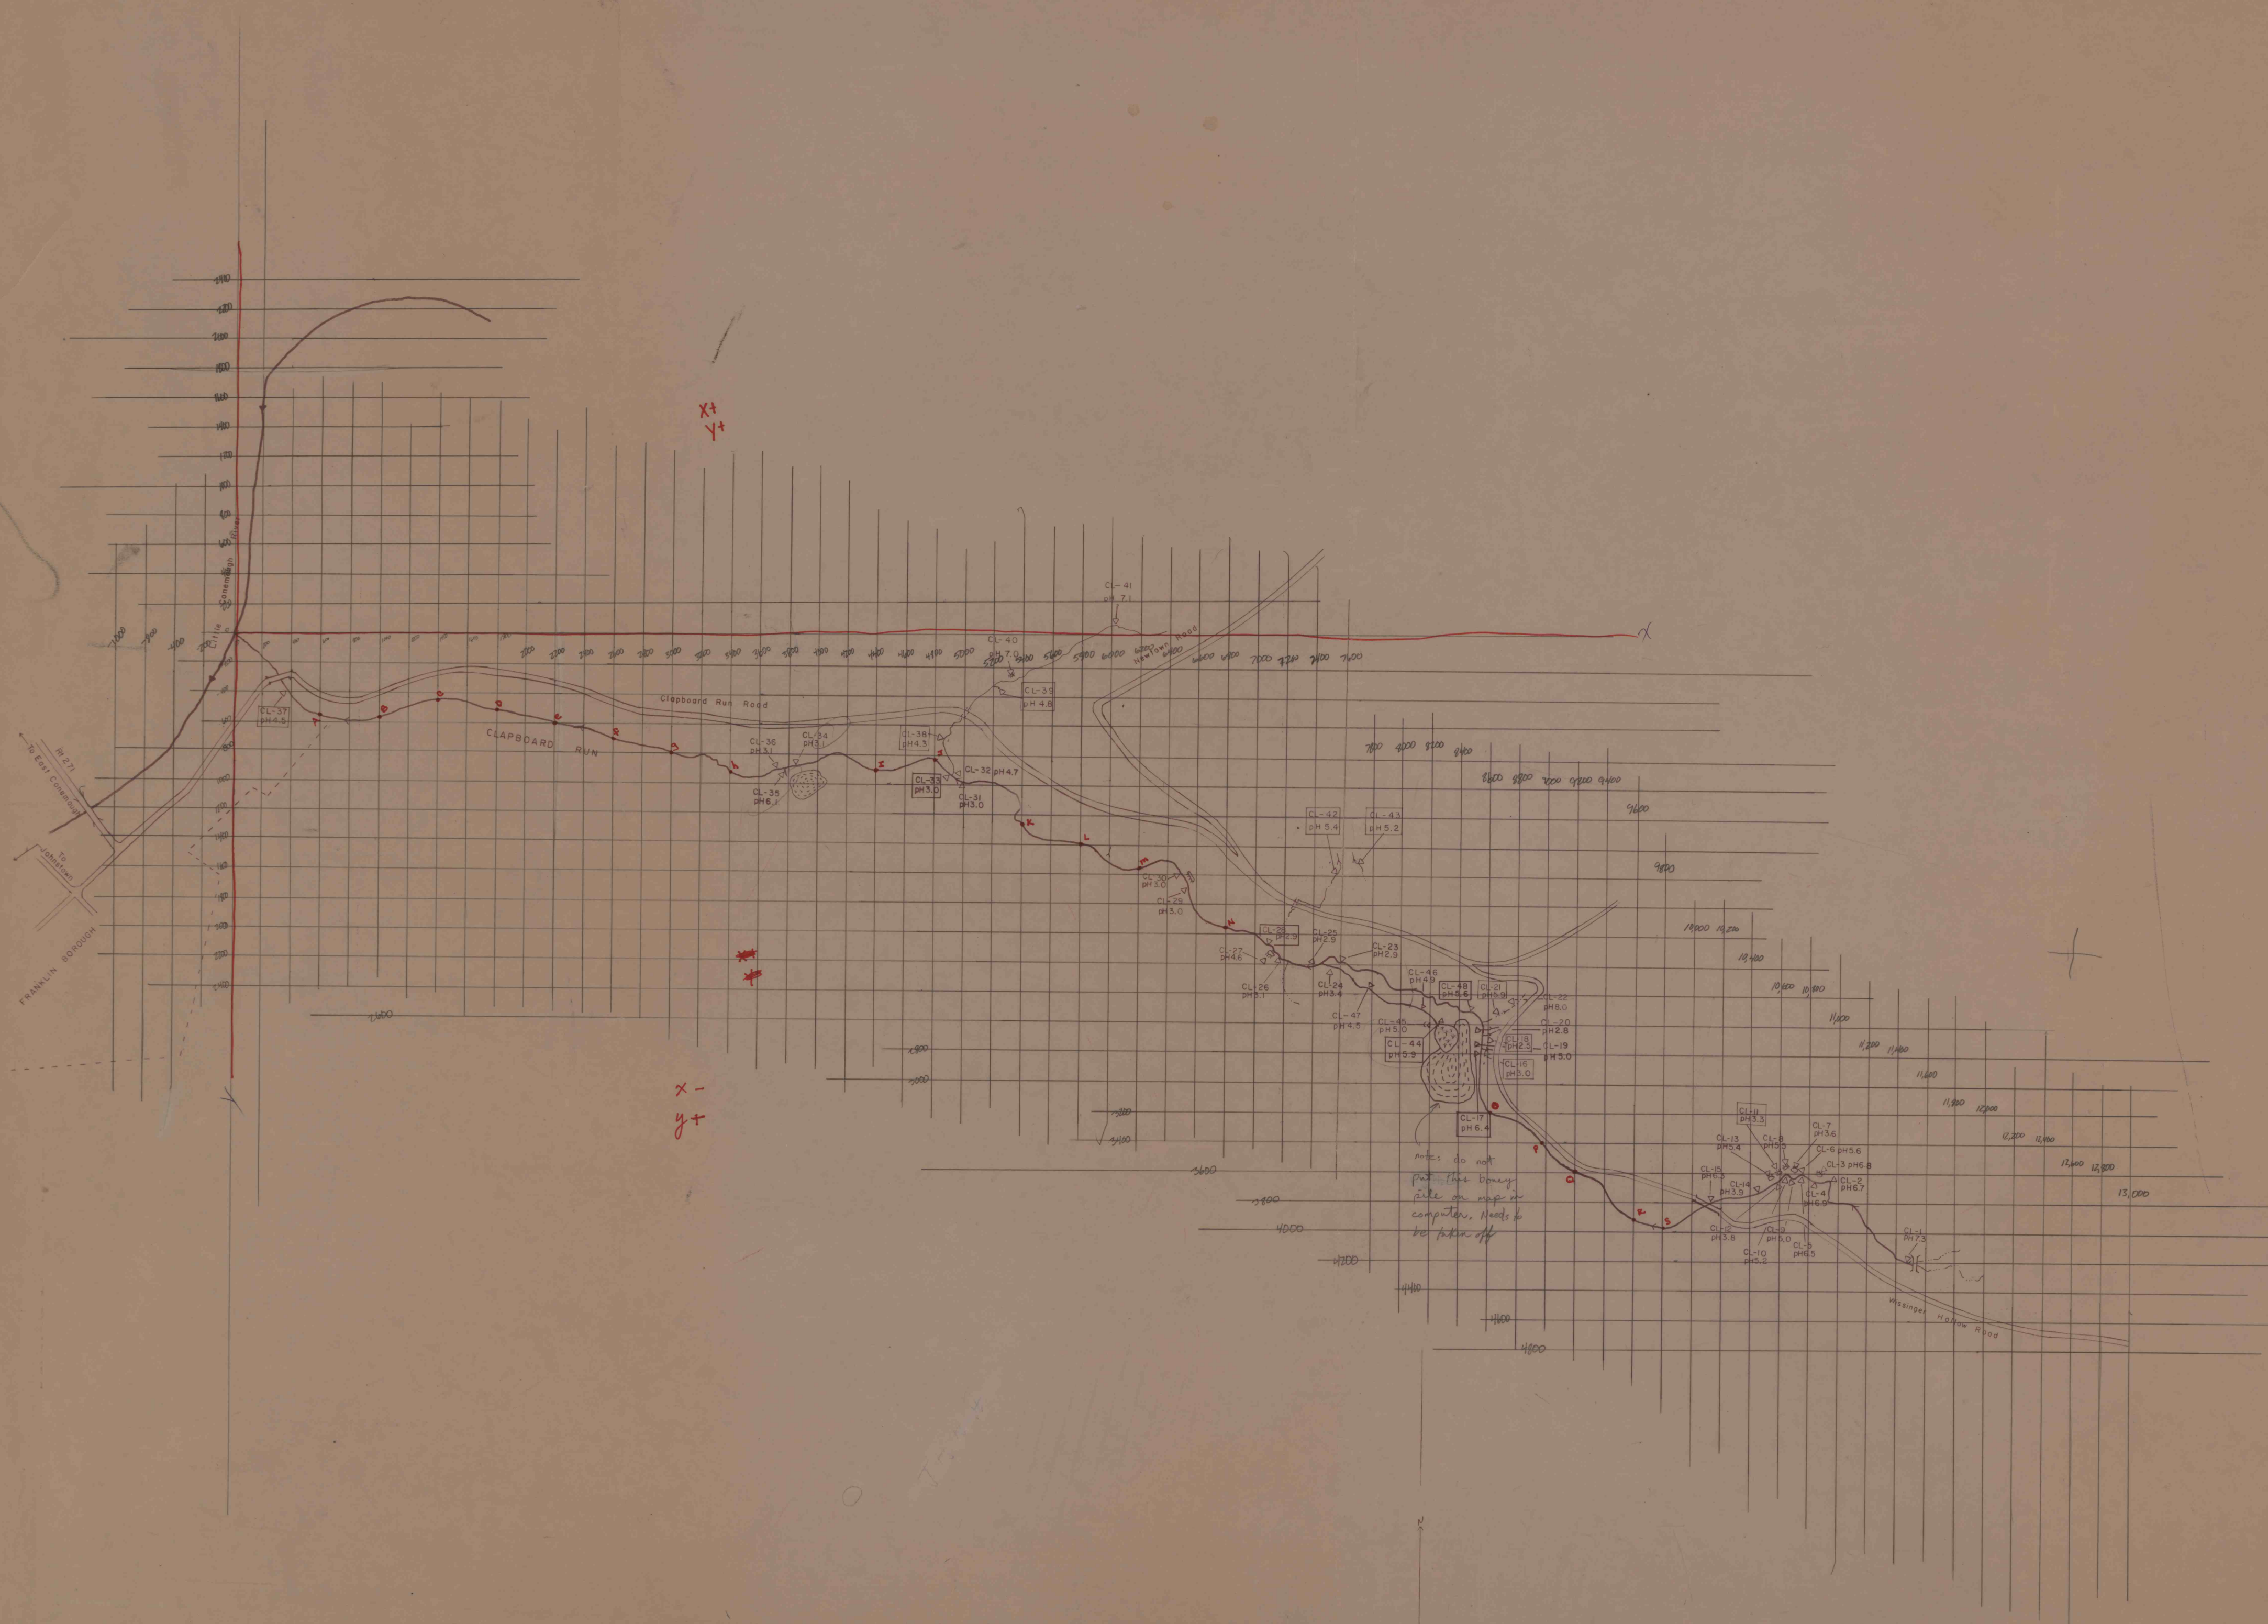

LEGEND
CLAPBOARD RUN

Δ	Sampling Points
CL-Num.	Field Sample Locations
CL-Num.	Lab Sample Locations
	Seeps
	Drifts
	Corrugated Pipe
	Boney Piles
	Bridges
	Intermittent Streams
	Swamp

Scale 1" = 400'

Little Conemaugh River Project
July 1992
Gibson, Pedgornay, Kick, Douglas, Ritko