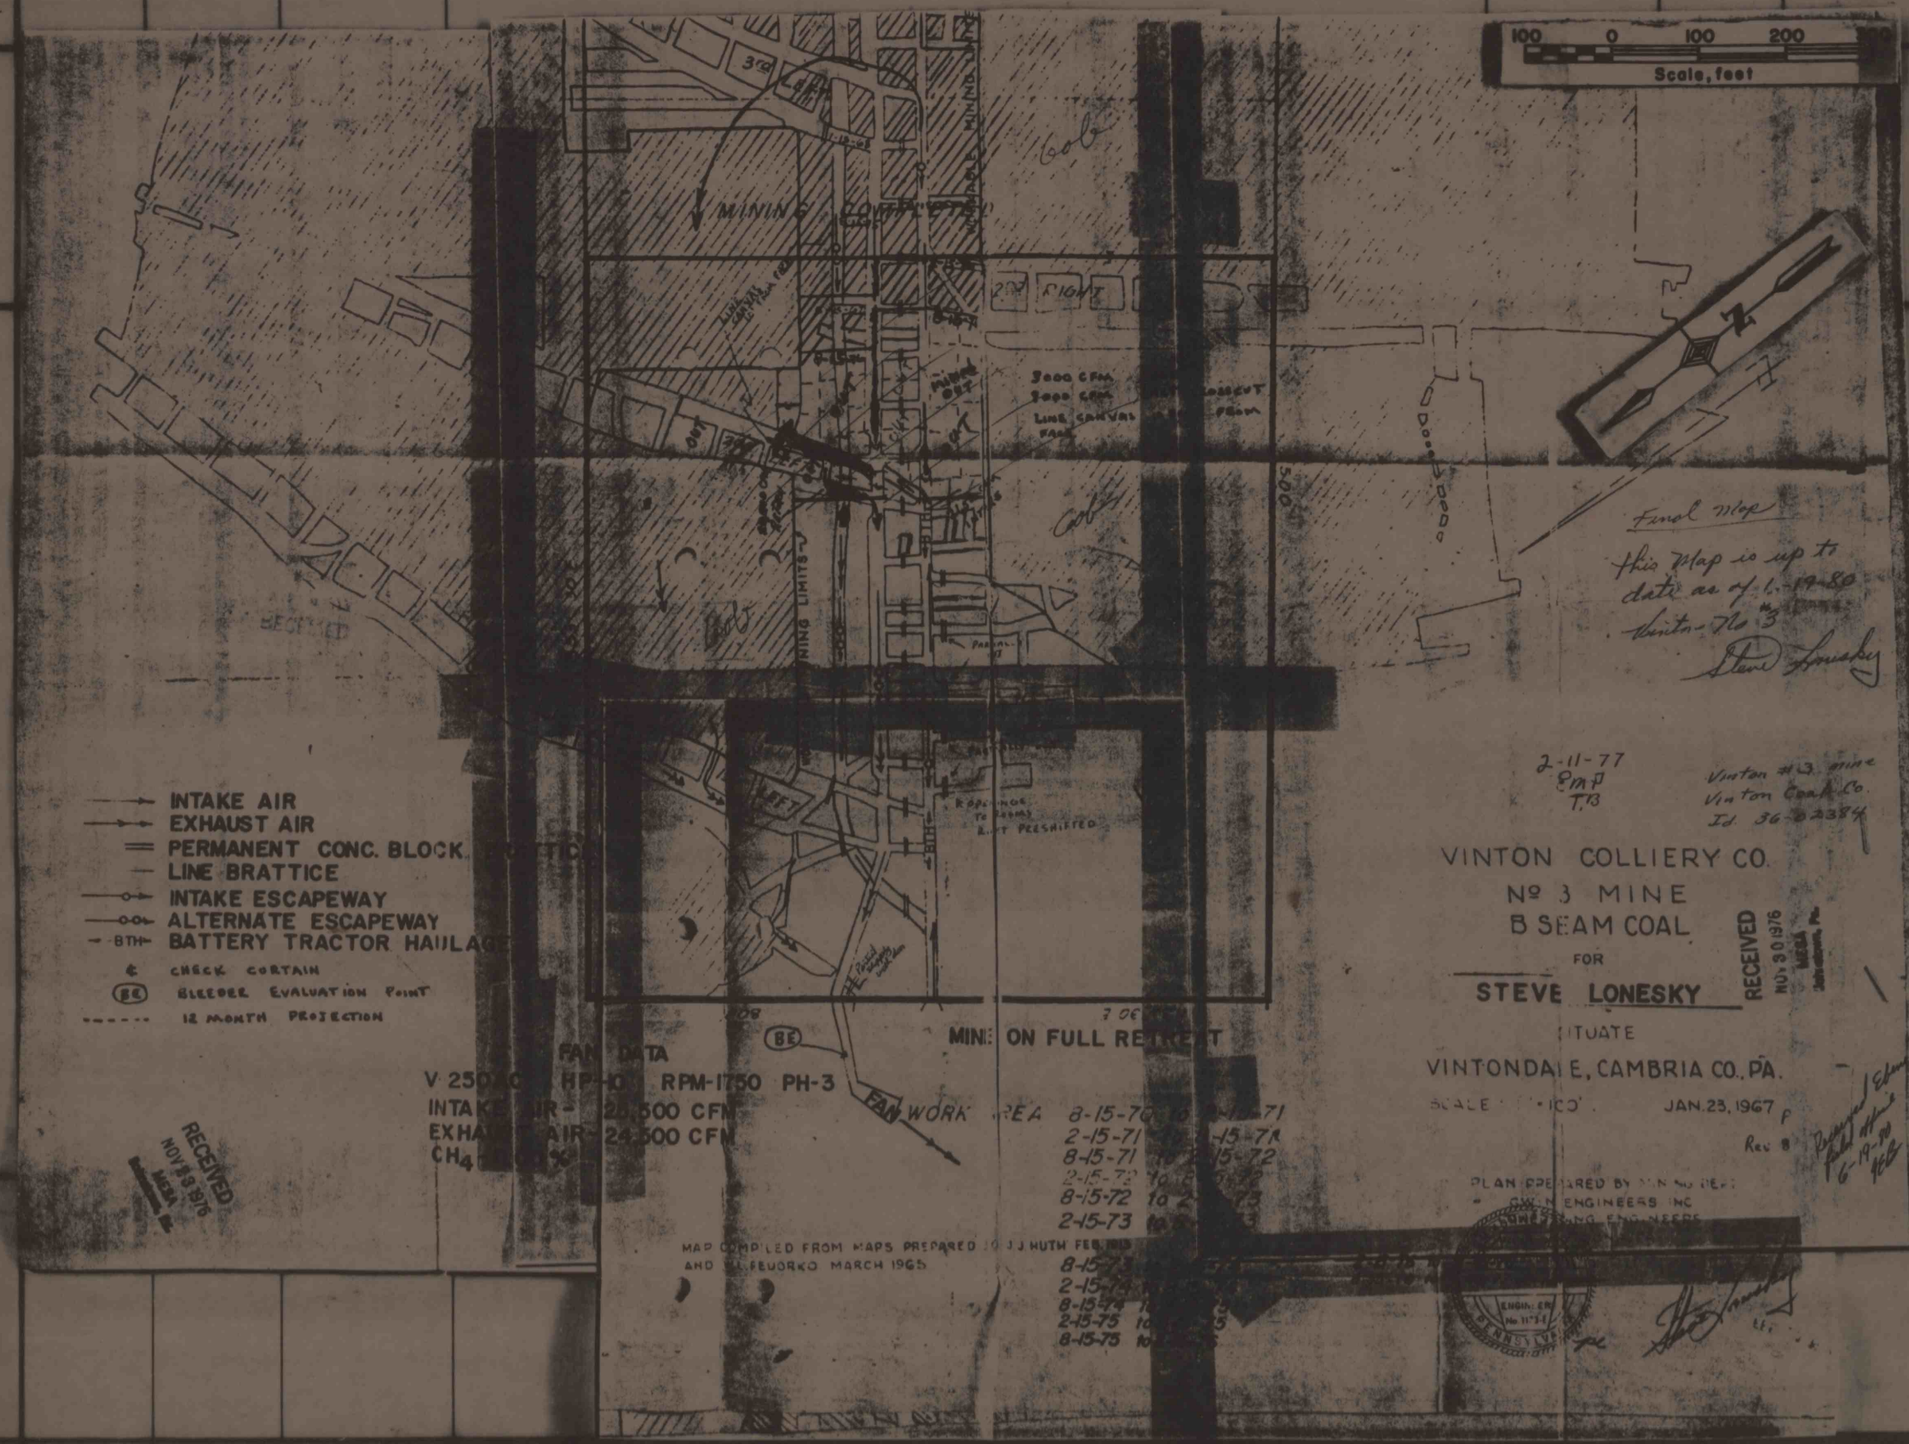

HS 2 03147 54 16X 354761

414