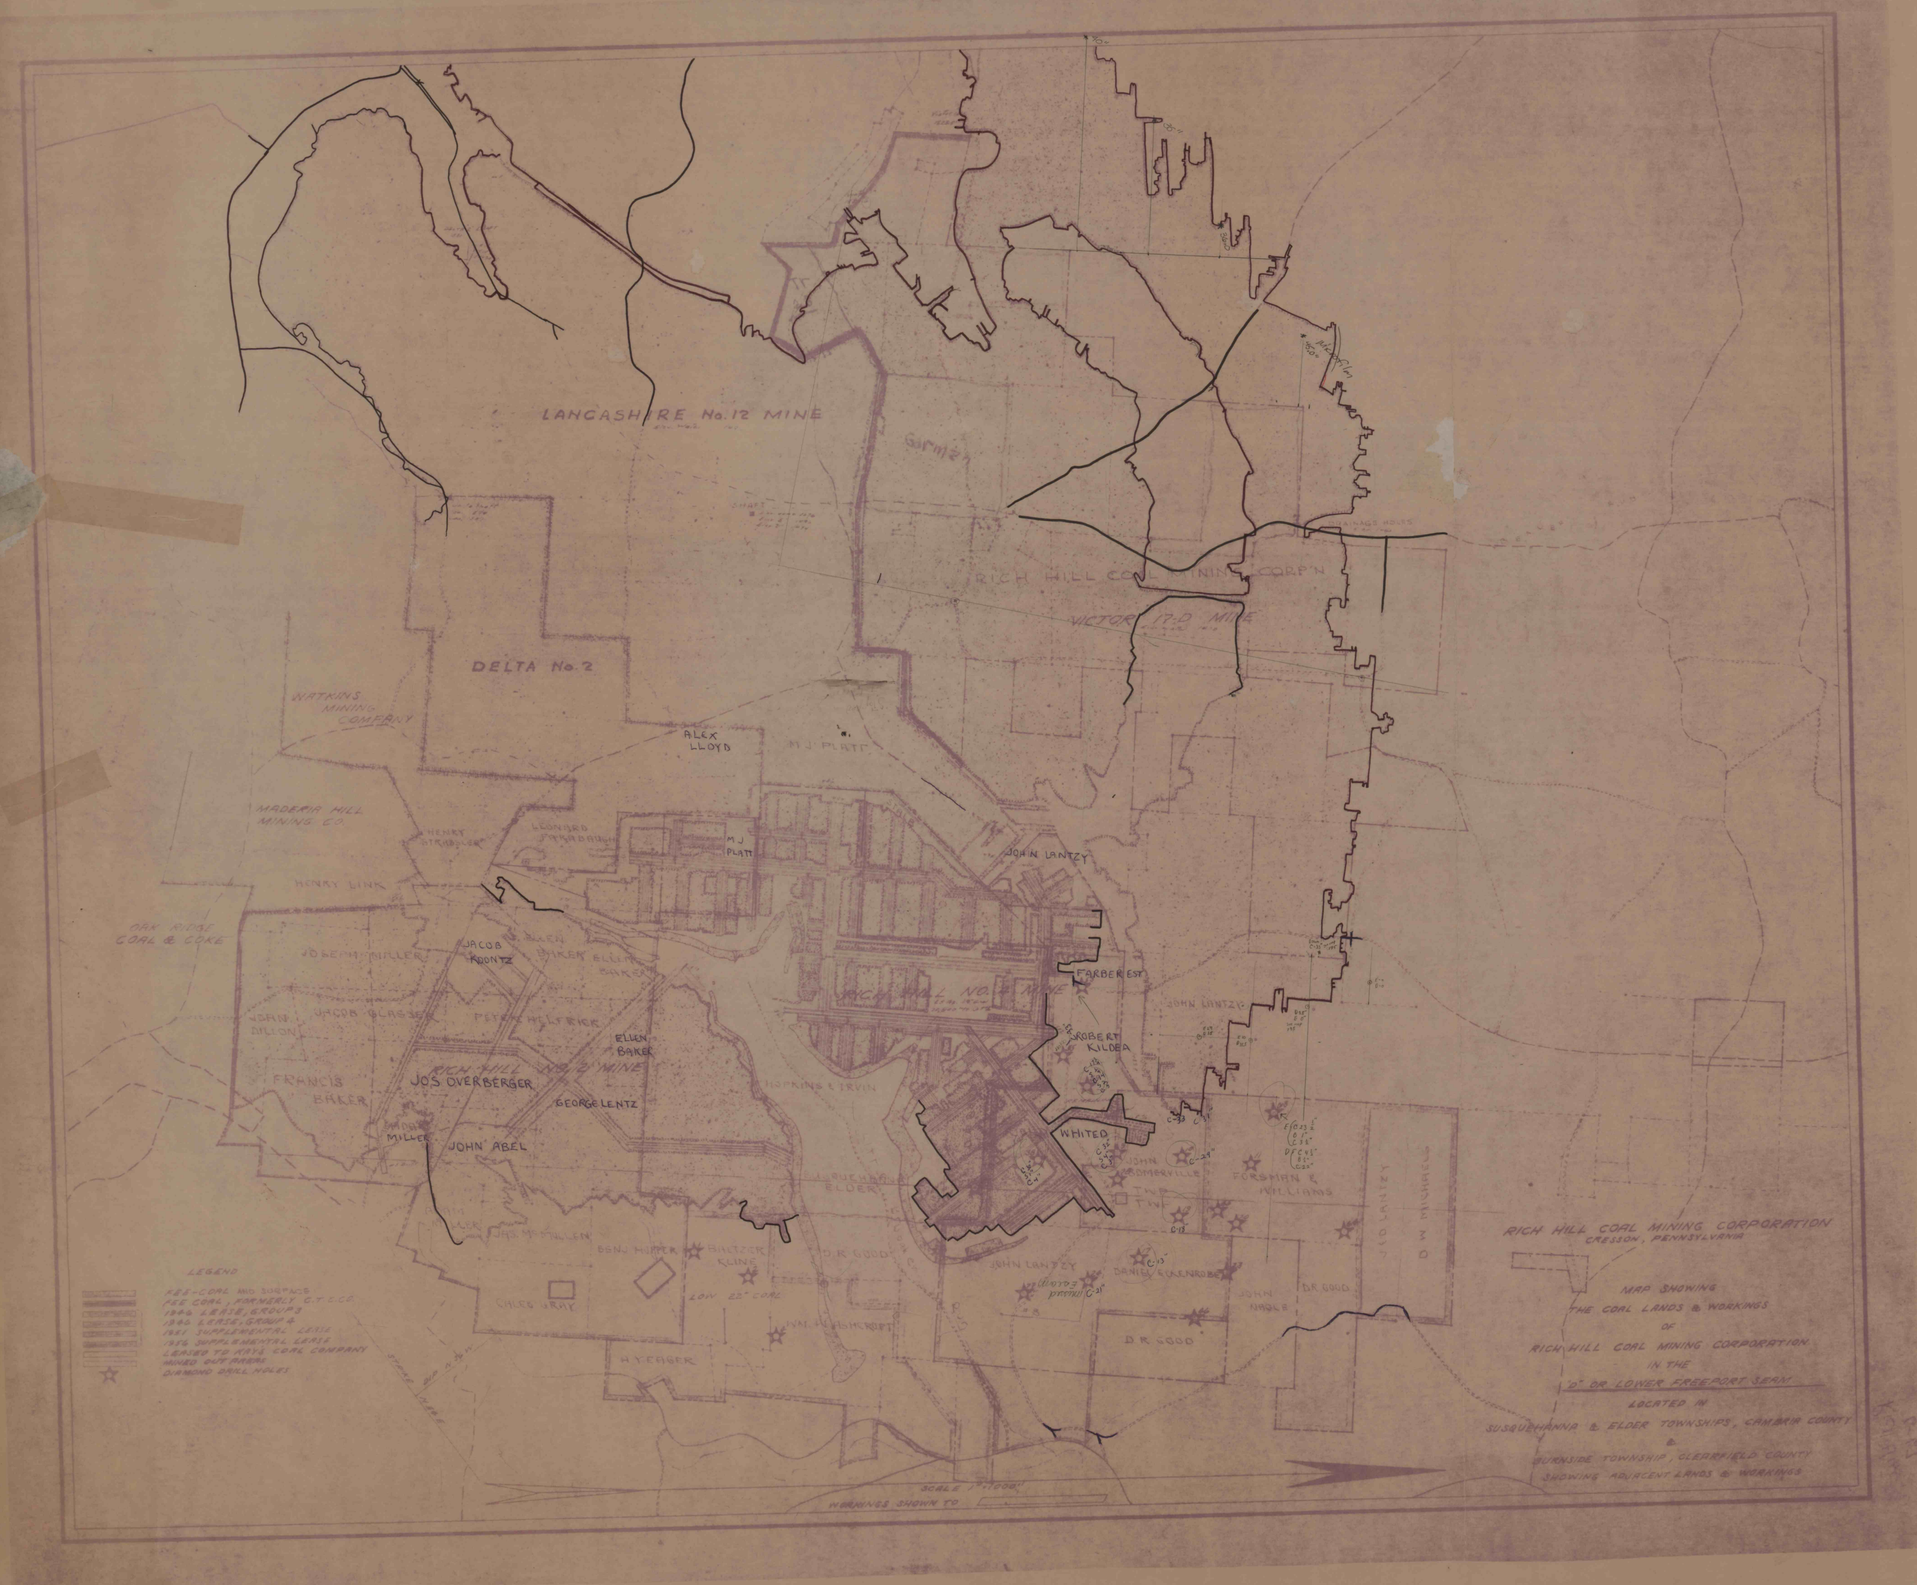
LANCASHIRE No. 12 MINE
RICH HILL COAL MINING CORP'N
VICTOR 17-D MINE
DELTA No. 2
WATKINS MINING COMPANY
ALEX LLOYD
M.J. PLATT
MADERIA HILL MINING CO.
HENRY STRUBLE
LEONARD ARMBRUST
M J PLATT
JOHN LANTZY
HENRY LINK
OAK RIDGE COAL & COKE
JOSEPH MILLER
JACOB KRONTZ
ELLEN BAKER
JACOB GLASS
PETER MILLER
JOHN DILLON
ELLEN BAKER
RICH HILL No. 2 MINE
FRANCIS BAKER
JOS OVERBERGER
GEORGE LENTZ
JOHN ABEL
FARBER EST
ROBERT KILDEA
WHITED
JOHN LANTZY
FORSMAN & WILLIAMS
D. W. MINNILLS
BENJ. HUMER
BALTZER KLINE
CALEB GRAY
H. Y. FARGER
D. R. GOOD
DANIEL EKENROD
LEGEND
PRE-CORL MID SURVEYS
PRE CORL, FORMERLY G.T.L.C.C.
1946 LEASE, GROUP 1
1946 LEASE, GROUP 4
1951 SUPPLEMENTAL LEASE
1956 SUPPLEMENTAL LEASE
LEASED TO RICH COAL COMPANY
MINED OUT PAREN
DIAMOND DRILL HOLES
SCALE 1" = 1000'
WORKINGS SHOWN TO
RICH HILL COAL MINING CORPORATION
CRESSON, PENNSYLVANIA
MAP SHOWING
THE COAL LANDS & WORKINGS
OF
RICH HILL COAL MINING CORPORATION
IN THE
D" OR LOWER FREEPORT SEAM
LOCATED IN
SUSQUEHANNA & ELDER TOWNSHIPS, CAMBRIA COUNTY
&
BURNSIDE TOWNSHIP, CLEARFIELD COUNTY
SHOWING ADJACENT LANDS & WORKINGS