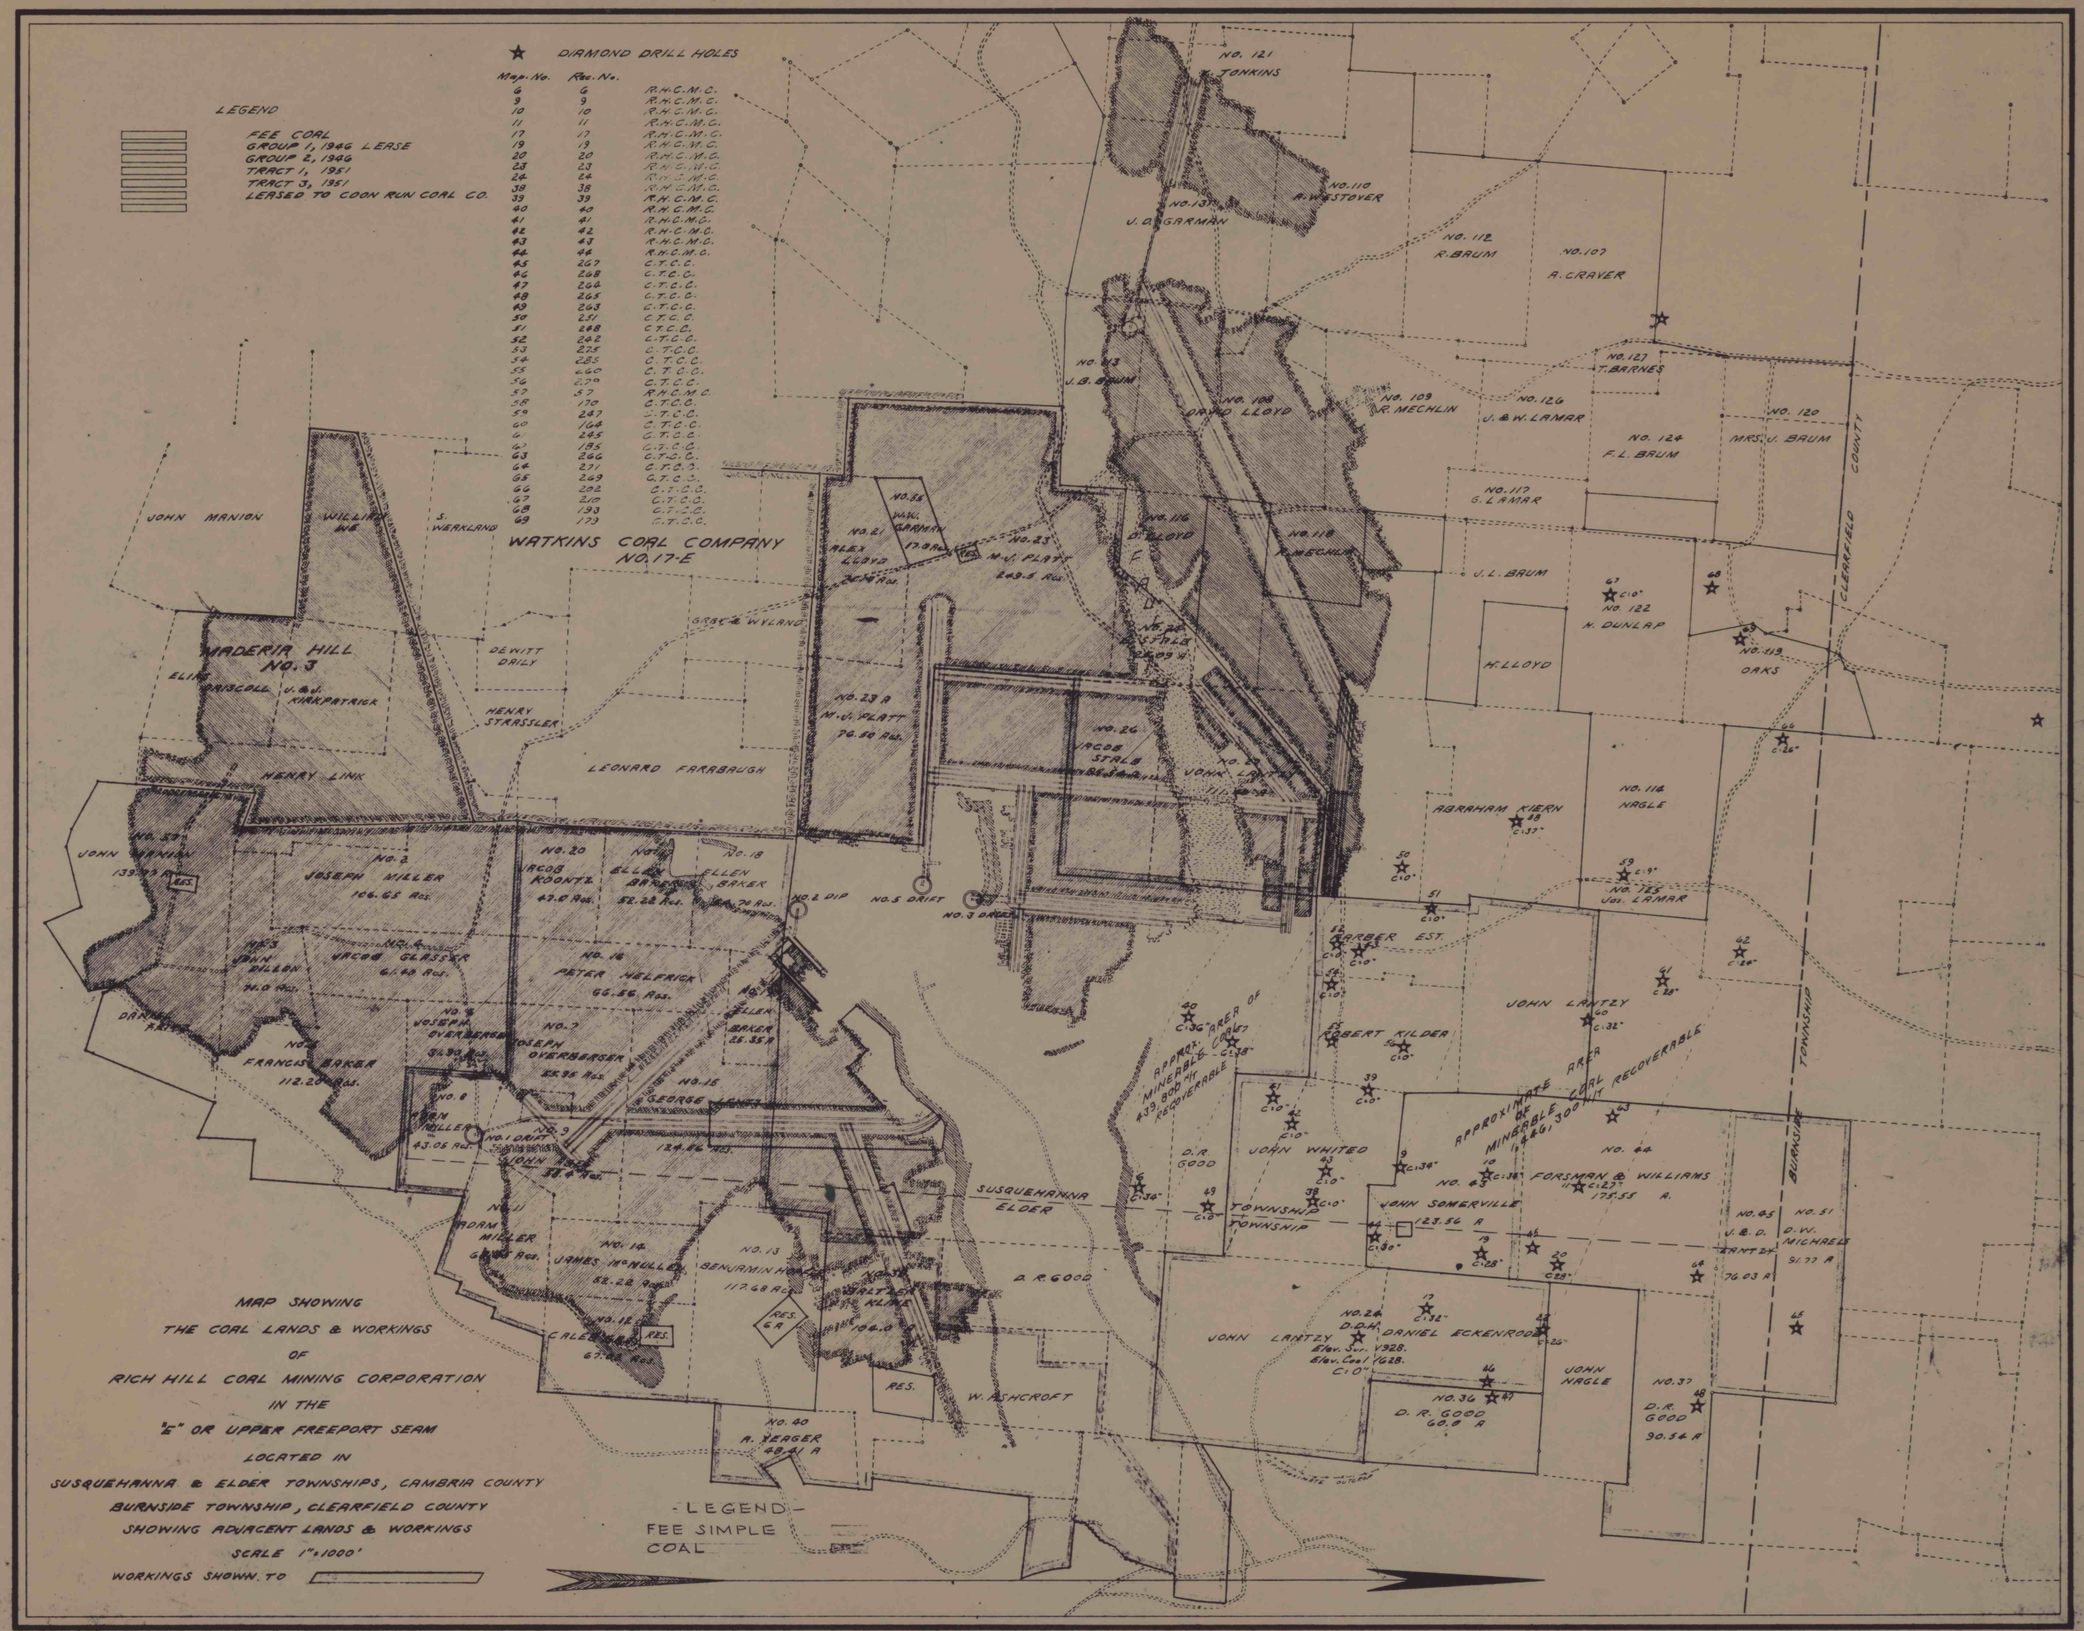
DIAMOND DRILL HOLES
Map. No. Rec. No.
6 6 R.H.C.M.C.
9 9 R.H.C.M.C.
10 10 R.H.C.M.C.
11 11 R.H.C.M.C.
17 17 R.H.C.M.C.
19 19 R.H.C.M.C.
20 20 R.H.C.M.C.
23 23 R.H.C.M.C.
24 24 R.H.C.M.C.
38 38 R.H.C.M.C.
39 39 R.H.C.M.C.
40 40 R.H.C.M.C.
41 41 R.H.C.M.C.
42 42 R.H.C.M.C.
43 43 R.H.C.M.C.
44 44 R.H.C.M.C.
45 267 C.T.C.C.
46 268 C.T.C.C.
47 266 C.T.C.C.
48 265 C.T.C.C.
49 263 C.T.C.C.
50 271 C.T.C.C.
51 268 C.T.C.C.
52 262 C.T.C.C.
53 225 C.T.C.C.
54 285 C.T.C.C.
55 260 C.T.C.C.
56 270 C.T.C.C.
57 57 R.H.C.M.C.
58 170 C.T.C.C.
59 287 C.T.C.C.
60 164 C.T.C.C.
61 245 C.T.C.C.
62 195 C.T.C.C.
63 266 C.T.C.C.
64 271 C.T.C.C.
65 269 C.T.C.C.
66 292 C.T.C.C.
67 270 C.T.C.C.
68 193 C.T.C.C.
69 179 C.T.C.C.
LEGEND
FEE COAL
GROUP 1, 1946 LEASE
GROUP 2, 1946
TRACT 1, 1951
TRACT 3, 1951
LEASED TO COON RUN COAL CO.
WATKINS COAL COMPANY
NO. 17-E
MADERIA HILL
NO. 3
JOHN MANION
WILLIAM
S. WERKLAND
DEWITT DRILY
HENRY STRASSLER
LEONARD FARRABAUGH
HENRY LINK
JOSEPH MILLER
106.65 Acs.
JACOB KOONTZ
43.6 Acs.
ELLEN BAKER
52.22 Acs.
PETER HELFRICK
66.56 Acs.
JOSEPH OVERBAUGH
FRANCIS BAKER
112.20 Acs.
GEORGE
JAMES McNULLEN
52.28 Acs.
BENJAMIN
117.68 Acs.
A. BERGER
48.41 A.
W. ASHCROFT
SUSQUEHANNA
ELDER
D. R. GOOD
TOWNSHIP
JOHN WHITED
JOHN SOMERVILLE
123.56 A.
FORSMAN & WILLIAMS
175.55 A.
JOHN LANTZY
ROBERT KILDER
DANIEL ECKENRODE
JOHN NAGLE
D. R. GOOD
60.0 A.
D. R. GOOD
90.54 A.
D. W. MICHAELS
91.77 A.
ABRAHAM KIERN
NAGLE
N. DUNLAP
H. LLOYD
J. L. BRUM
G. LAMAR
F. L. BRUM
MRS. J. BRUM
J. & W. LAMAR
T. BARNES
R. CRAVER
R. BRUM
R. MECHLIN
DAVID LLOYD
U. G. GARMAN
A. WESTOVER
TONKINS
ORAKS
CLEARFIELD COUNTY
BURNSIDE TOWNSHIP
APPROXIMATE AREA OF MINABLE COAL RECOVERABLE
MAP SHOWING
THE COAL LANDS & WORKINGS
OF
RICH HILL COAL MINING CORPORATION
IN THE
"E" OR UPPER FREEPORT SEAM
LOCATED IN
SUSQUEHANNA & ELDER TOWNSHIPS, CAMBRIA COUNTY
BURNSIDE TOWNSHIP, CLEARFIELD COUNTY
SHOWING ADJACENT LANDS & WORKINGS
SCALE 1" = 1000'
WORKINGS SHOWN TO
LEGEND
FEE SIMPLE
COAL