


LEGEND
 FEE COAL
 LEASED COAL
 MINED
 OUTLINE, MINERABLE COAL

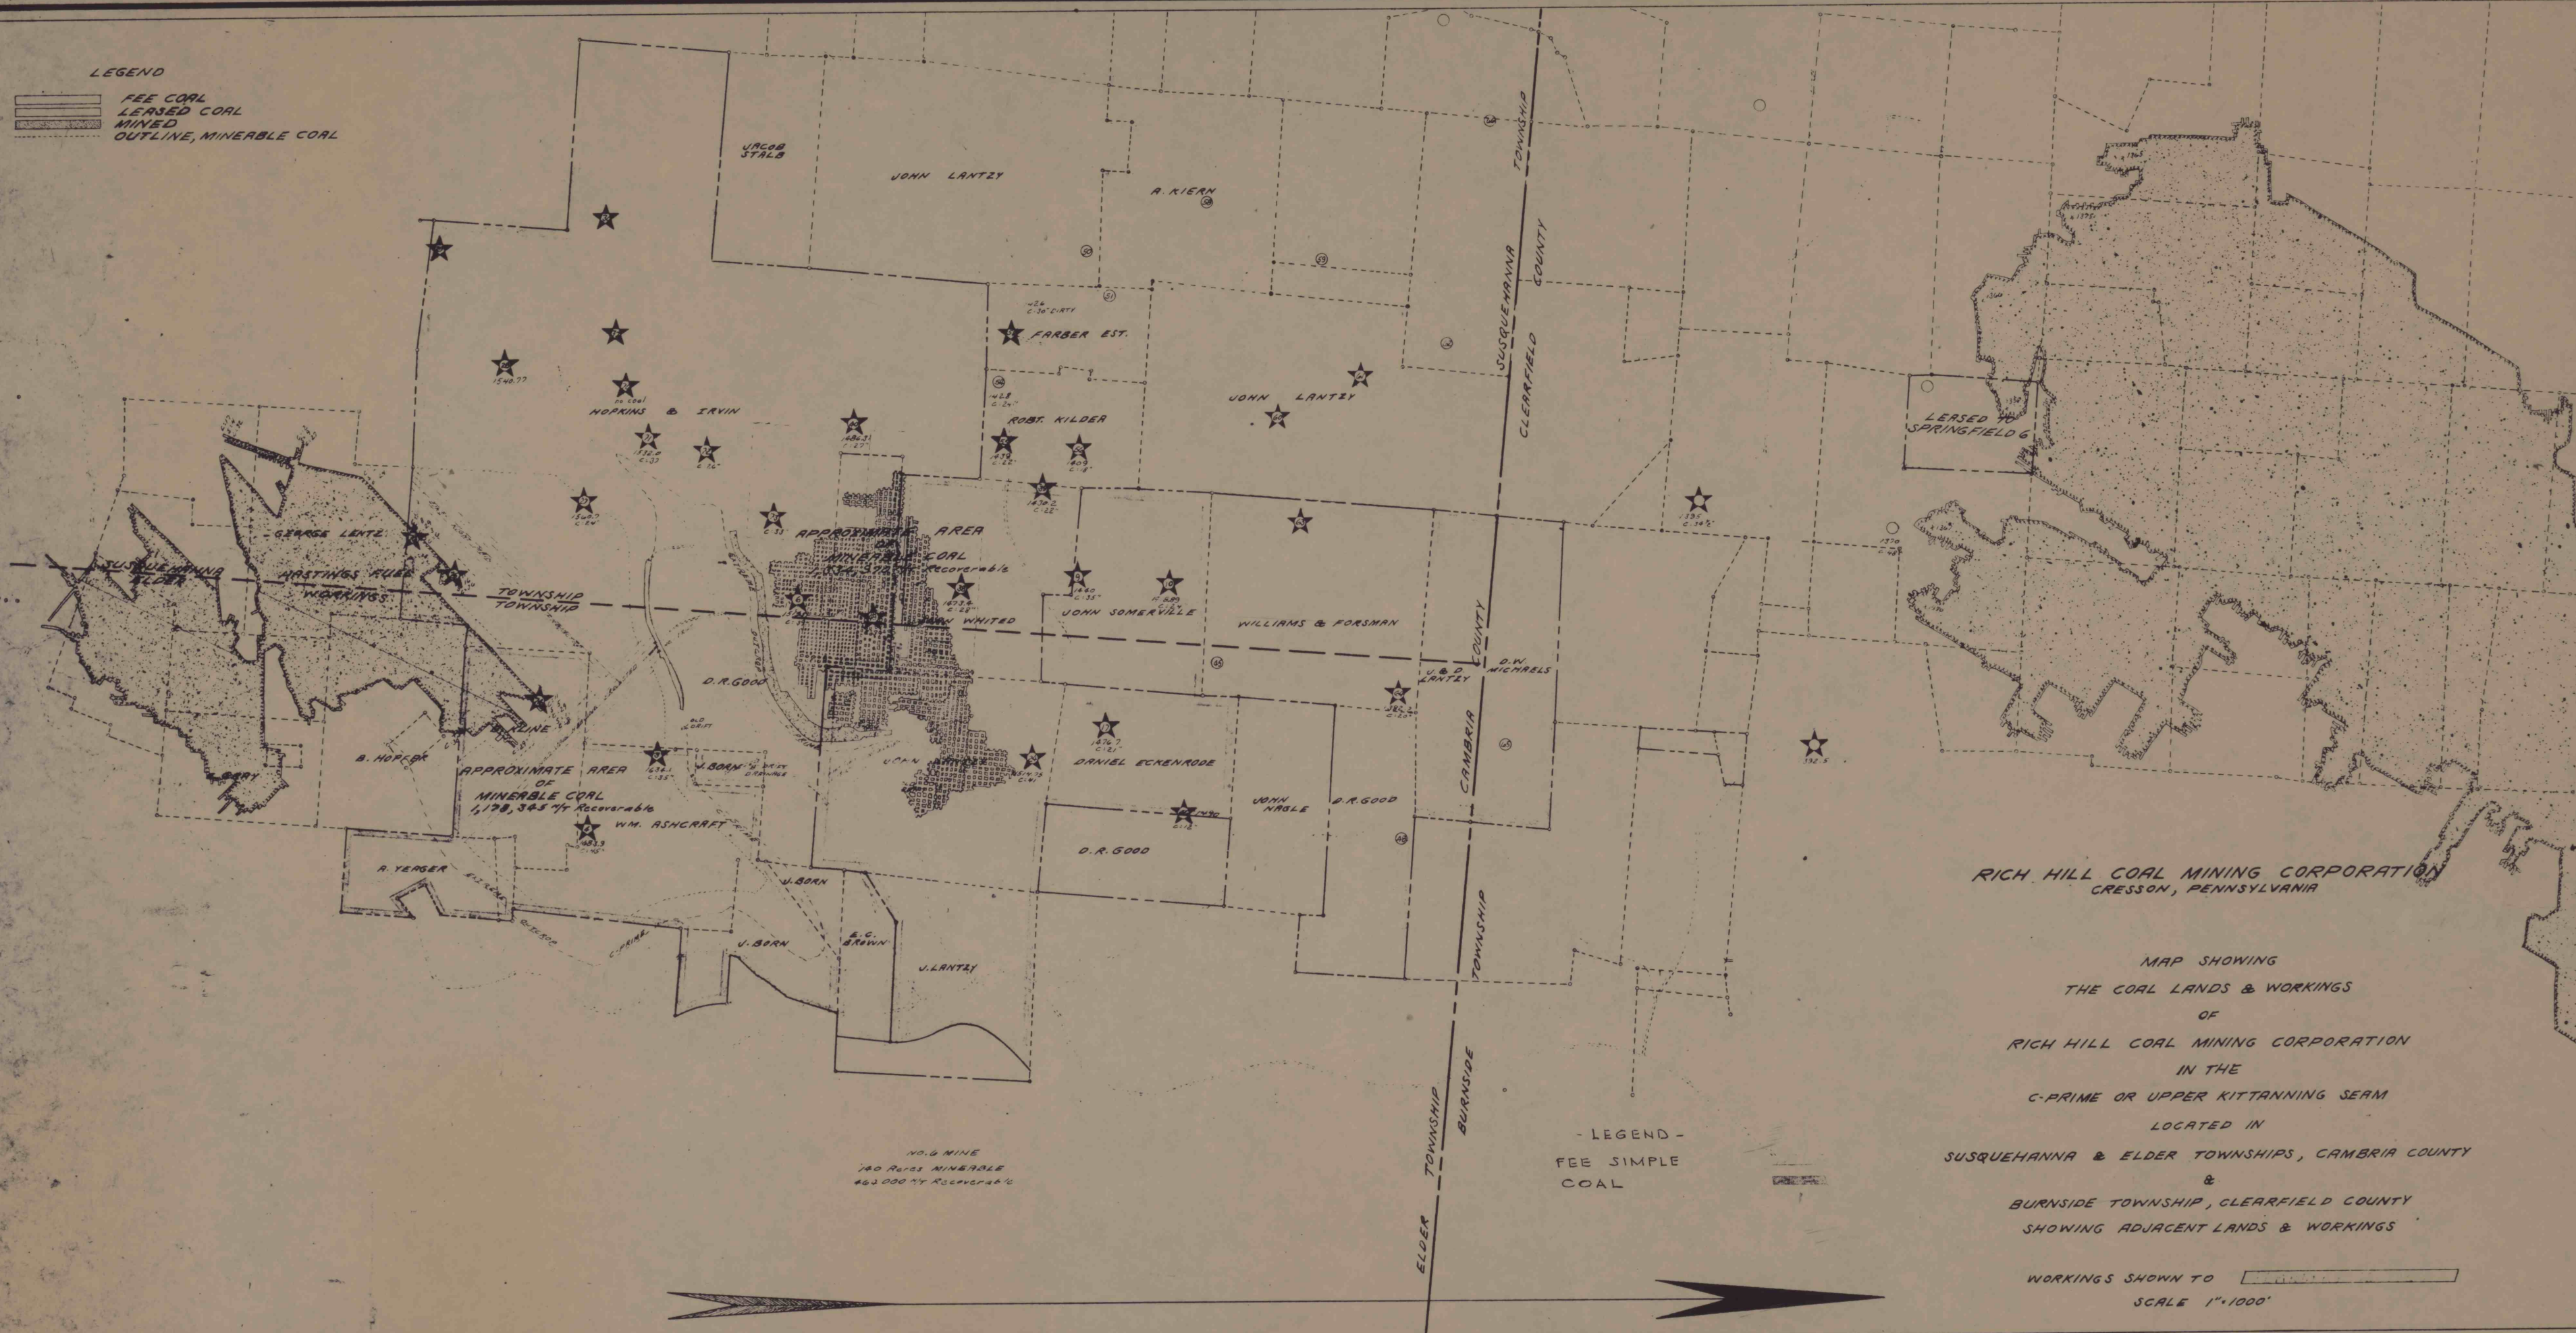

RICH HILL COAL MINING CORPORATION
 CRESSON, PENNSYLVANIA

MAP SHOWING
 THE COAL LANDS & WORKINGS
 OF
 RICH HILL COAL MINING CORPORATION
 IN THE
 C-PRIME OR UPPER KITTANNING SEAM
 LOCATED IN
 SUSQUEHANNA & ELDER TOWNSHIPS, CAMBRIA COUNTY
 &
 BURNSIDE TOWNSHIP, CLEARFIELD COUNTY
 SHOWING ADJACENT LANDS & WORKINGS

WORKINGS SHOWN TO
 SCALE 1"=1000'