


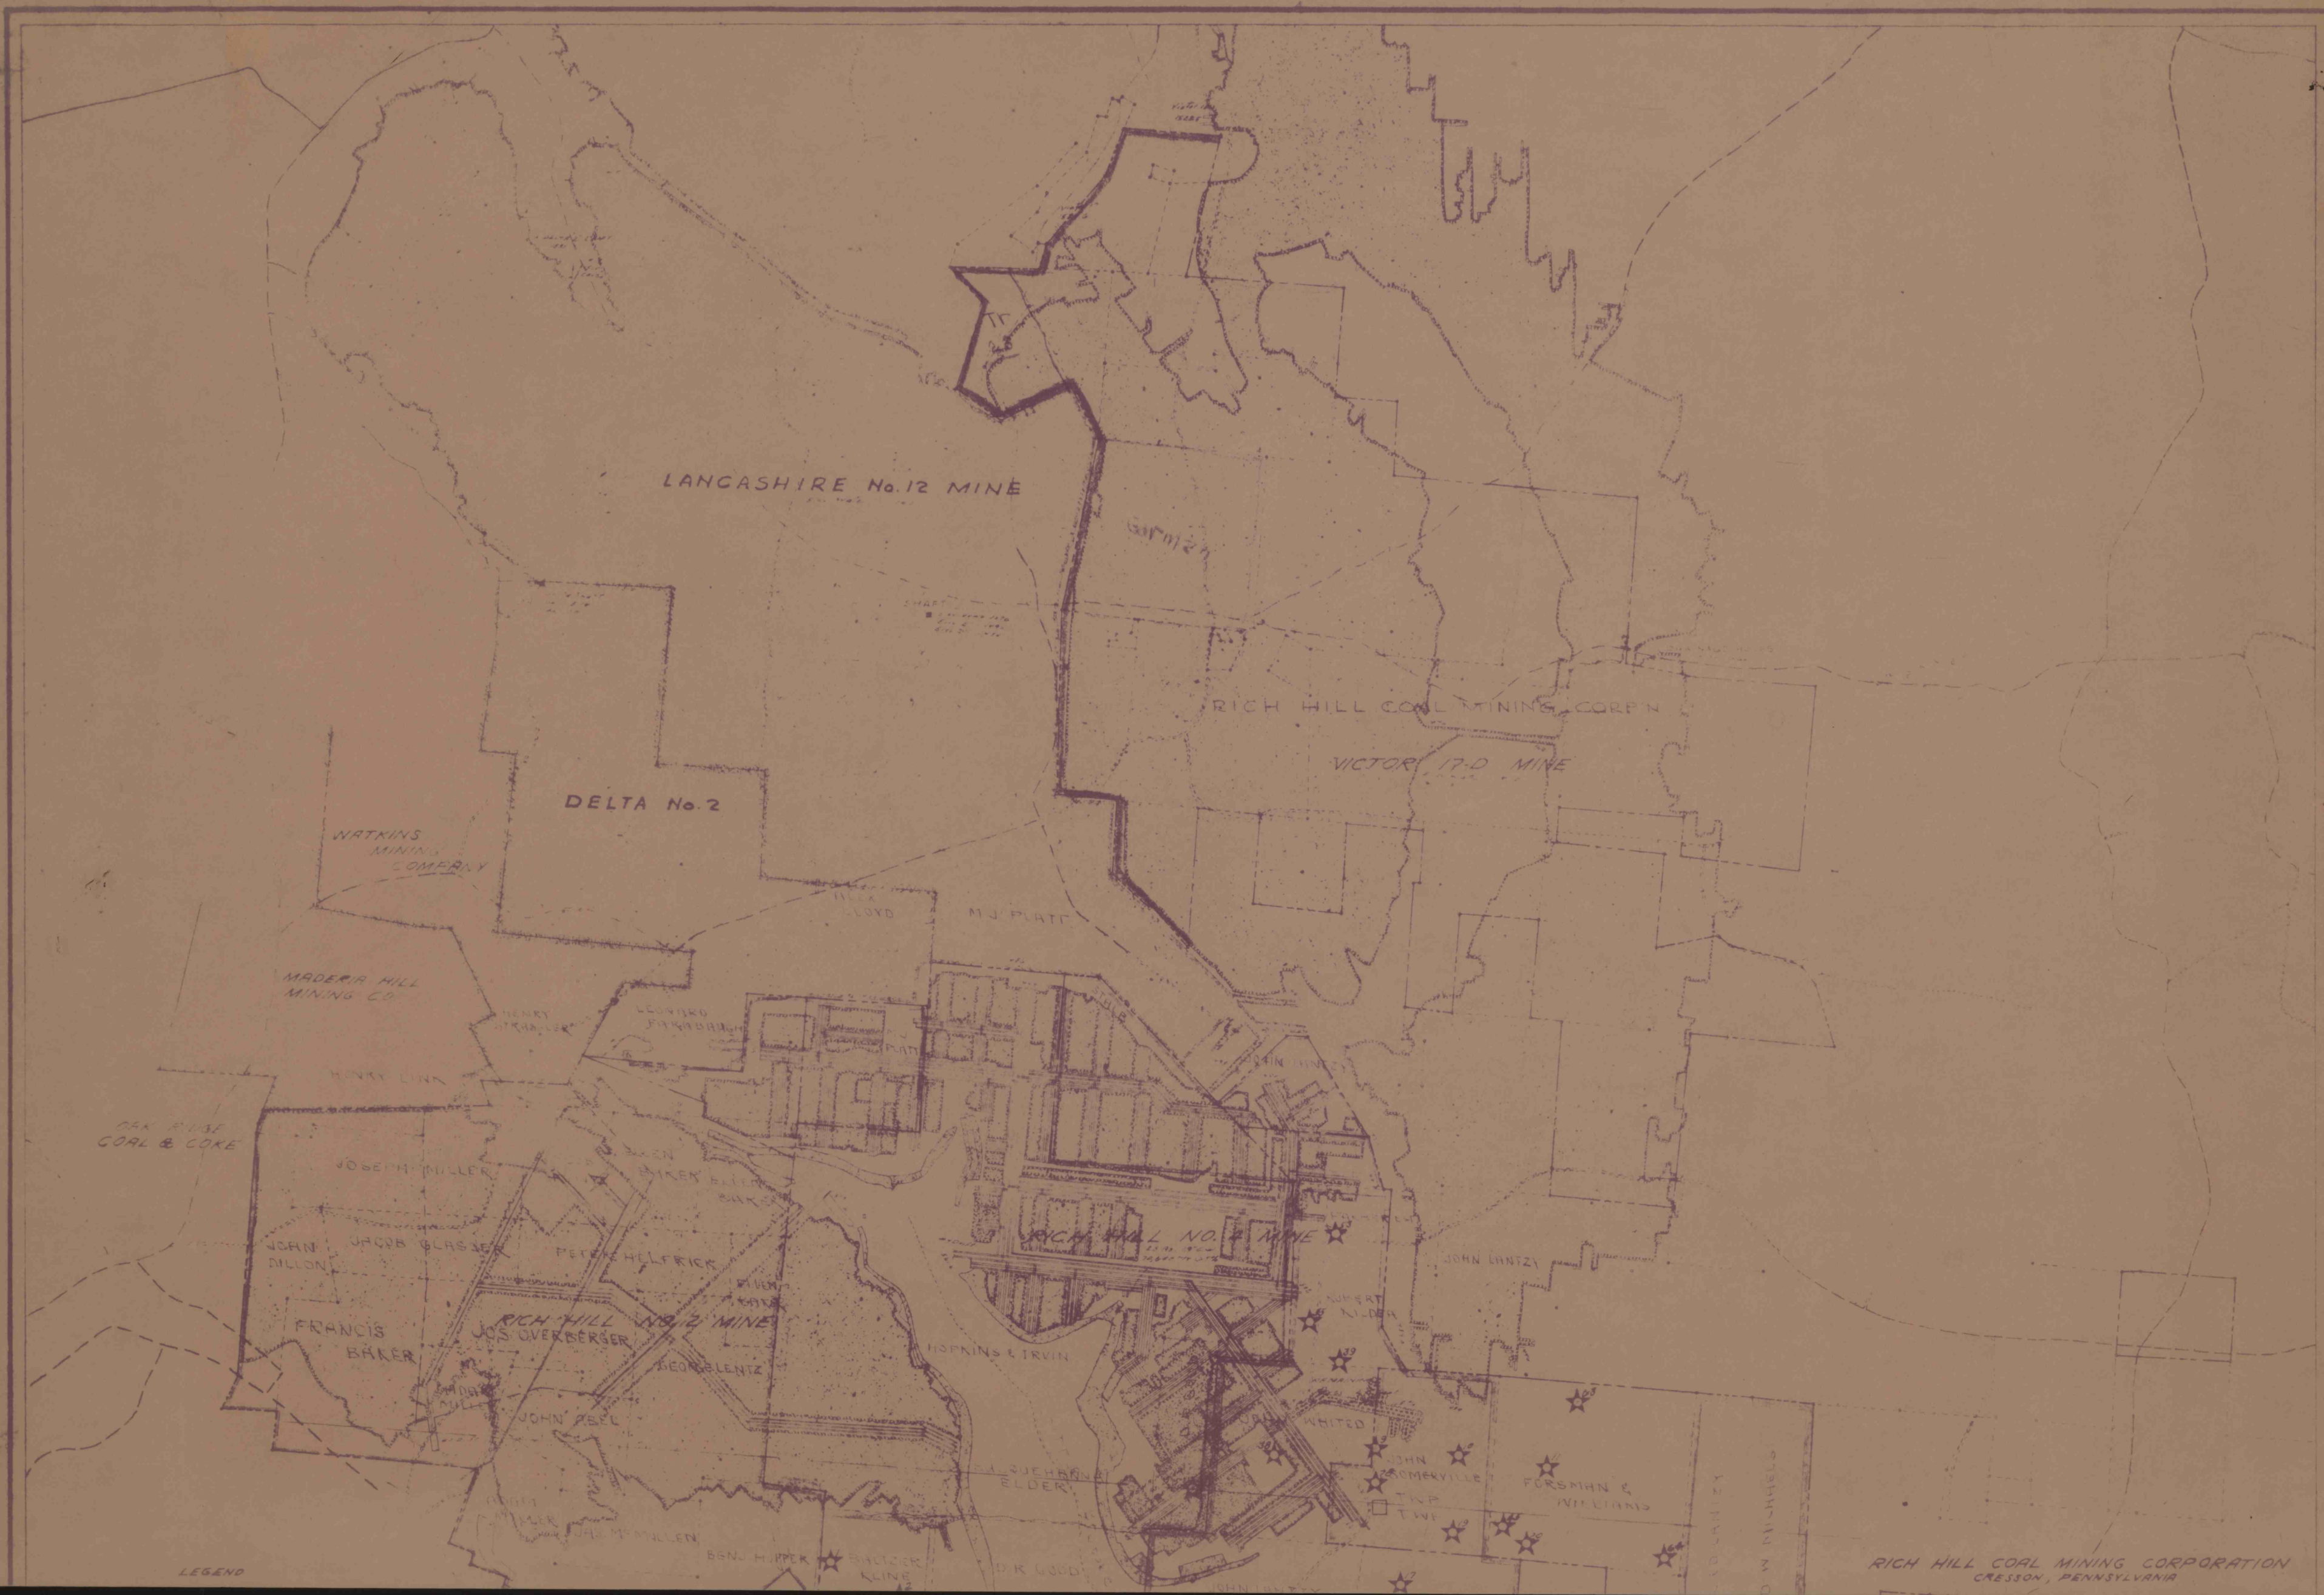

LEGEND

RICH HILL COAL MINING CORPORATION
CRESSON, PENNSYLVANIA