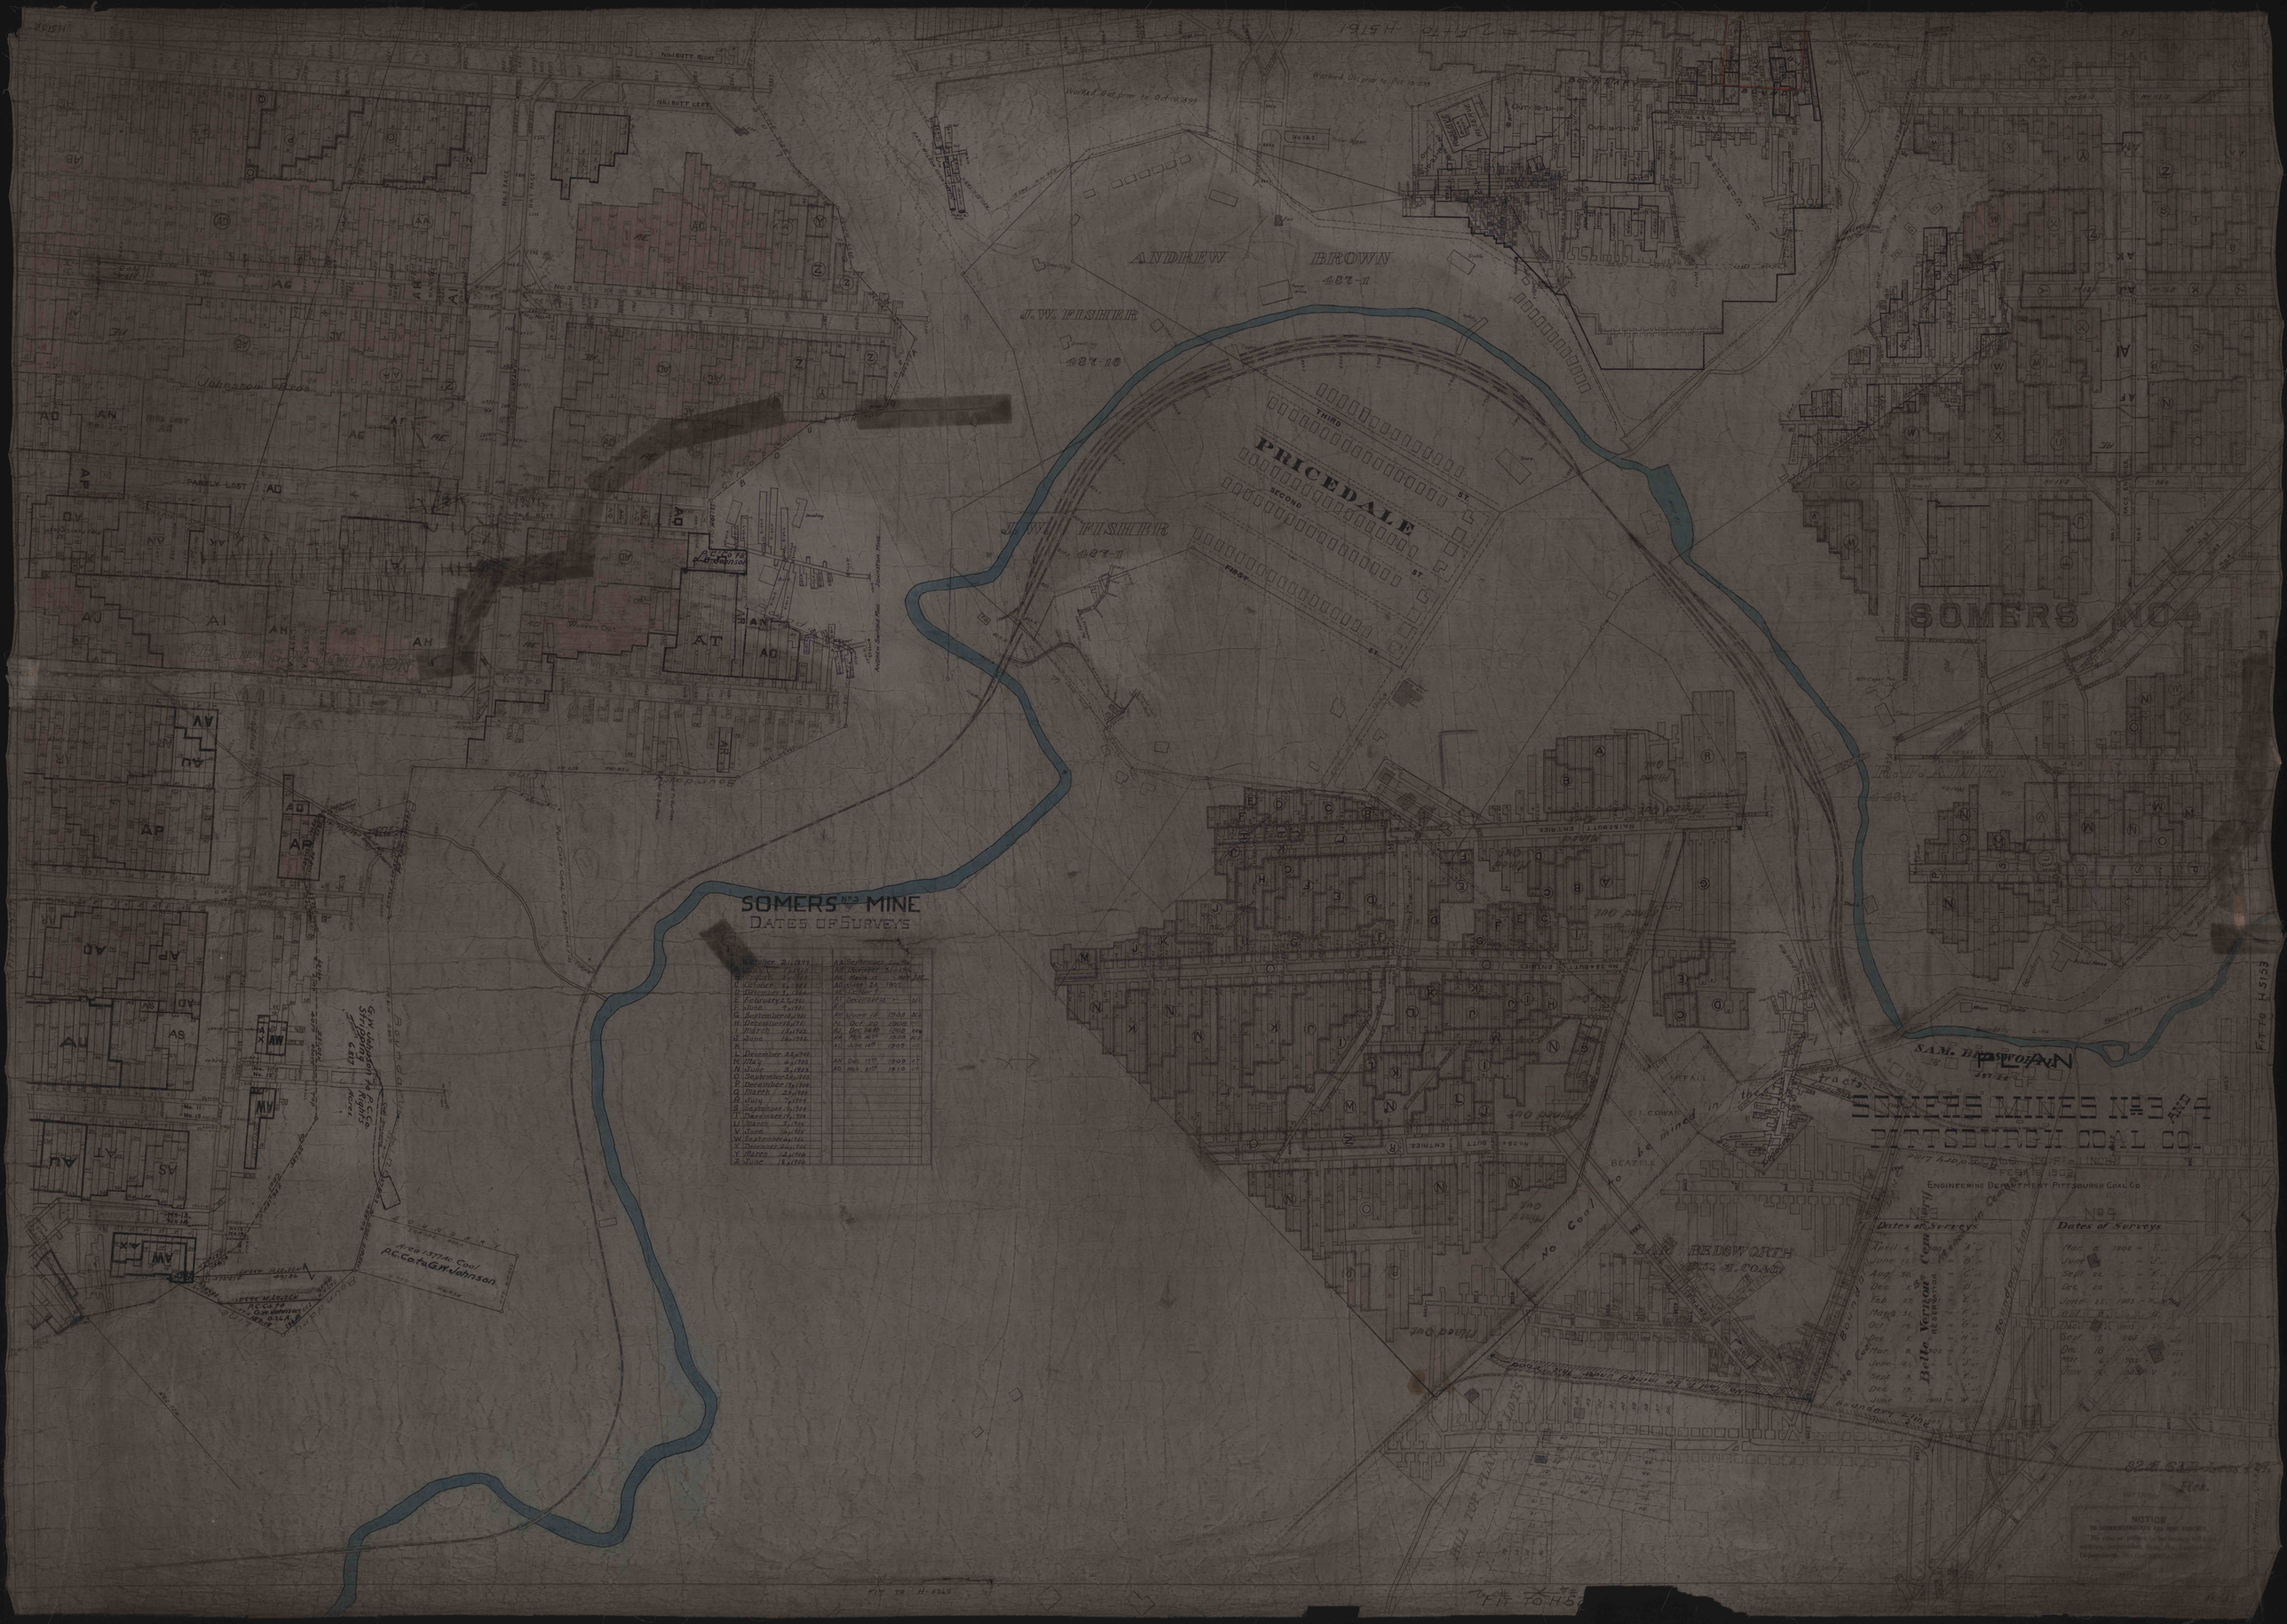
SOMERS No. 3 MINE
DATES OF SURVEYS
ANDREW BROWN
J. W. FISHER
PRICEDALE
THIRD ST.
SECOND ST.
FIRST ST.
SOMERS No. 4
SOMERS MINES No. 3 & 4
PITTSBURGH COAL CO.
ENGINEERING DEPARTMENT PITTSBURGH COAL CO.
Dates of Surveys
Belle Vernon Coke Ovens
SAM REDSWORTH
S. J. COWAN
BEAZELL
Johnston Bros.
Area 1377 A. Coal
P.C.Co. & G.M. Johnson
Fit to H-5243