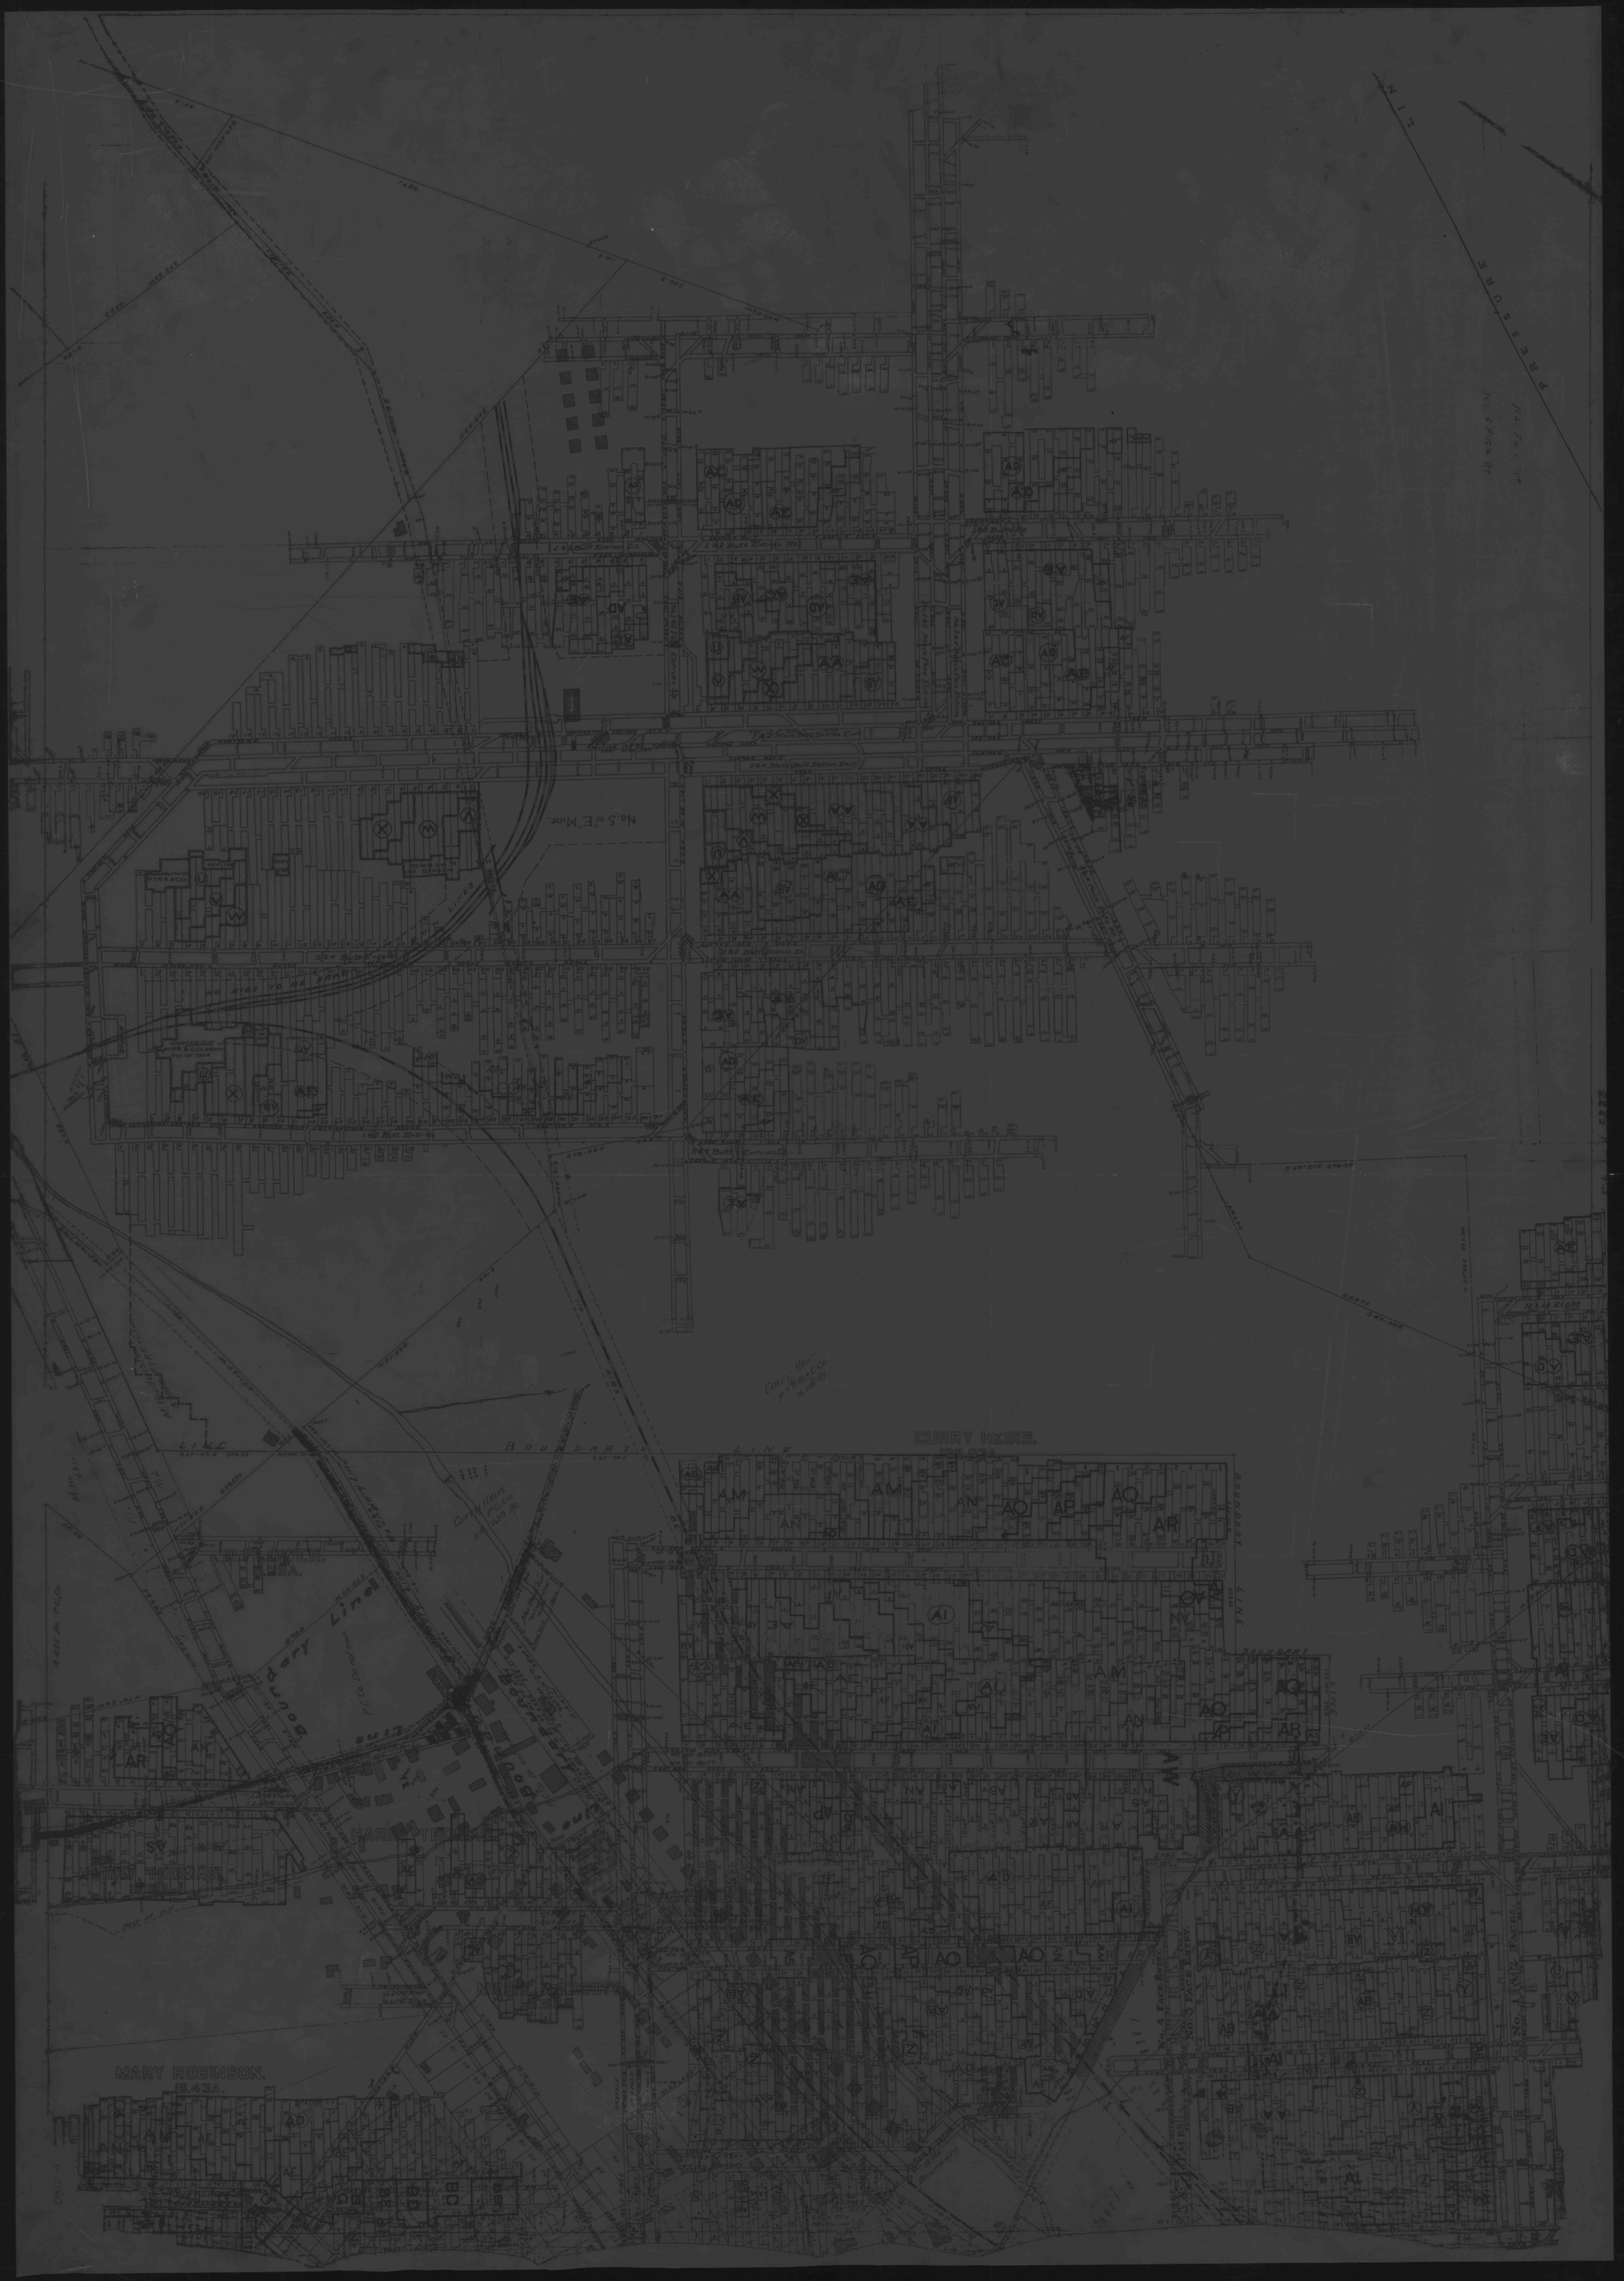
CURRY HEIRS.
MARY ROBINSON.
No. 5 or E Mine
Boundary Line
Boundary Line
Boundary Line