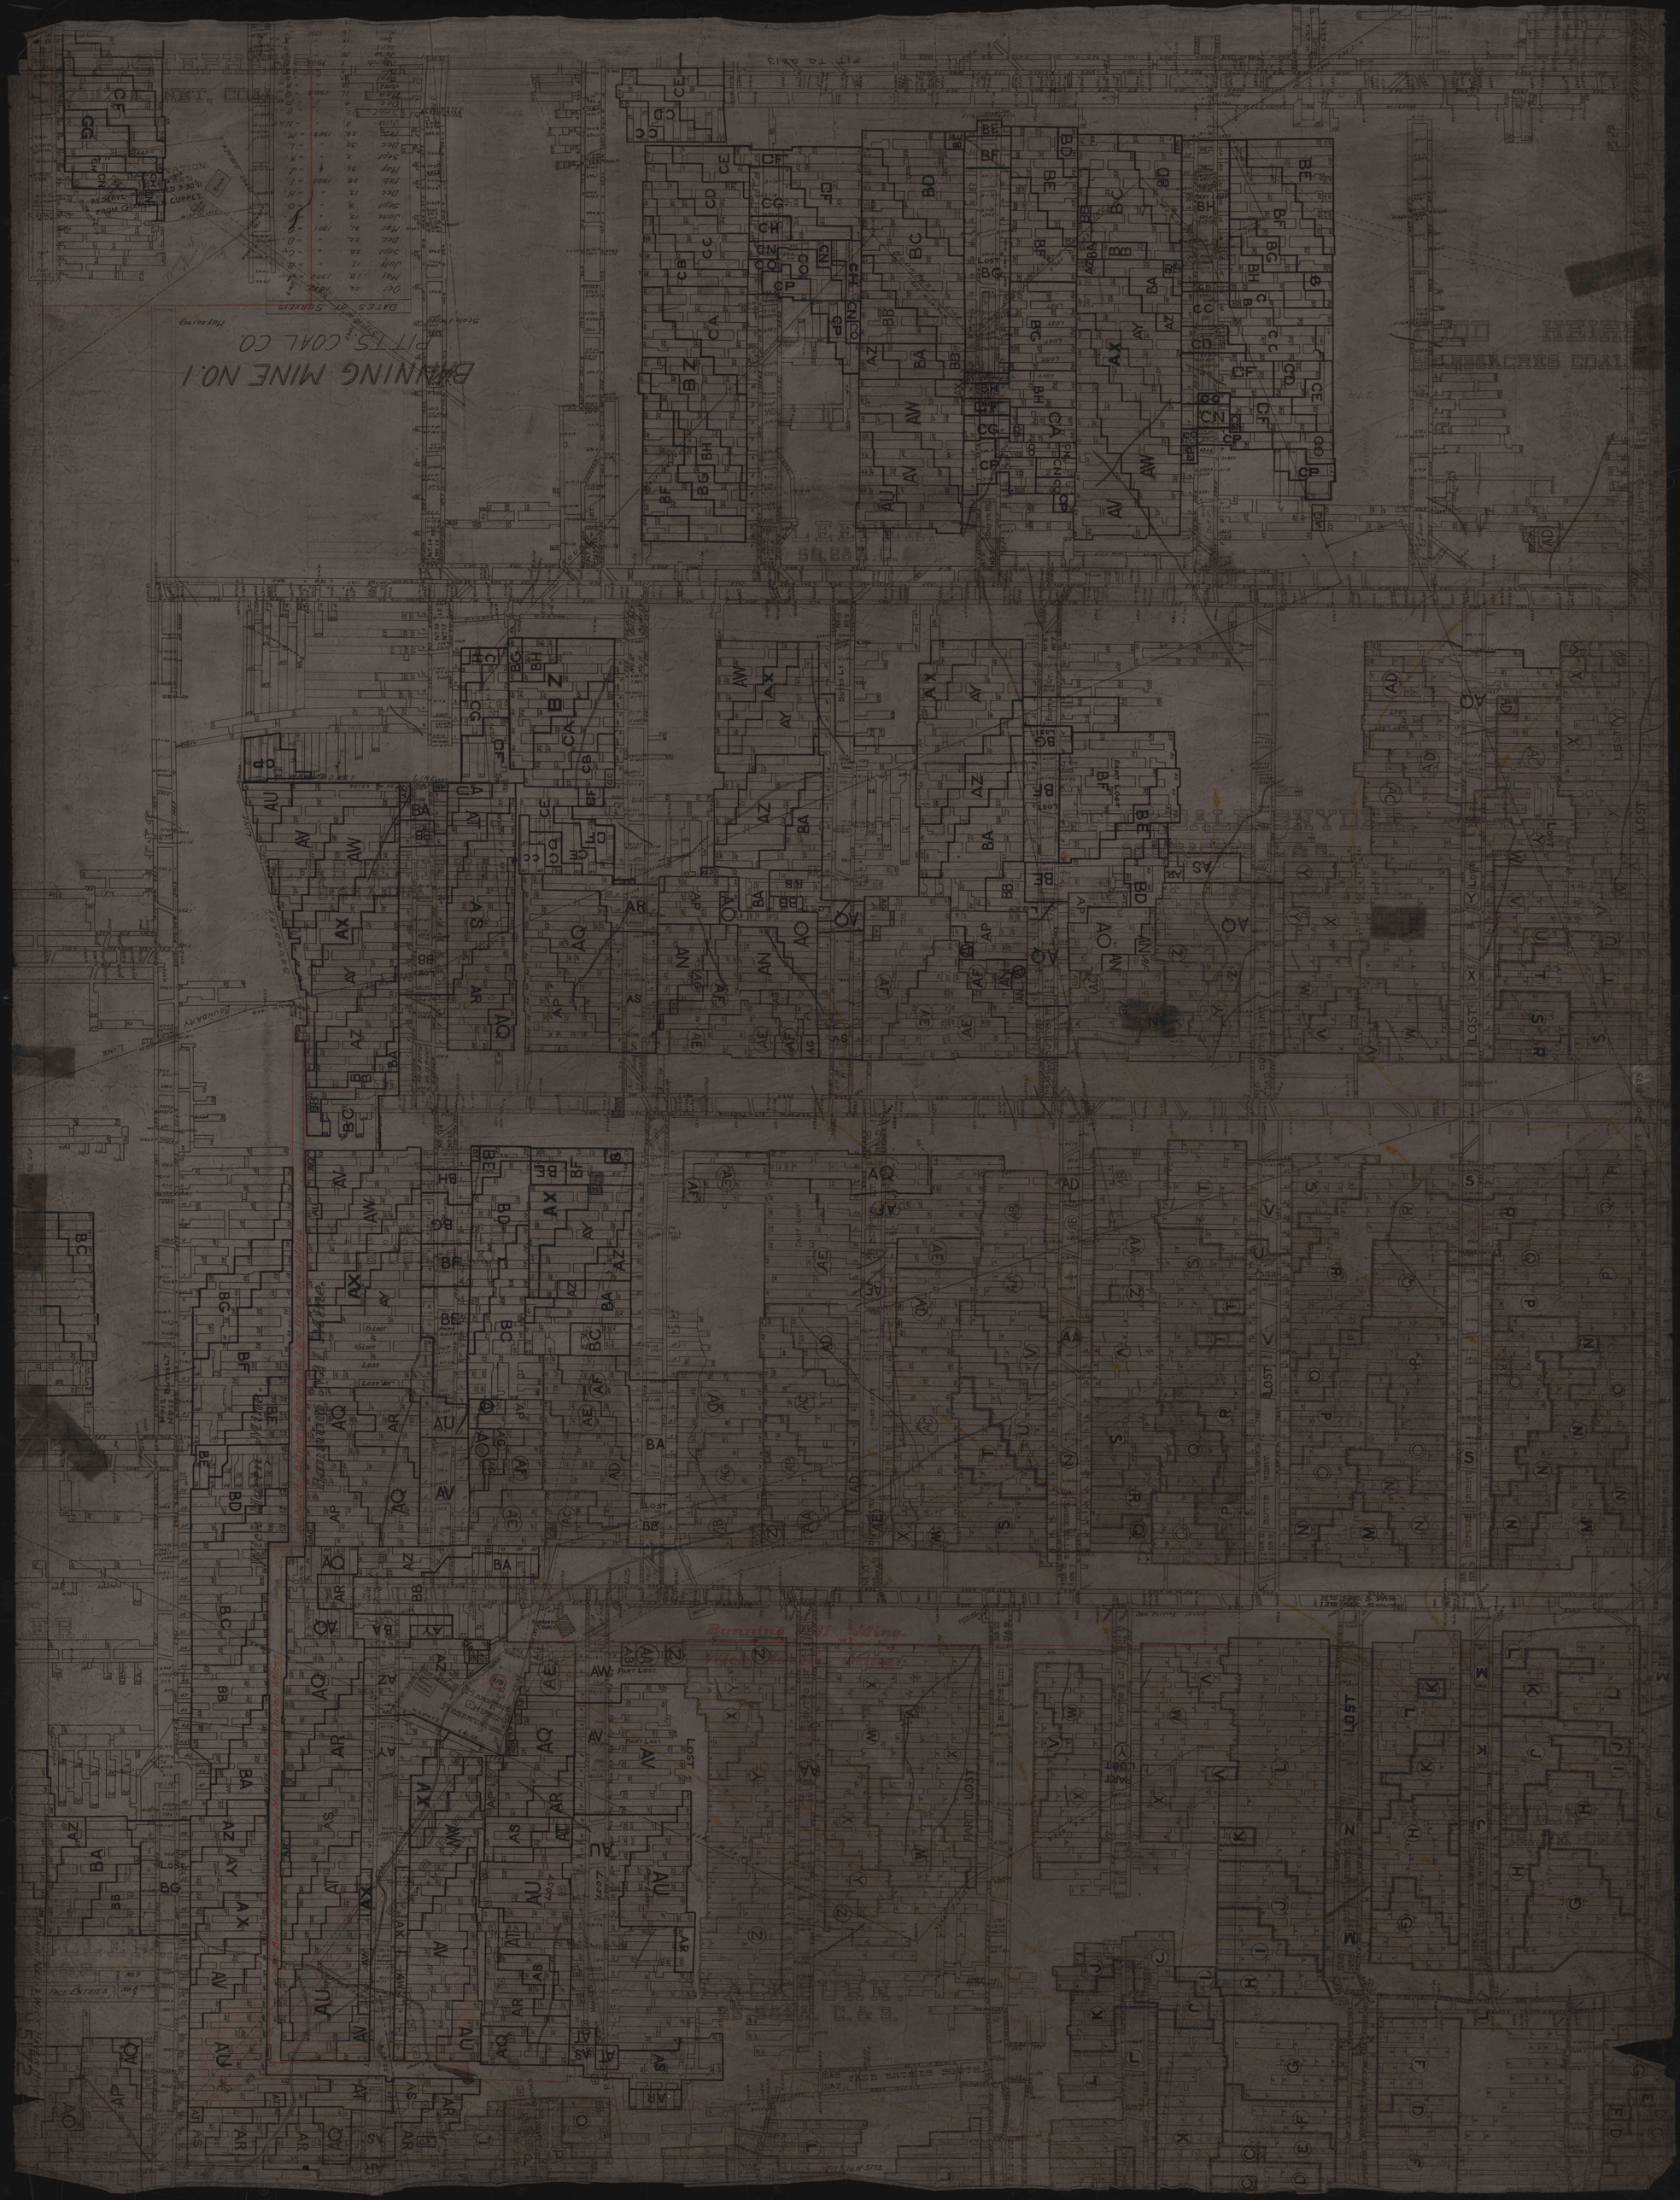
BANNING MINE NO. 1
PITTS COAL CO
DATES OF SURVEYS
Scale 1 inch = 100 feet
Flora 1903
Banning Mine
Mock Warren Mine
Banning No. 1 Mine
Mock Warren Mines
PACE ENTRIES
LOST
PART LOST
BOUNDARY LINE
FIT TO 4813
FIT TO H-5173