


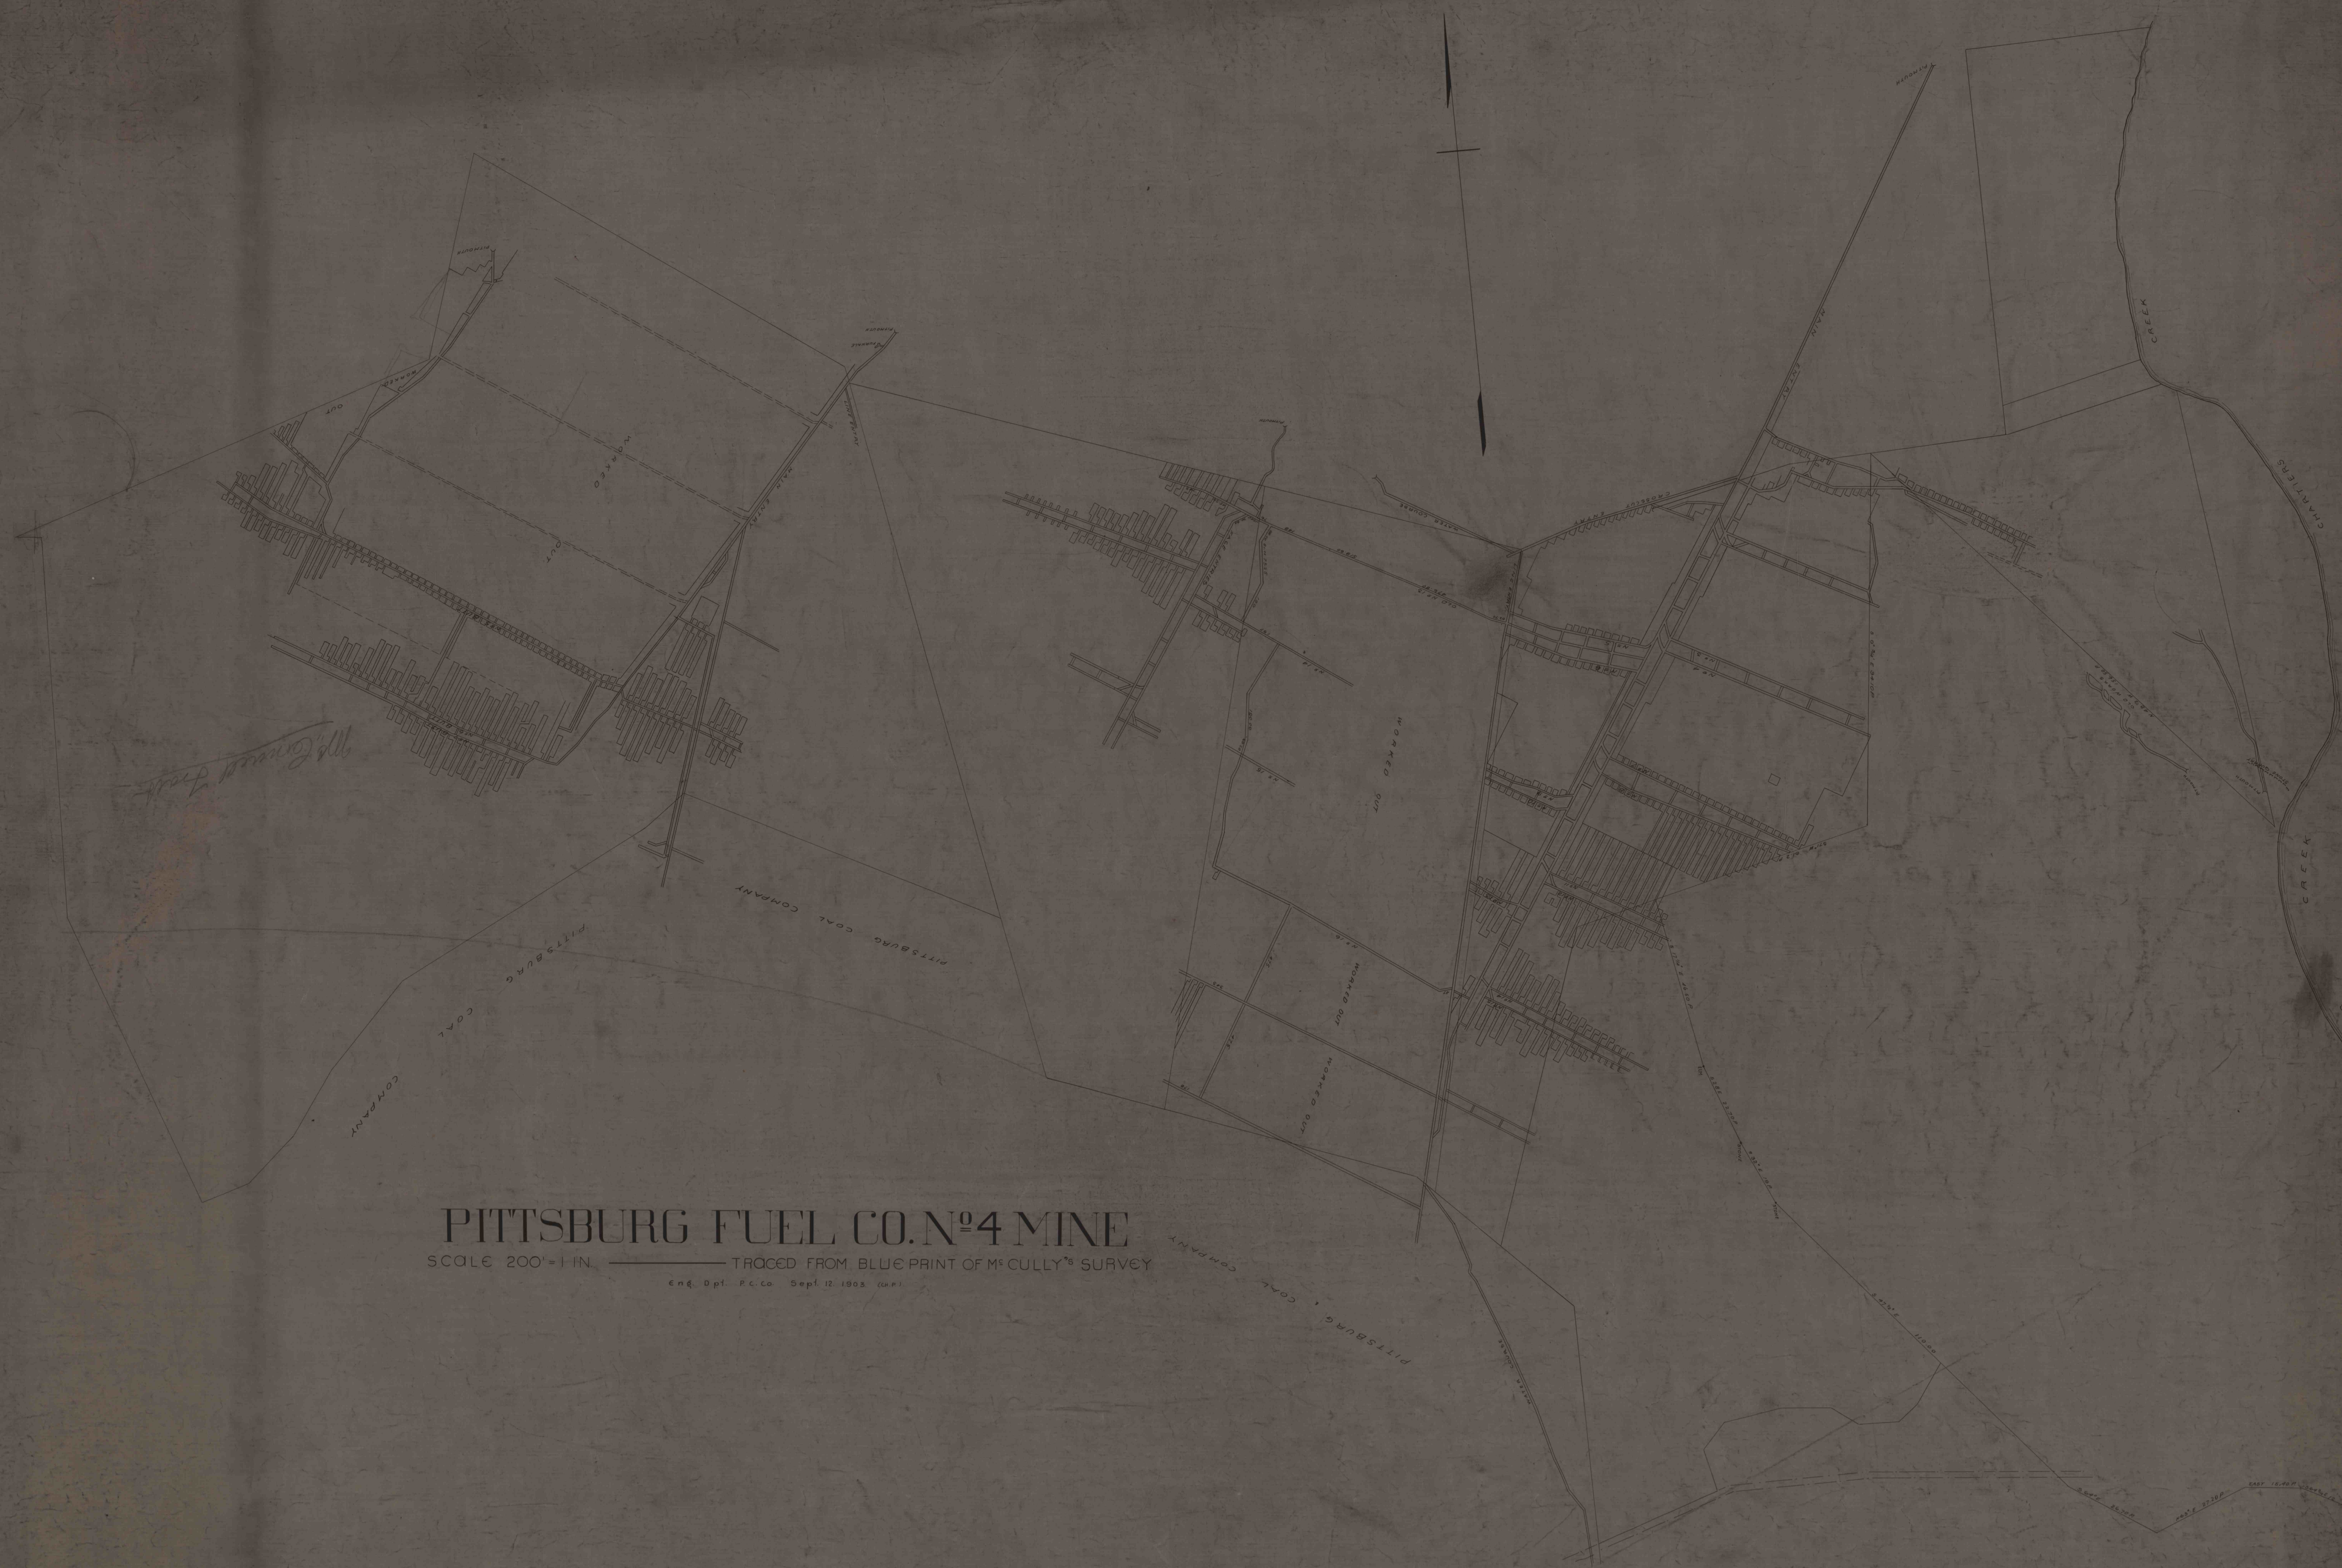

PITTSBURG FUEL CO. N^o 4 MINE
SCALE 200' = 1" IN. ———— TRACED FROM BLUE PRINT OF M^c CULLY'S SURVEY
Eng. Dpt. P.C.Co. Sept. 12, 1903 (G.W.P.)