


Plan of the  
DICKSON MINE

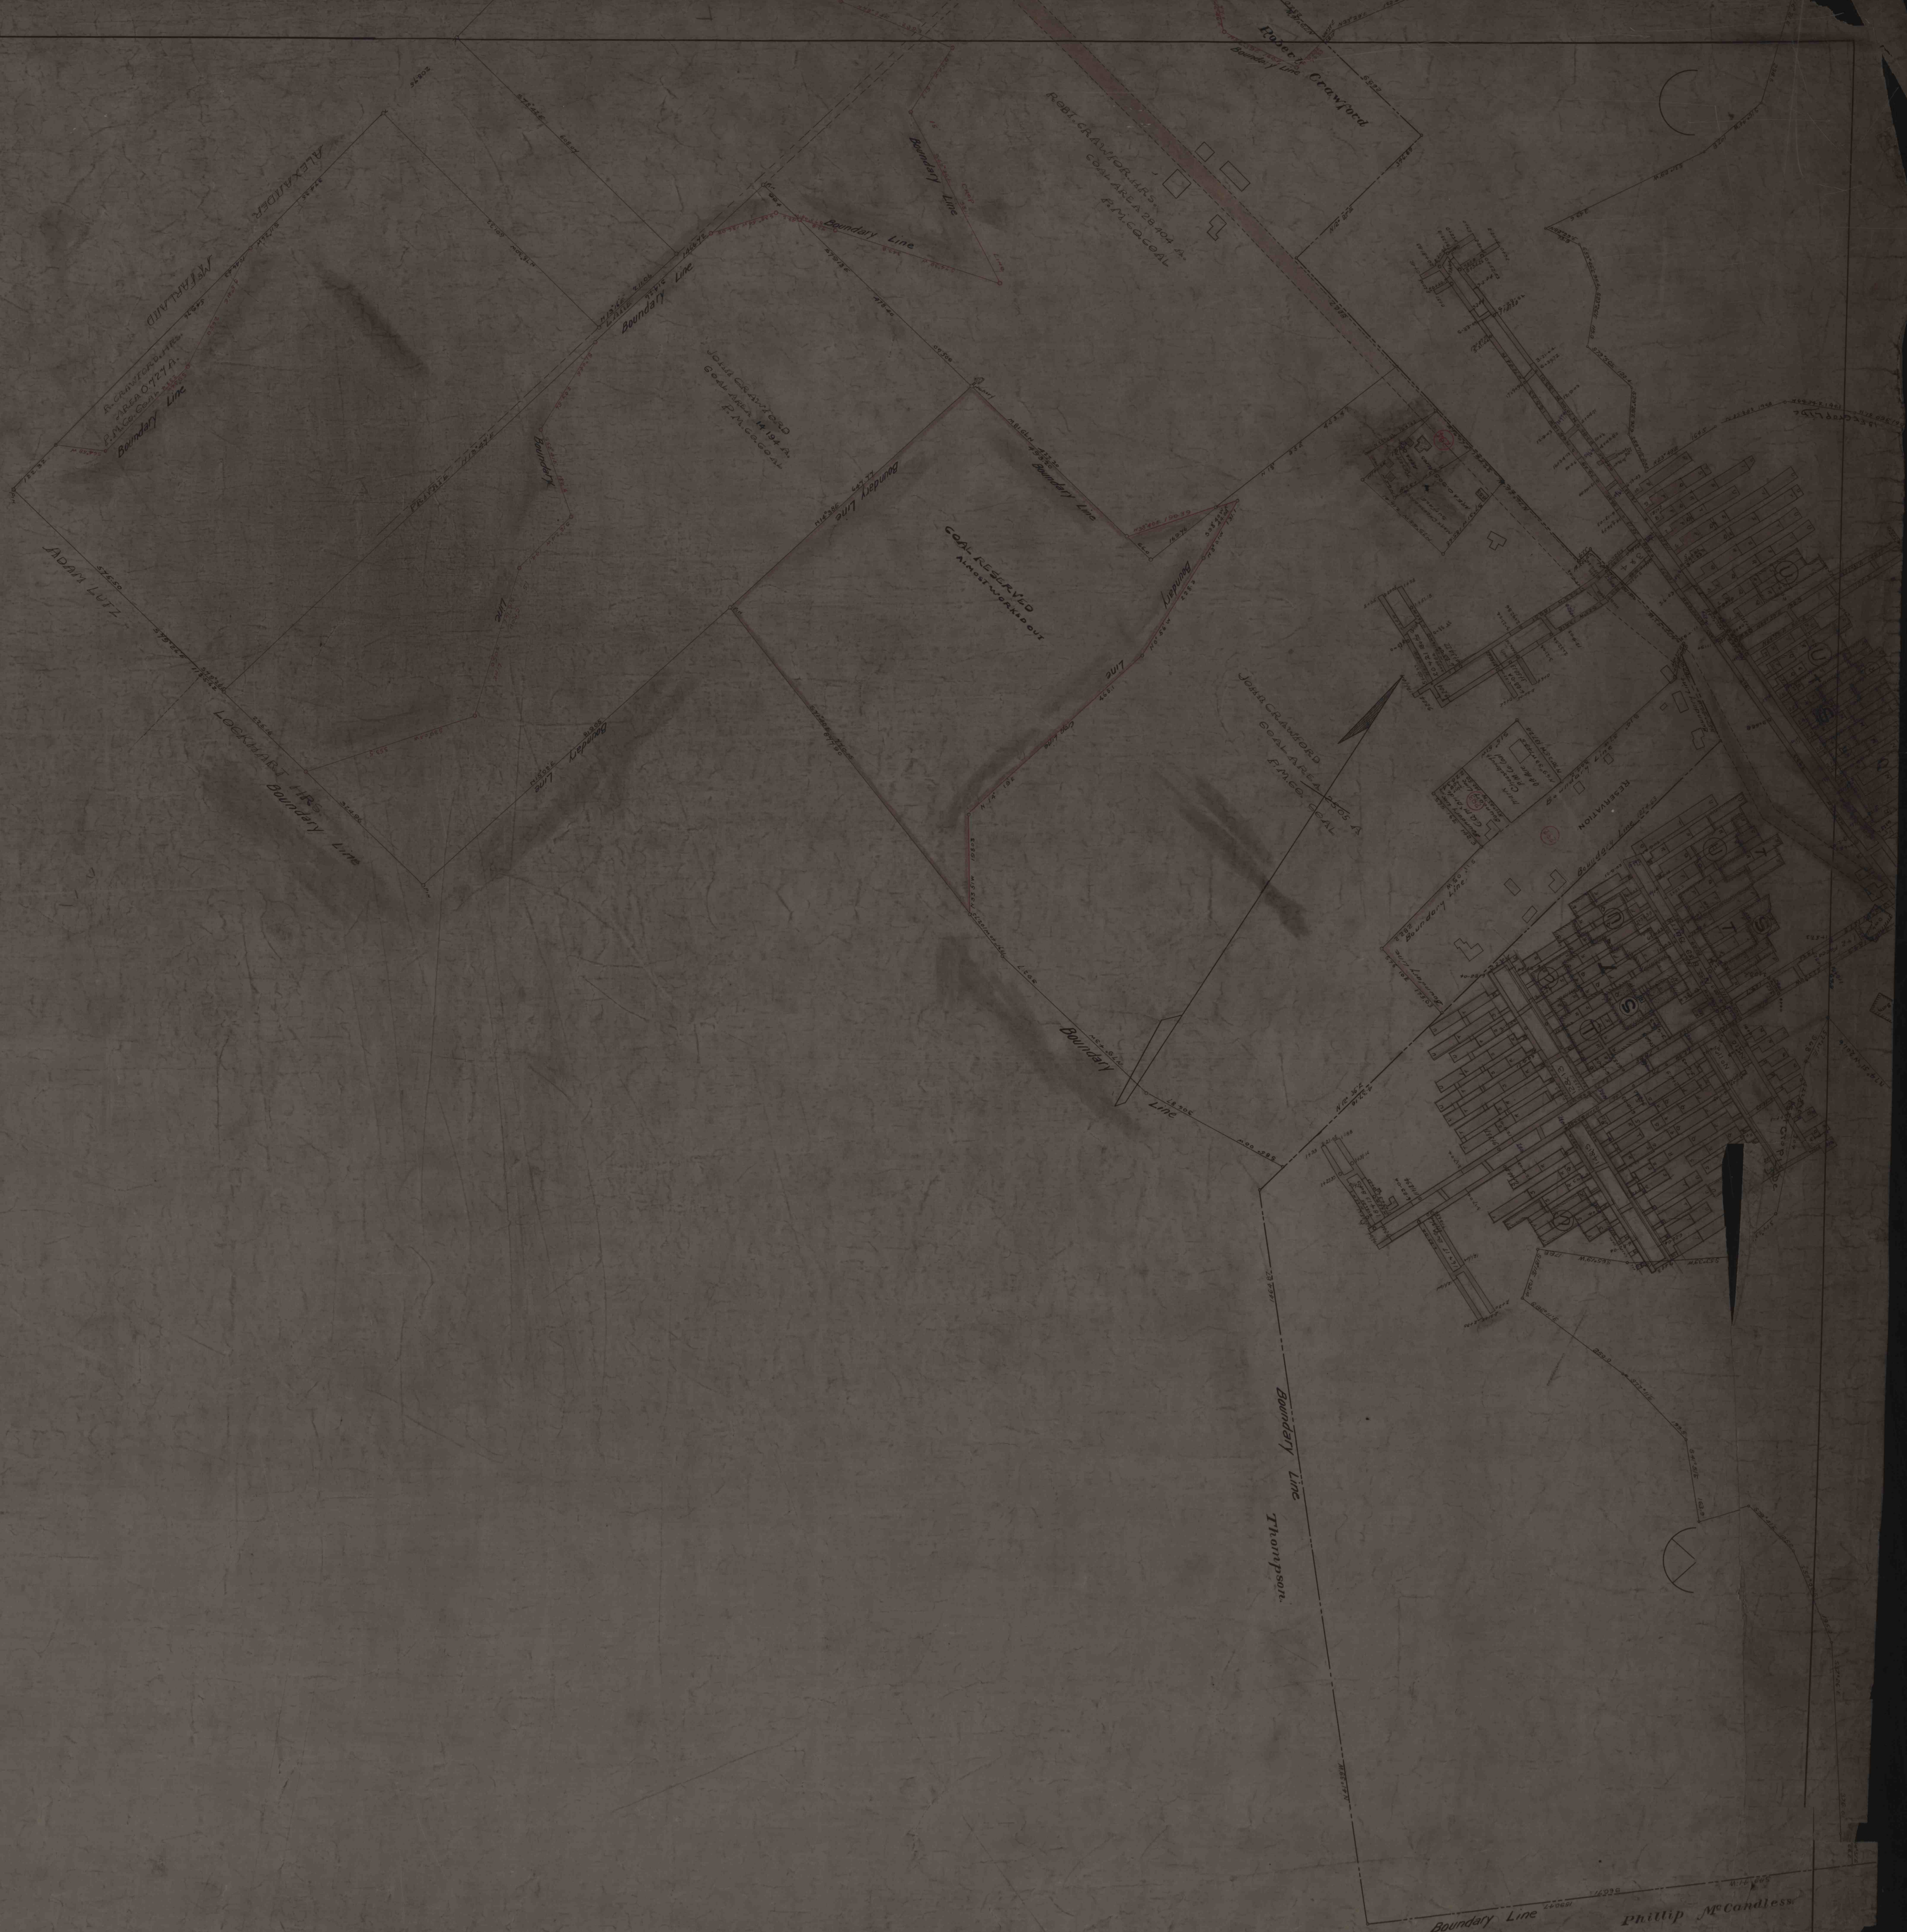


DICKSON