


5189
Equitable Mine
NOTICE
TO SUBMITTERS OF PATENT APPLICATIONS
No fee or penalty is levied on the inventor
submitting an application for a patent.
5189

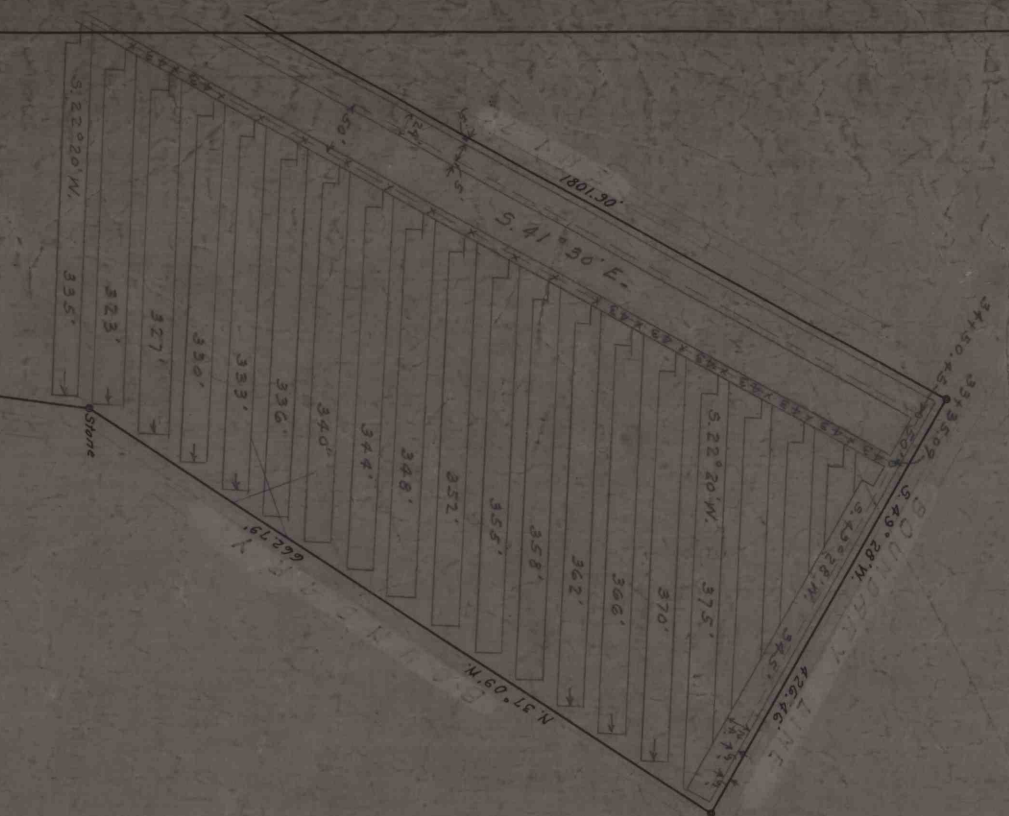

EQUITABLE MINE
PITTSBURGH COAL CO.
S. C. Le 17100

DATES OF SURVEY

MARCH	23, 1900	A	SEPT	7, 1905	AI
JUNE	9, "	B	DEC	11, "	AJ
SEPT	19, "	C	MAR	1, 1909	AK
DEC	18, "	D	JUNE	3, "	AL
JUNE	24, 1901	F	SEPT	7, "	AM
AUG	29, "	G	DEC	6, "	AN
DEC	16, "	H	MAR	4, 1910	AO
MARCH	7, 1902	I			
JUNE	10, "	J			
SEPT	24, "	K			
DEC	9, "	L			
MARCH	11, 1903	M			
JUNE	5, "	N			
AUG	28, "	O			
DEC	11, "	P			
MARCH	4, 1904	Q			
JUNE	11, 1904	R			
SEPT	15, "	S			
DEC	16, "	T			
MARCH	12, 1905	U			
JUNE	16, "	V			
SEPT	16, "	W			
DEC	6, "	X			
MARCH	10, 1906	Y			
JUNE	7, "	AA			
SEPT	15, "	AB			
DEC	12, 1907	AC			
MARCH	12, "	AD			
JUNE	12, "	AE			
SEPT	5, "	AF			
DEC	5, 1908	AG			
MARCH	5, "	AH			


