


SOUTHERN FIELD.
WILLIAMSTOWN COLLIERY. . . SECTION: No. 23. 1"=100'.
WICONISCO TWP., DAUPHIN CO., PA., "LOOKING WEST".
17-LYKENS VALLEY DISTRICT, SUSQUEHANNA COLL'RS.

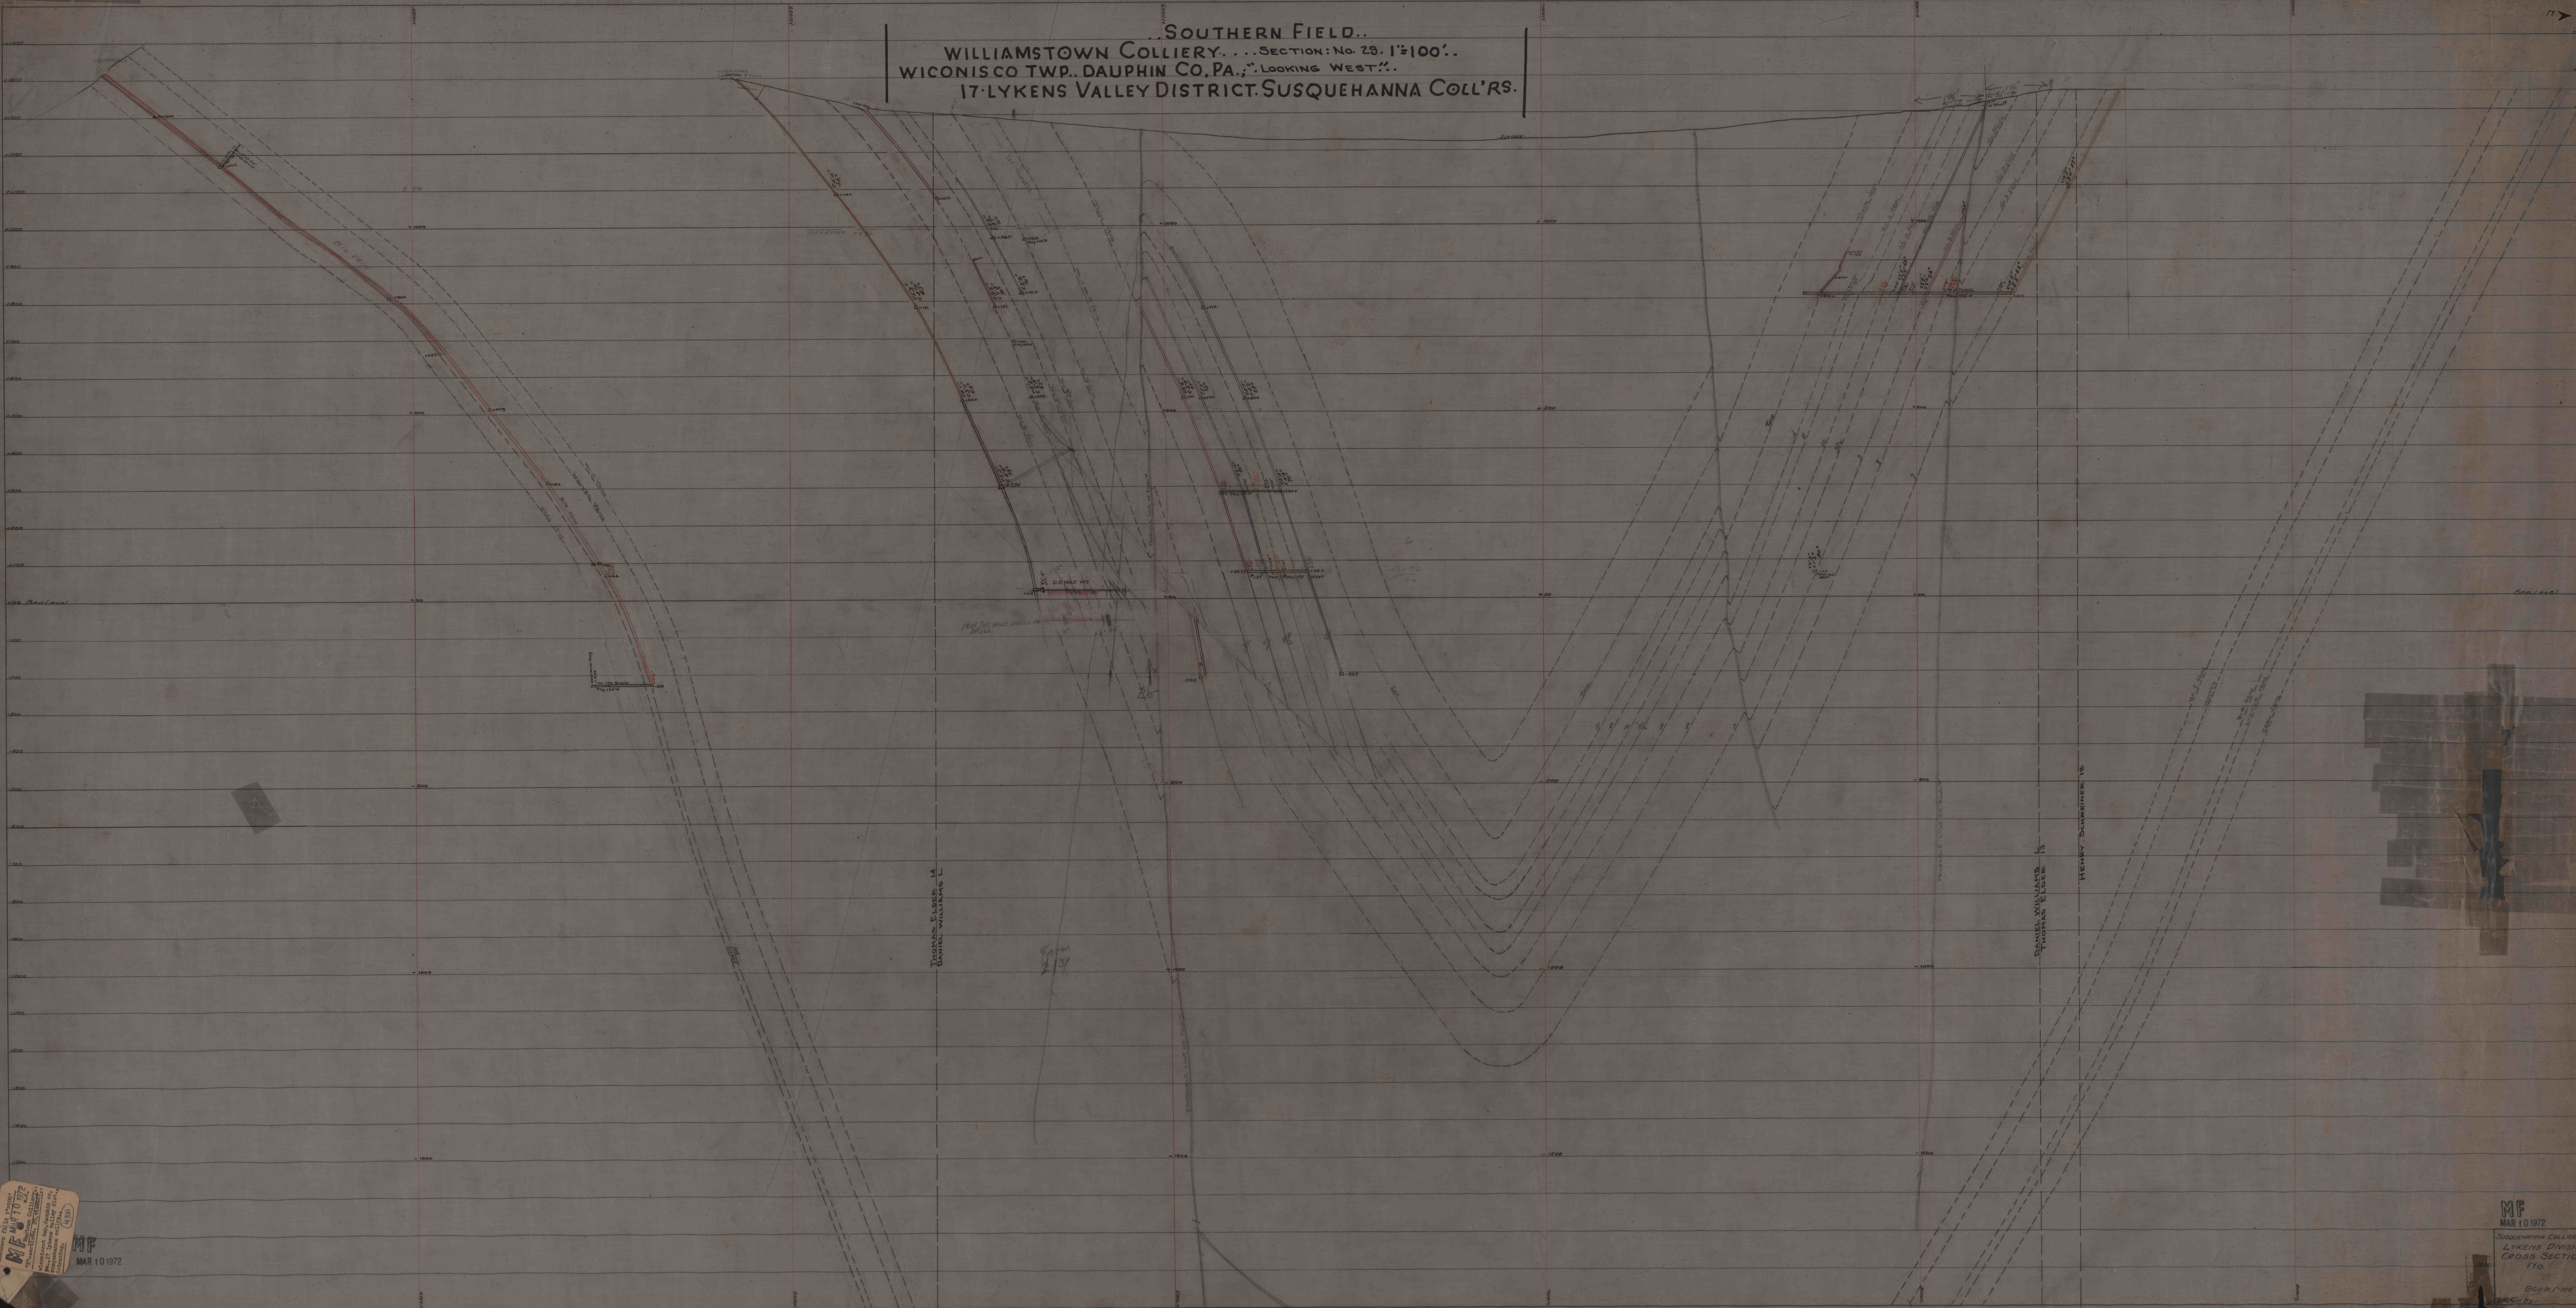

Section 23, 1"=100'
WILLIAMSTOWN COLLIERY
WICONISCO TWP., DAUPHIN CO., PA.
17-LYKENS VALLEY DISTRICT
SUSQUEHANNA COLLIERIES CO.
MAR 10 1972

MF
MAR 10 1972
SUSQUEHANNA COLLIERIES CO.
LYKENS DIVISION
CROSS SECTION
No. 23
Scale 1"=100'