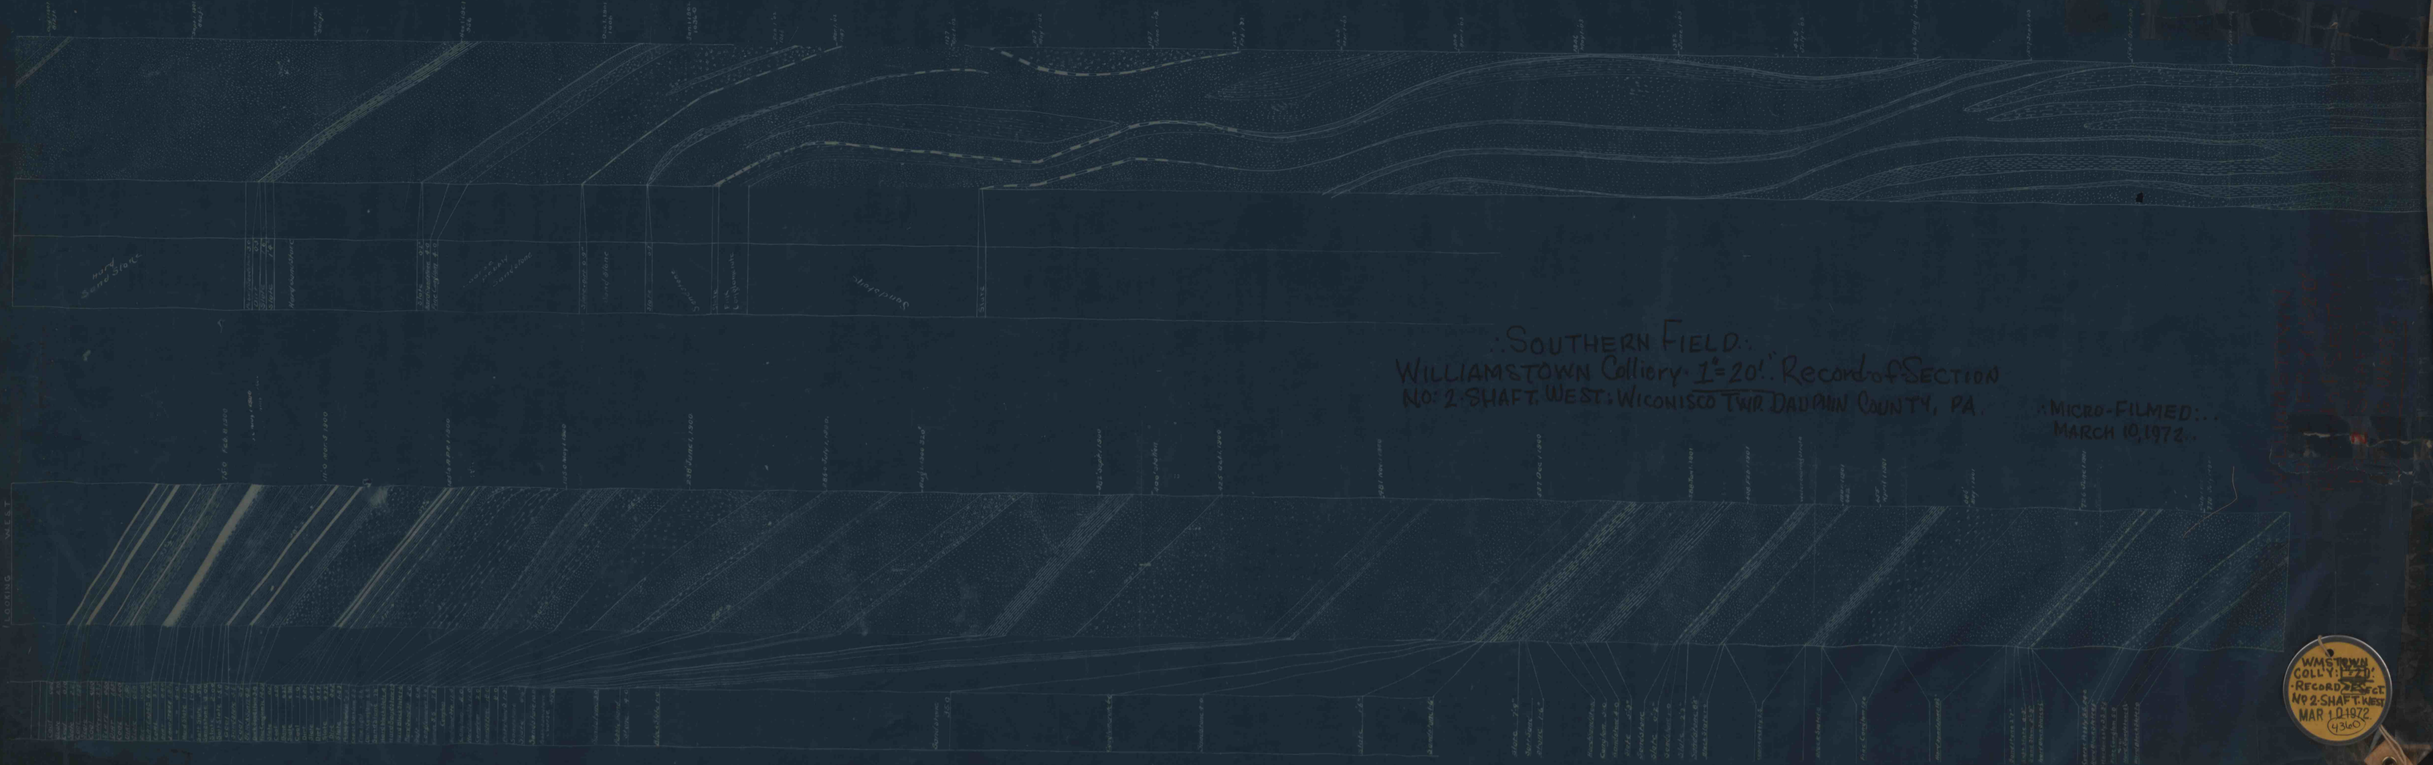
RECORD SECTION
IN
No 2 SHAFT
LOOKING
WEST
:SOUTHERN FIELD:
WILLIAMSTOWN Colliery · 1"=20' :. Record of SECTION
No: 2 SHAFT. WEST: WICONISCO TWP DAUPHIN COUNTY, PA.
:MICRO-FILMED:..
MARCH 10, 1972.
WMSTOWN
COLLY: 1"=20'
RECORD 25 FT.
No 2 SHAFT. WEST
MAR 10 1972
(43160)