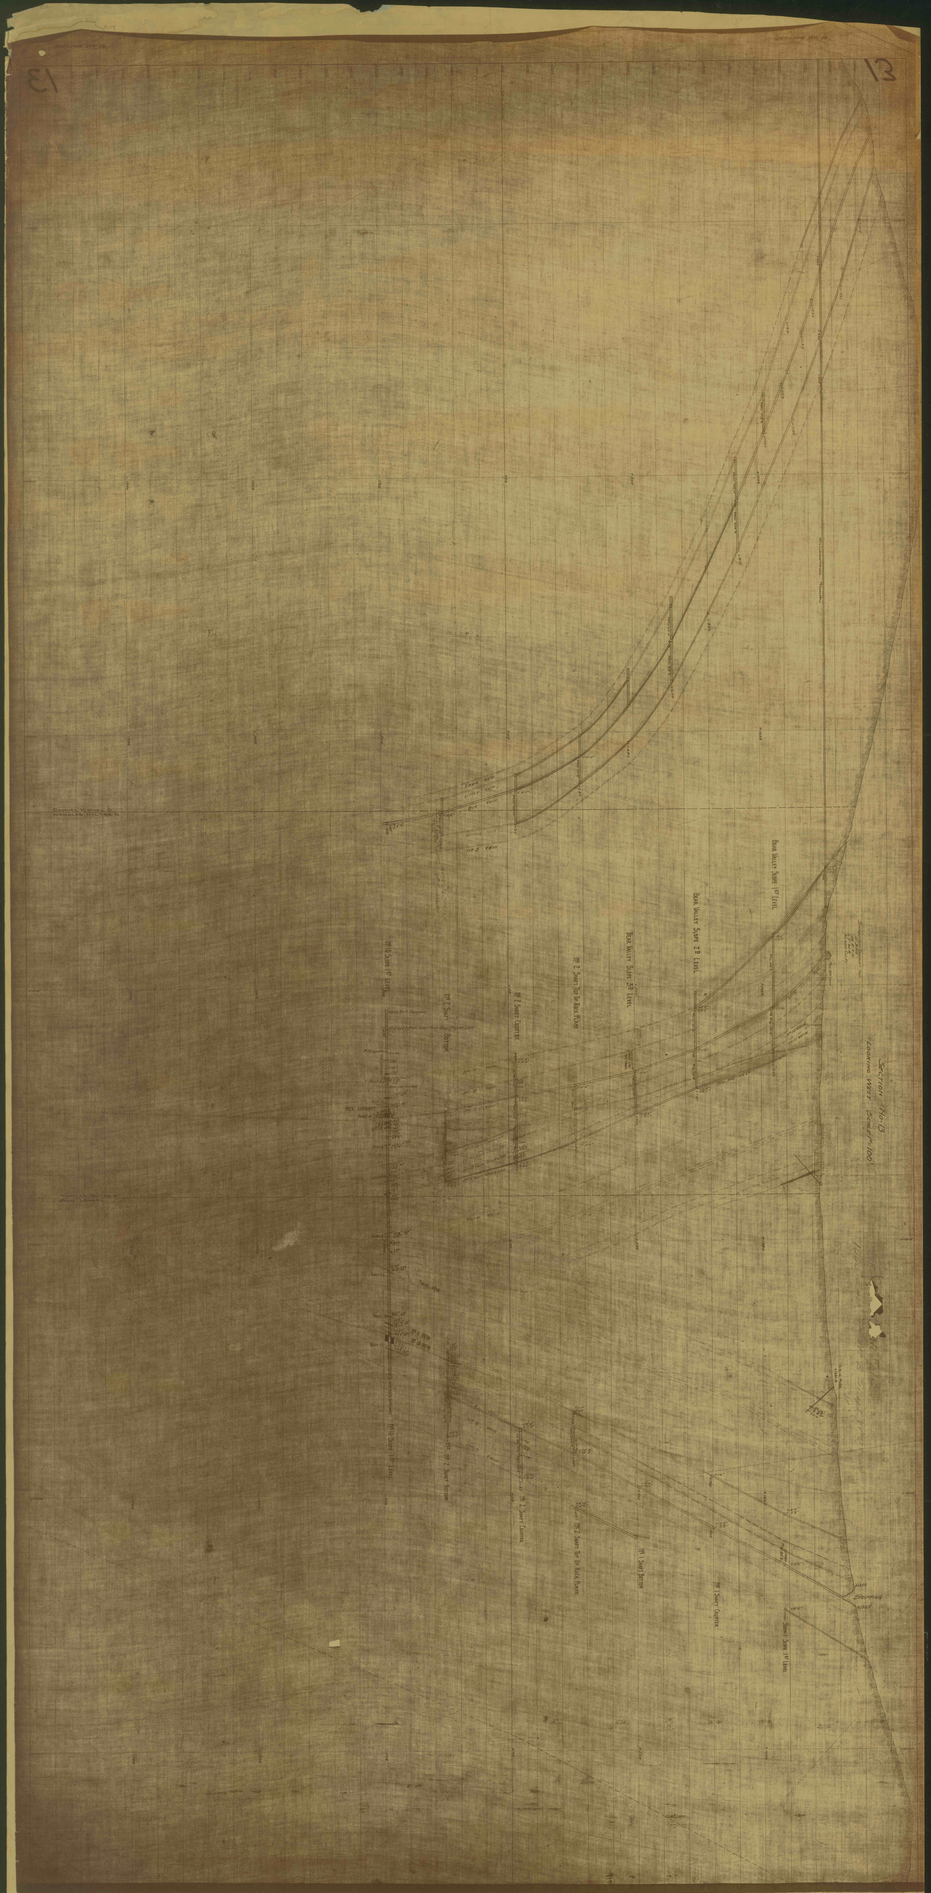
13
13
Section No. 13
