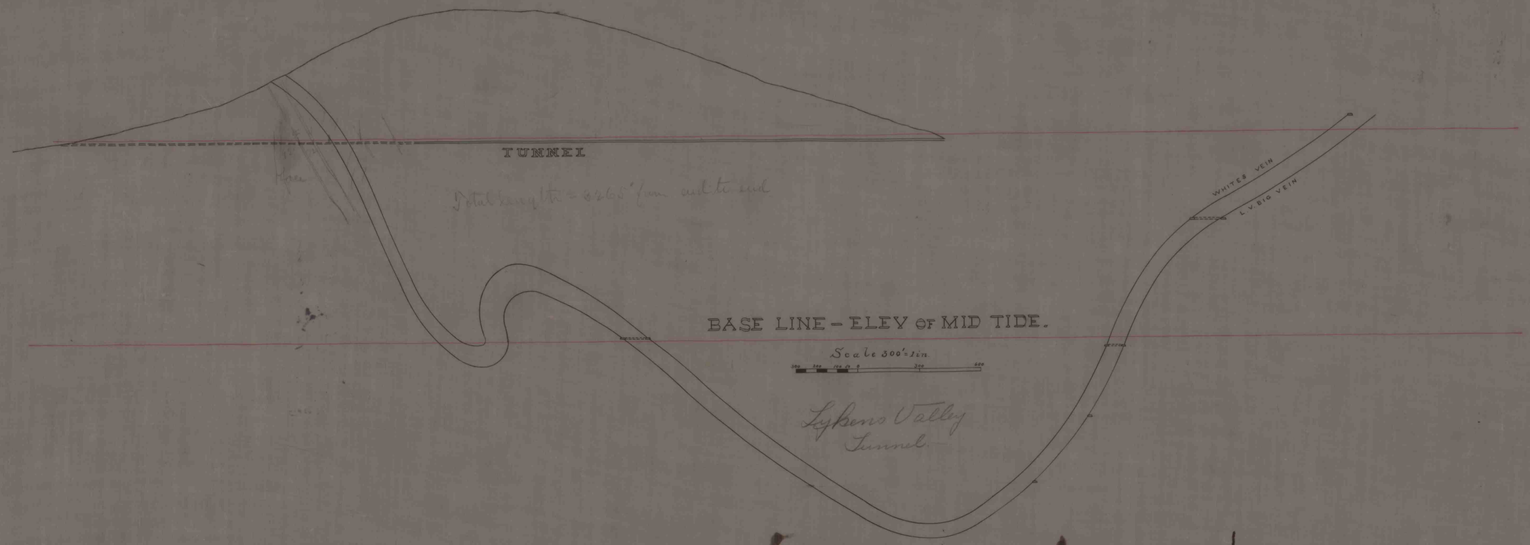

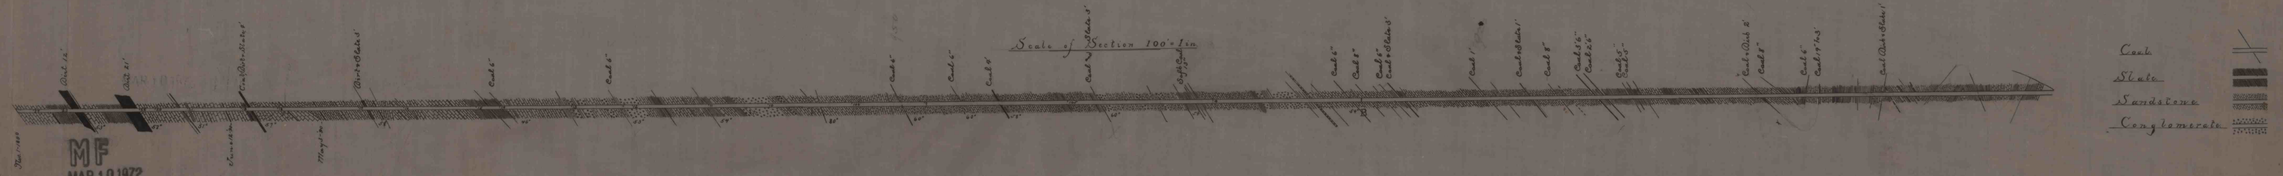

MF
MAR 10 1972

3 OF 4 TRACING