100 | 28,000,000 C.F.T.
210 | 280,000 CARS
200 | 1018 DAYS
5 YEARS

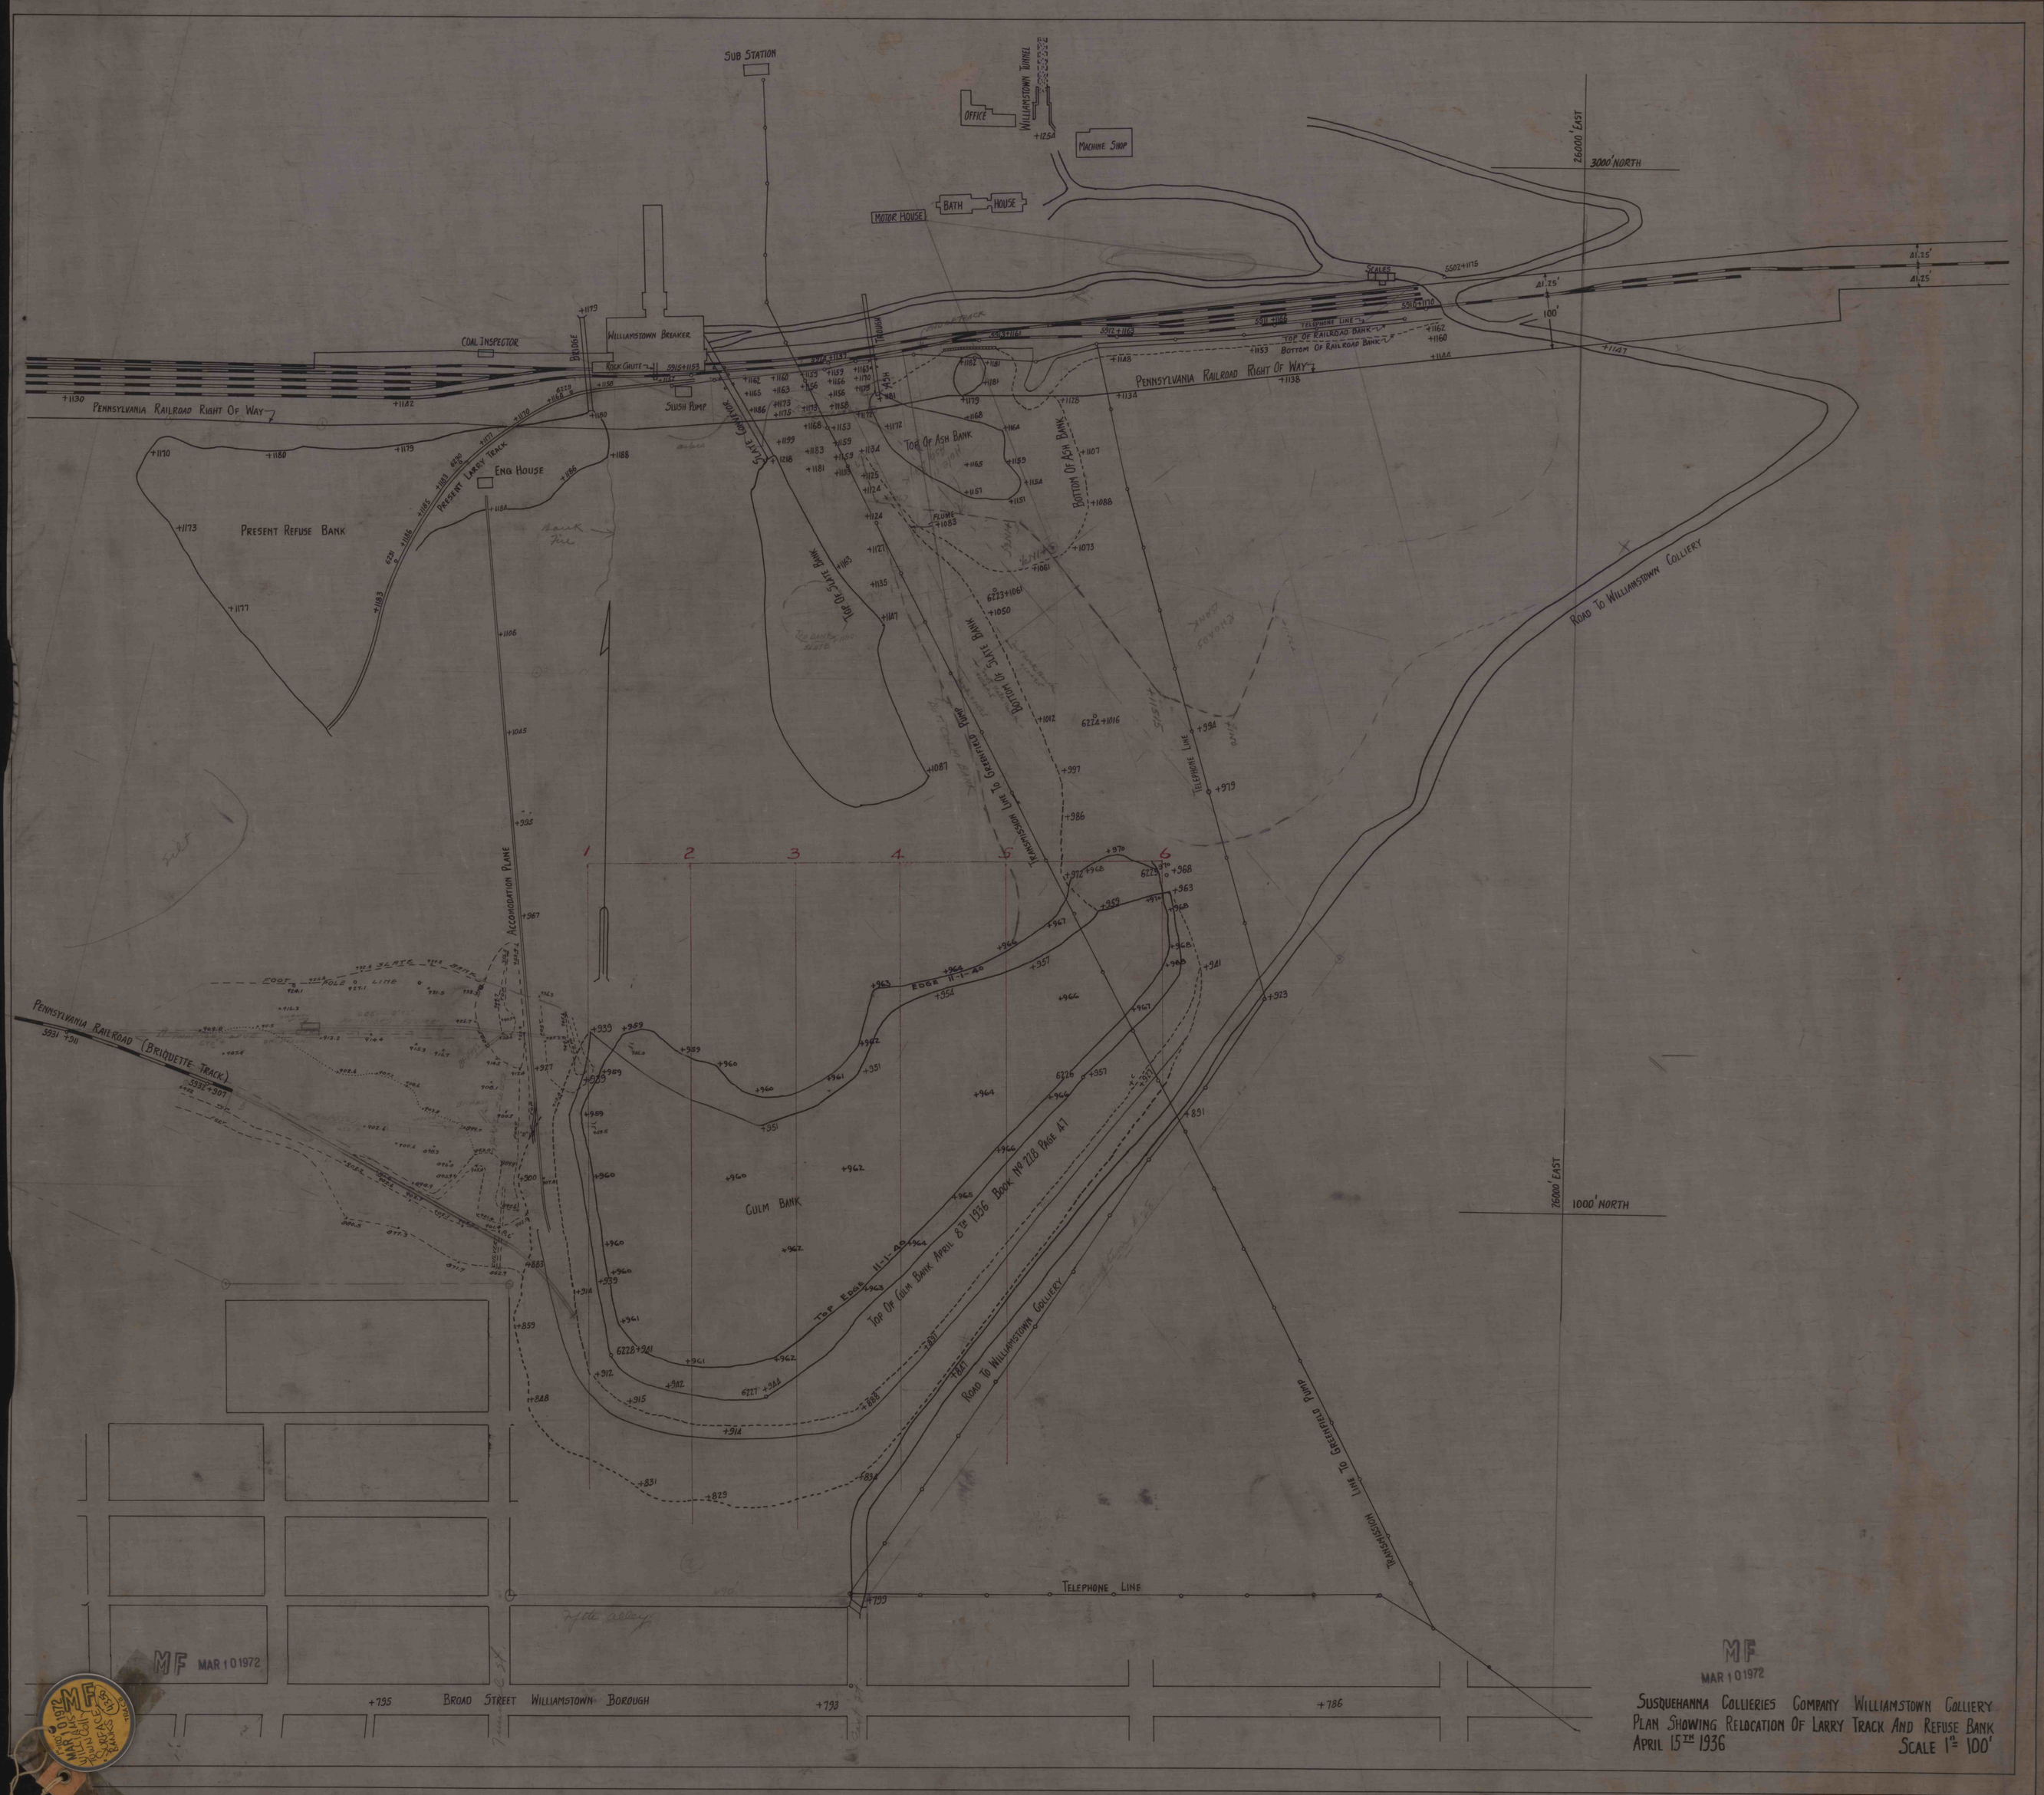

SUSQUEHANNA COLLIERIES COMPANY WILLIAMSTOWN COLLIERY
PLAN SHOWING RELOCATION OF LARRY TRACK AND REFUSE BANK
APRIL 15TH 1936 SCALE 1" = 100'

B/17