


...SOUTHERN COAL FIELD...  
WMSTOWN Colliery, Wiconisco Twp.  
DAUPHIN COUNTY PA., 17 Lykens Valley District...  
SUSQUEHANNA COLLIERIES.  
SECTION No. 20.  
Scale 1"=100'

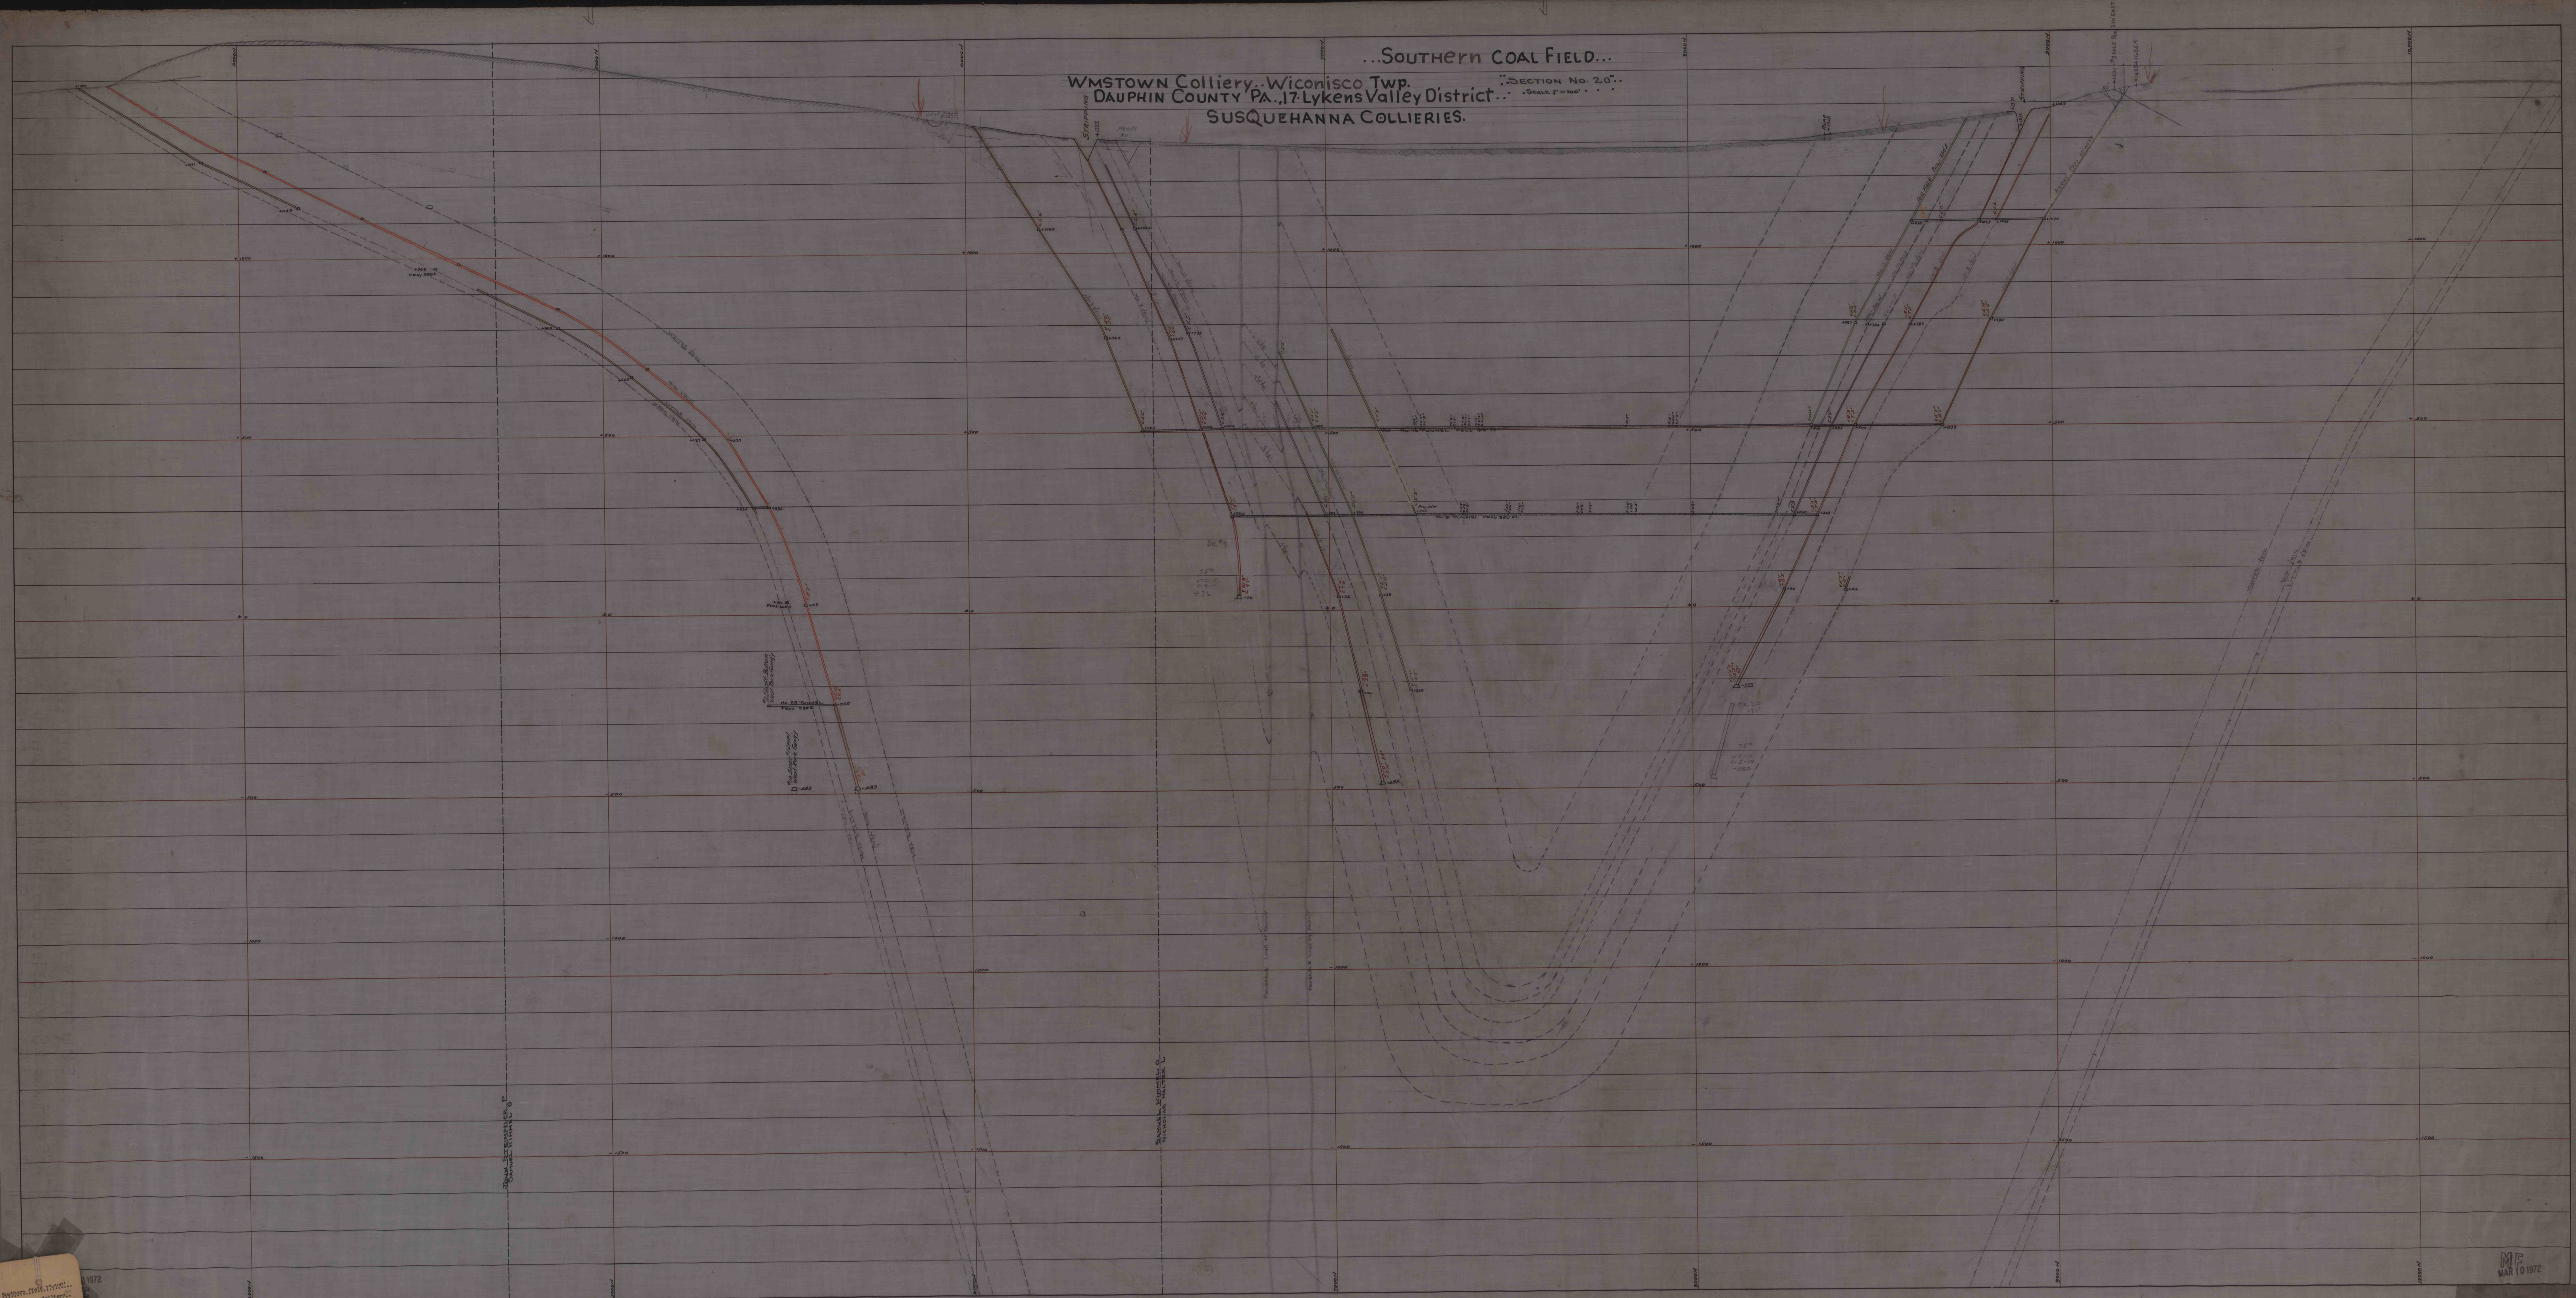

WMSTOWN Colliery, Wiconisco Twp.  
DAUPHIN COUNTY PA., 17 Lykens Valley District...  
SUSQUEHANNA COLLIERIES.  
SECTION No. 20.  
Scale 1"=100'

M  
MAR 10 1972