


..SOUTHERN COAL FIELD..WMSTOWN COLLIERY..
WICONISCO TWP., DAUPHIN COUNTY PA. SECTION No 31
17-LYKENS VALLEY DISTRICT-SUSQUEHANNA
COLLIERIES.

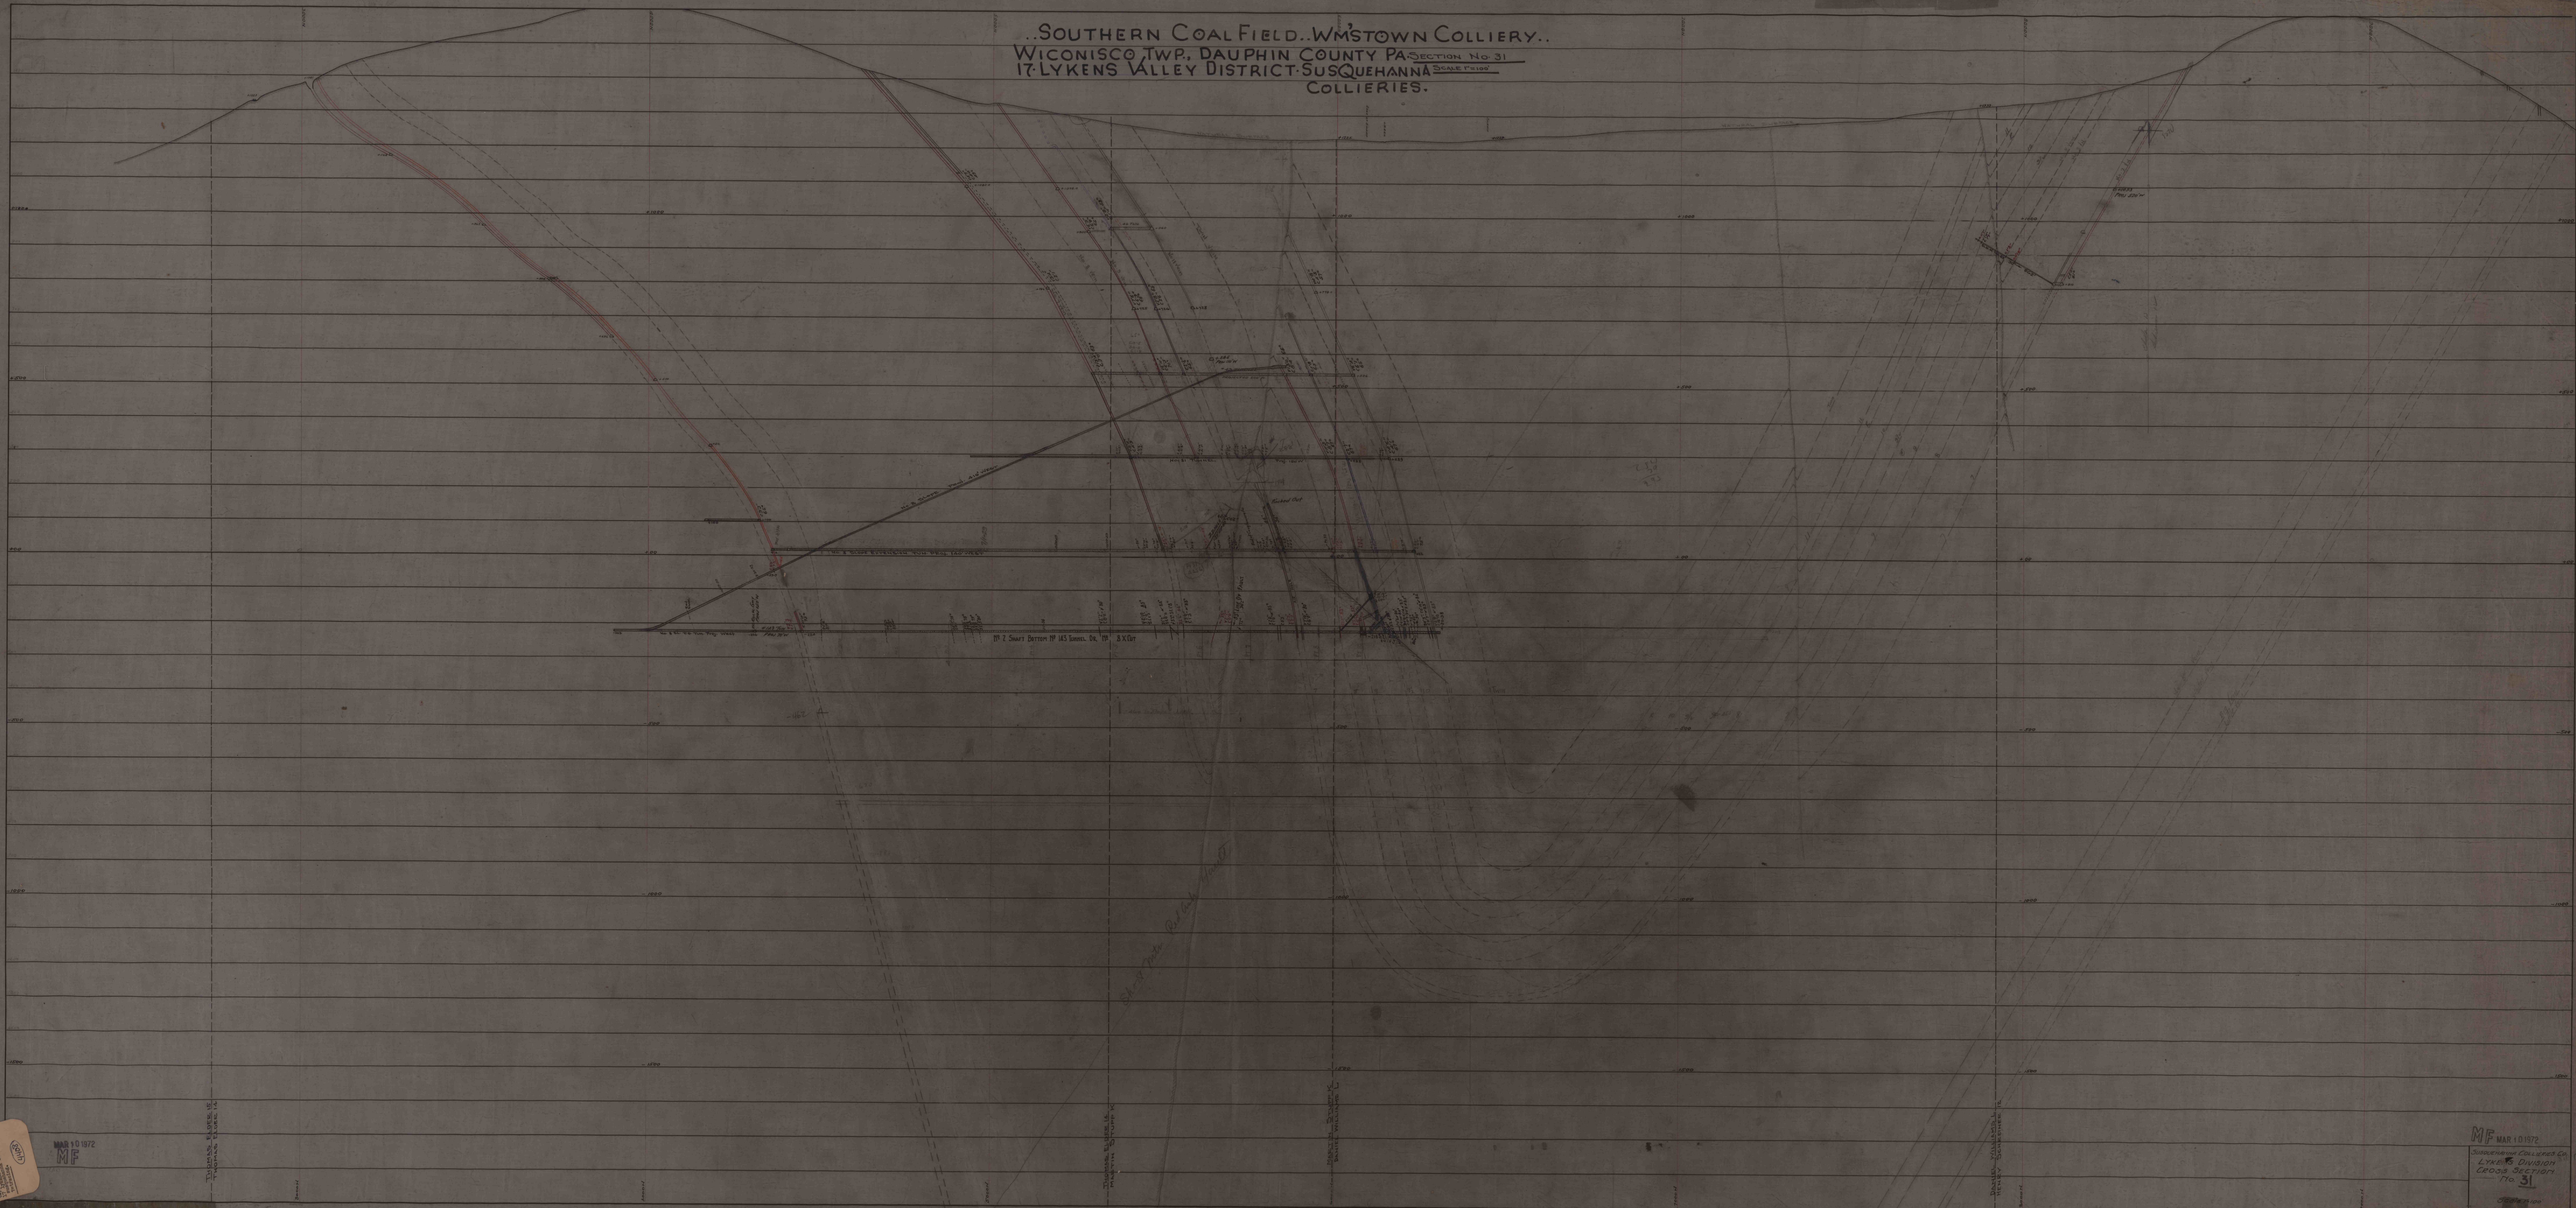

MF MAR 10 1972
MAR 10 1972
MF

MF MAR 10 1972
MAR 10 1972
MF