


...Southern Coal Field...

WILLIAMSTOWN COLL'Y. "SECTION No. 32". WICONISCO TWP.
"Looking West". Scale 1"=100'. DAUPHIN COUNTY, PA.,
17 LYKENS VALLEY DISTRICT. SUSQUEHANNA COLL'RS.

Natural Surface

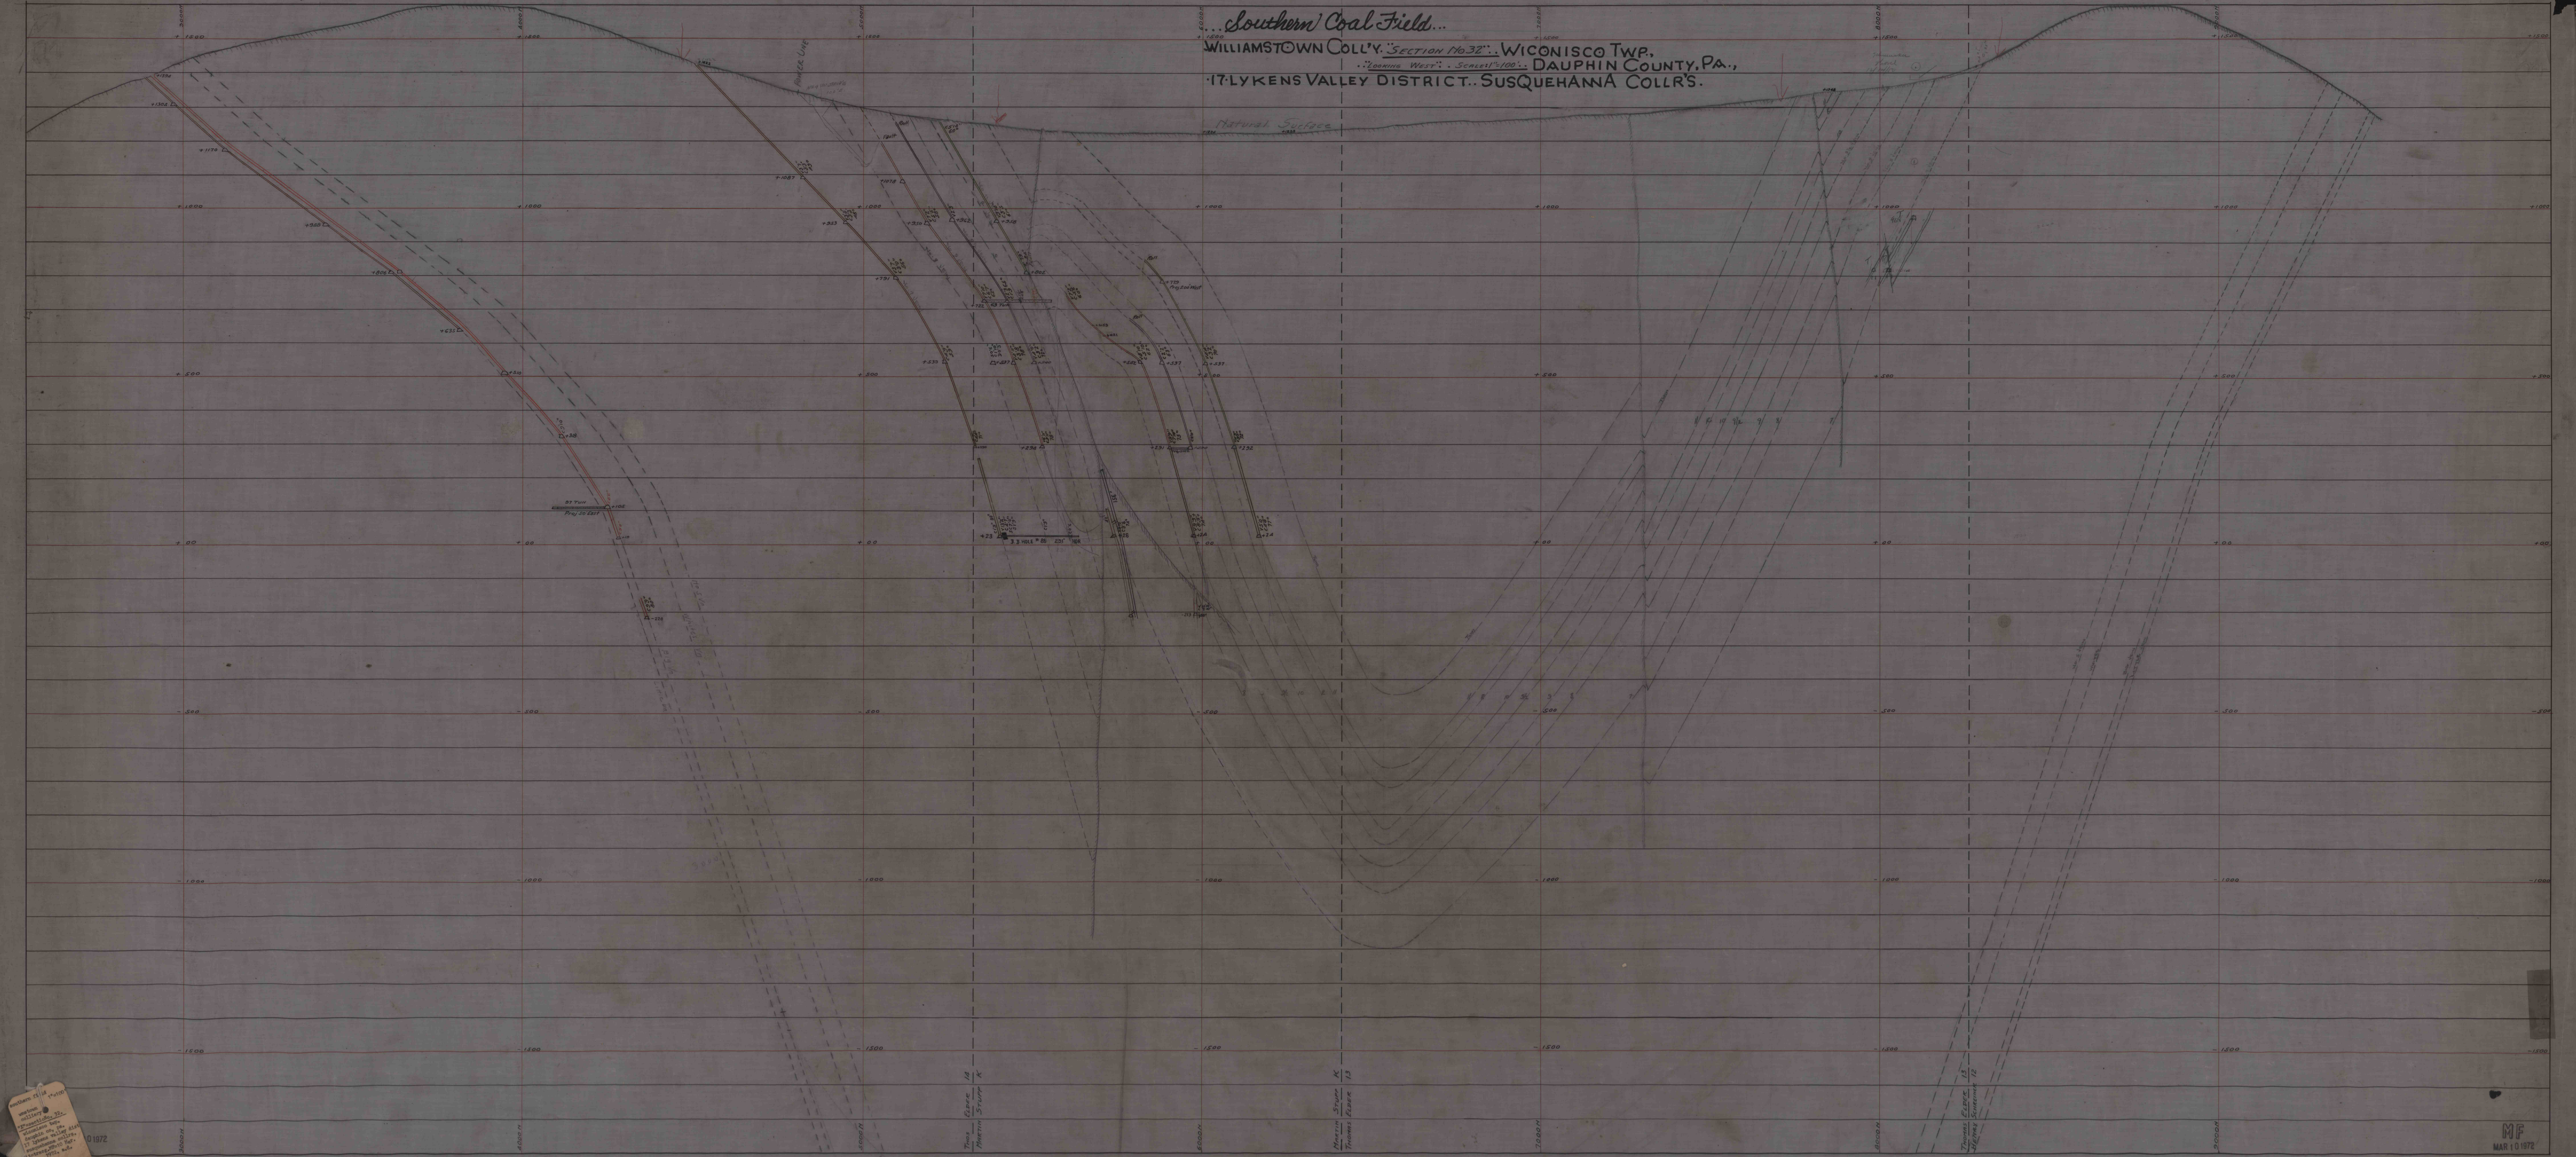

Section 32 of 18
Williamstown Colliery
Dauphin County, Pa.
17 Lykens Valley District
Susquehanna Coal Co.
1917

MF
MAR 10 1917