


..SOUTHERN COAL FIELD.. ..Cross Section No. 88..
 Wm'sTOWN Colliery..Wiconisco Twp.. Scale 1"=100' ..
 DAUPHIN COUNTY PA., SUSQUEHANNA Collieries.
 17. LYKENS VALLEY DISTRICT.

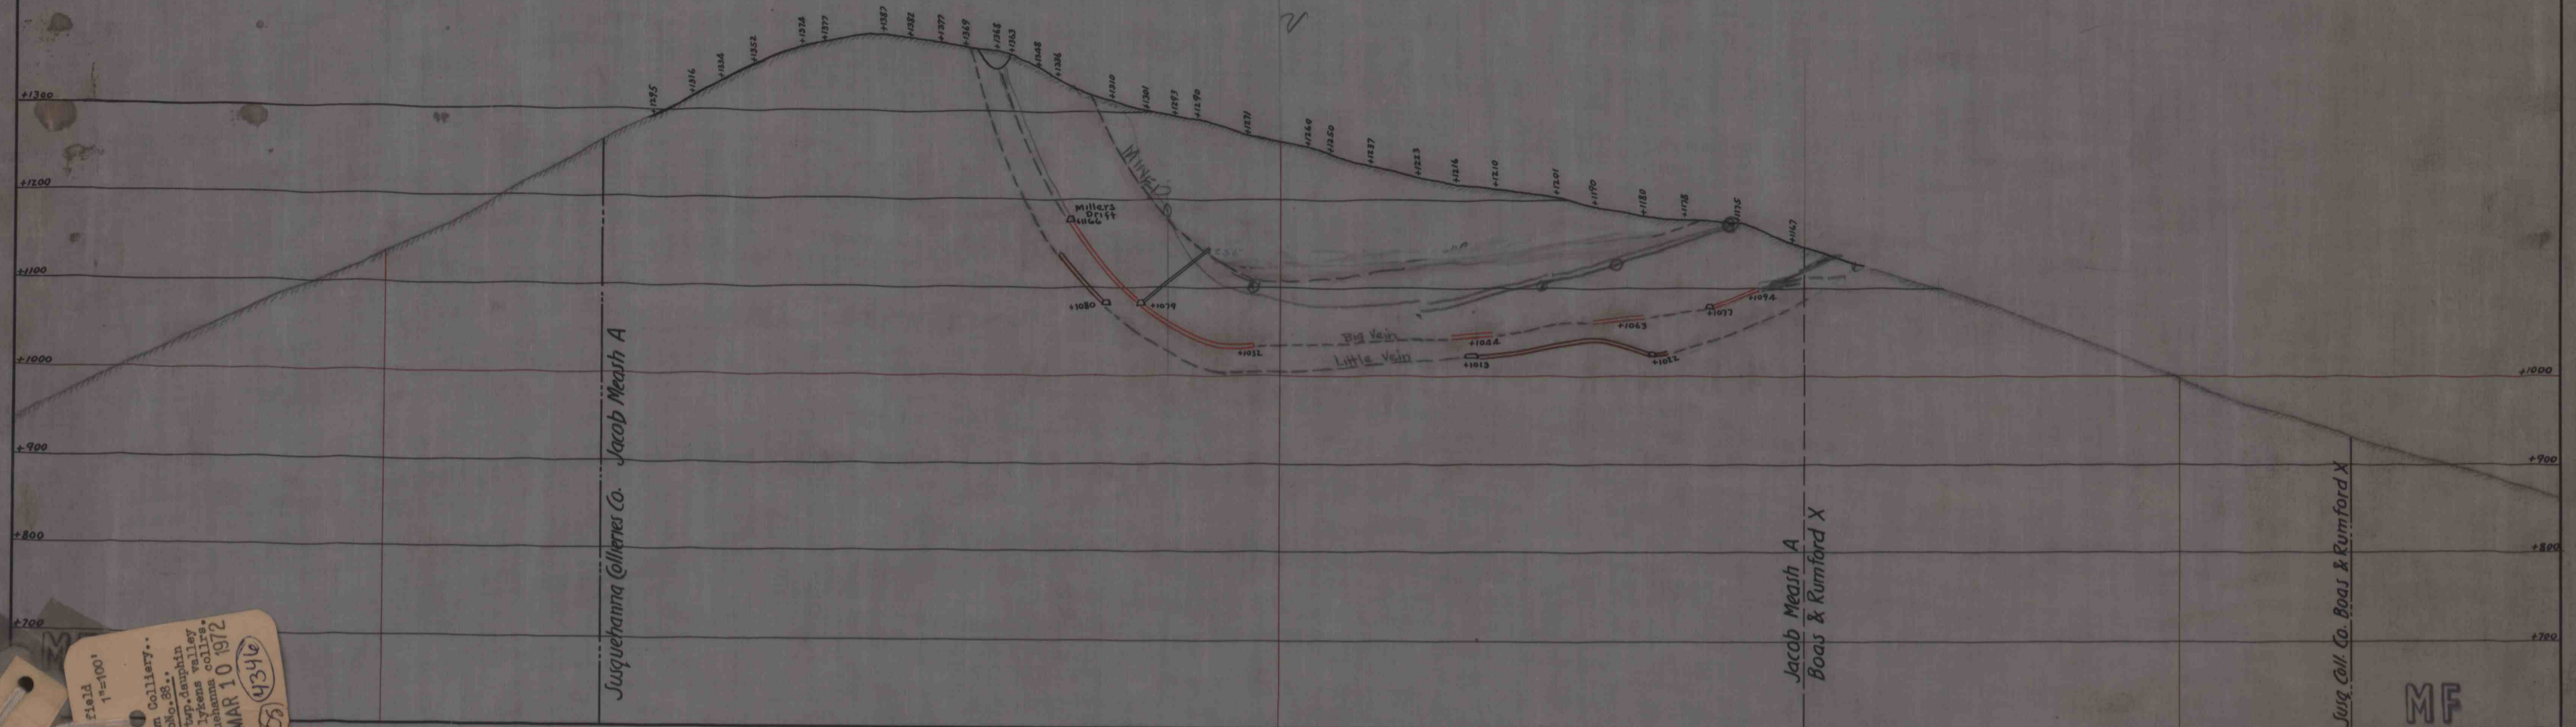

southern field
 1"=100'
 Wm'sTOWN Colliery..
 Wiconisco Twp., Dauphin
 Co., Pa. 17 Lykens valley
 dist., Susquehanna
 MAR 10 1972
 MF 4346

MF
 MAR 10 1972