


SECTION No 33
LOOKING WEST SCALE 1"=100'

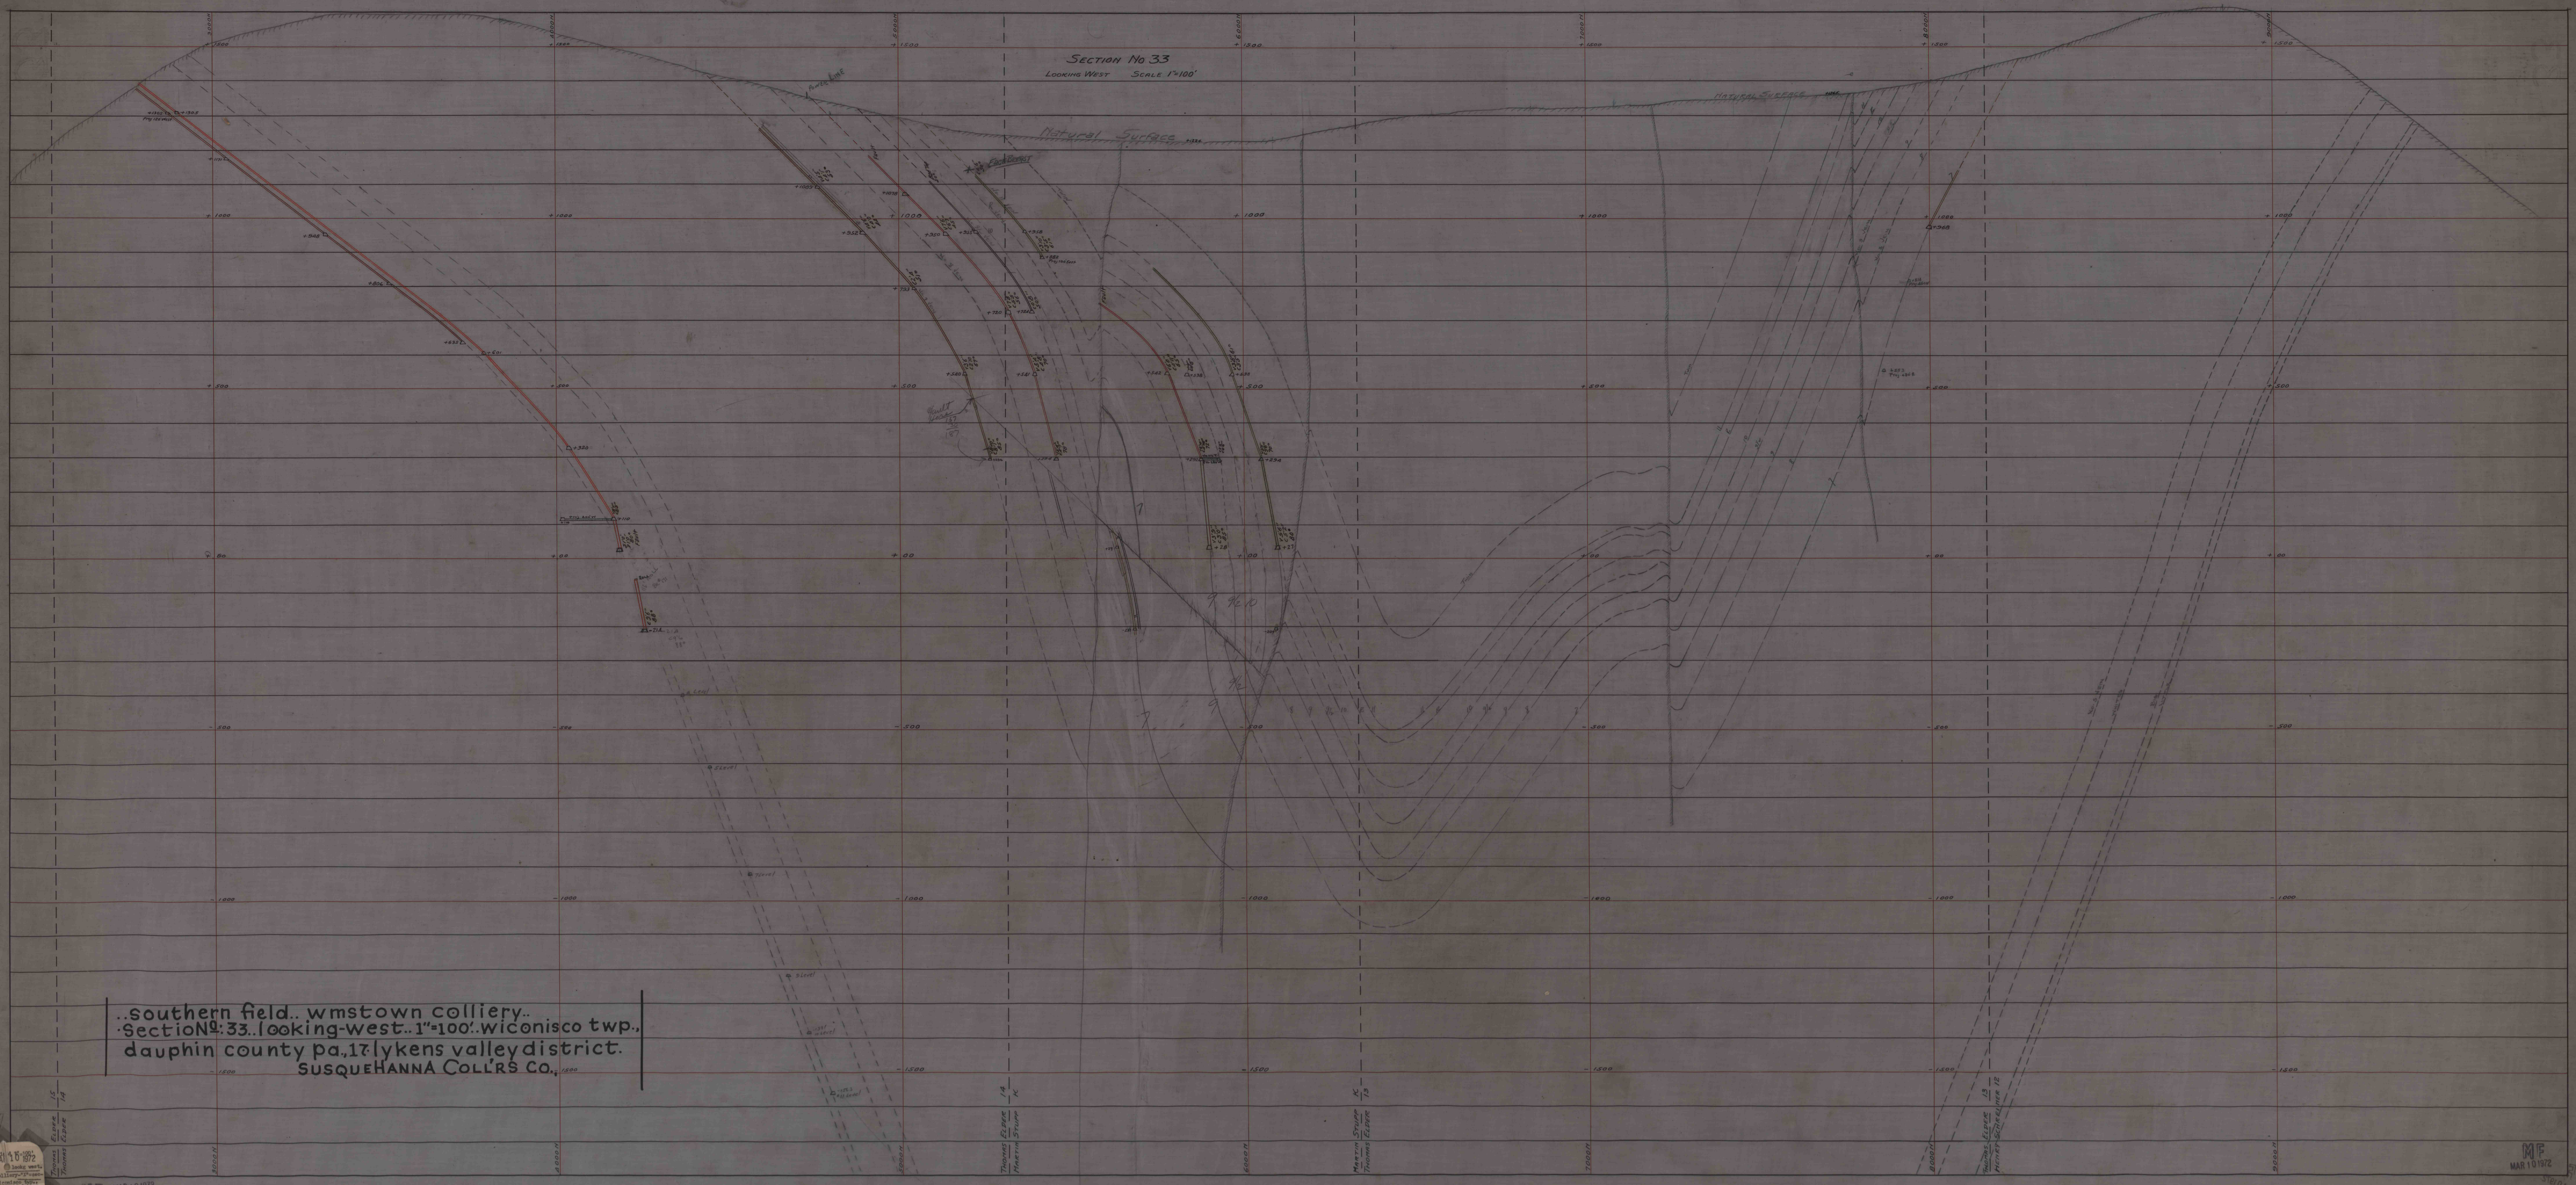

..southern field..wmstown colliery..
Section No 33..looking west..1"=100'..wiconisco twp.,
dauphin county pa,17 lykens valley district.
SUSQUEHANNA COLL'RS CO.