SOUTHERN COAL FIELD..WILLIAMSTOWN Colliery..
WICONISCO TWP., DAUPHIN COUNTY PA., 17 LYKENS VALLEY DIST. SECTION No. 43
SUSQUEHANNA COLLIERIES.
SCALE 1" = 100'

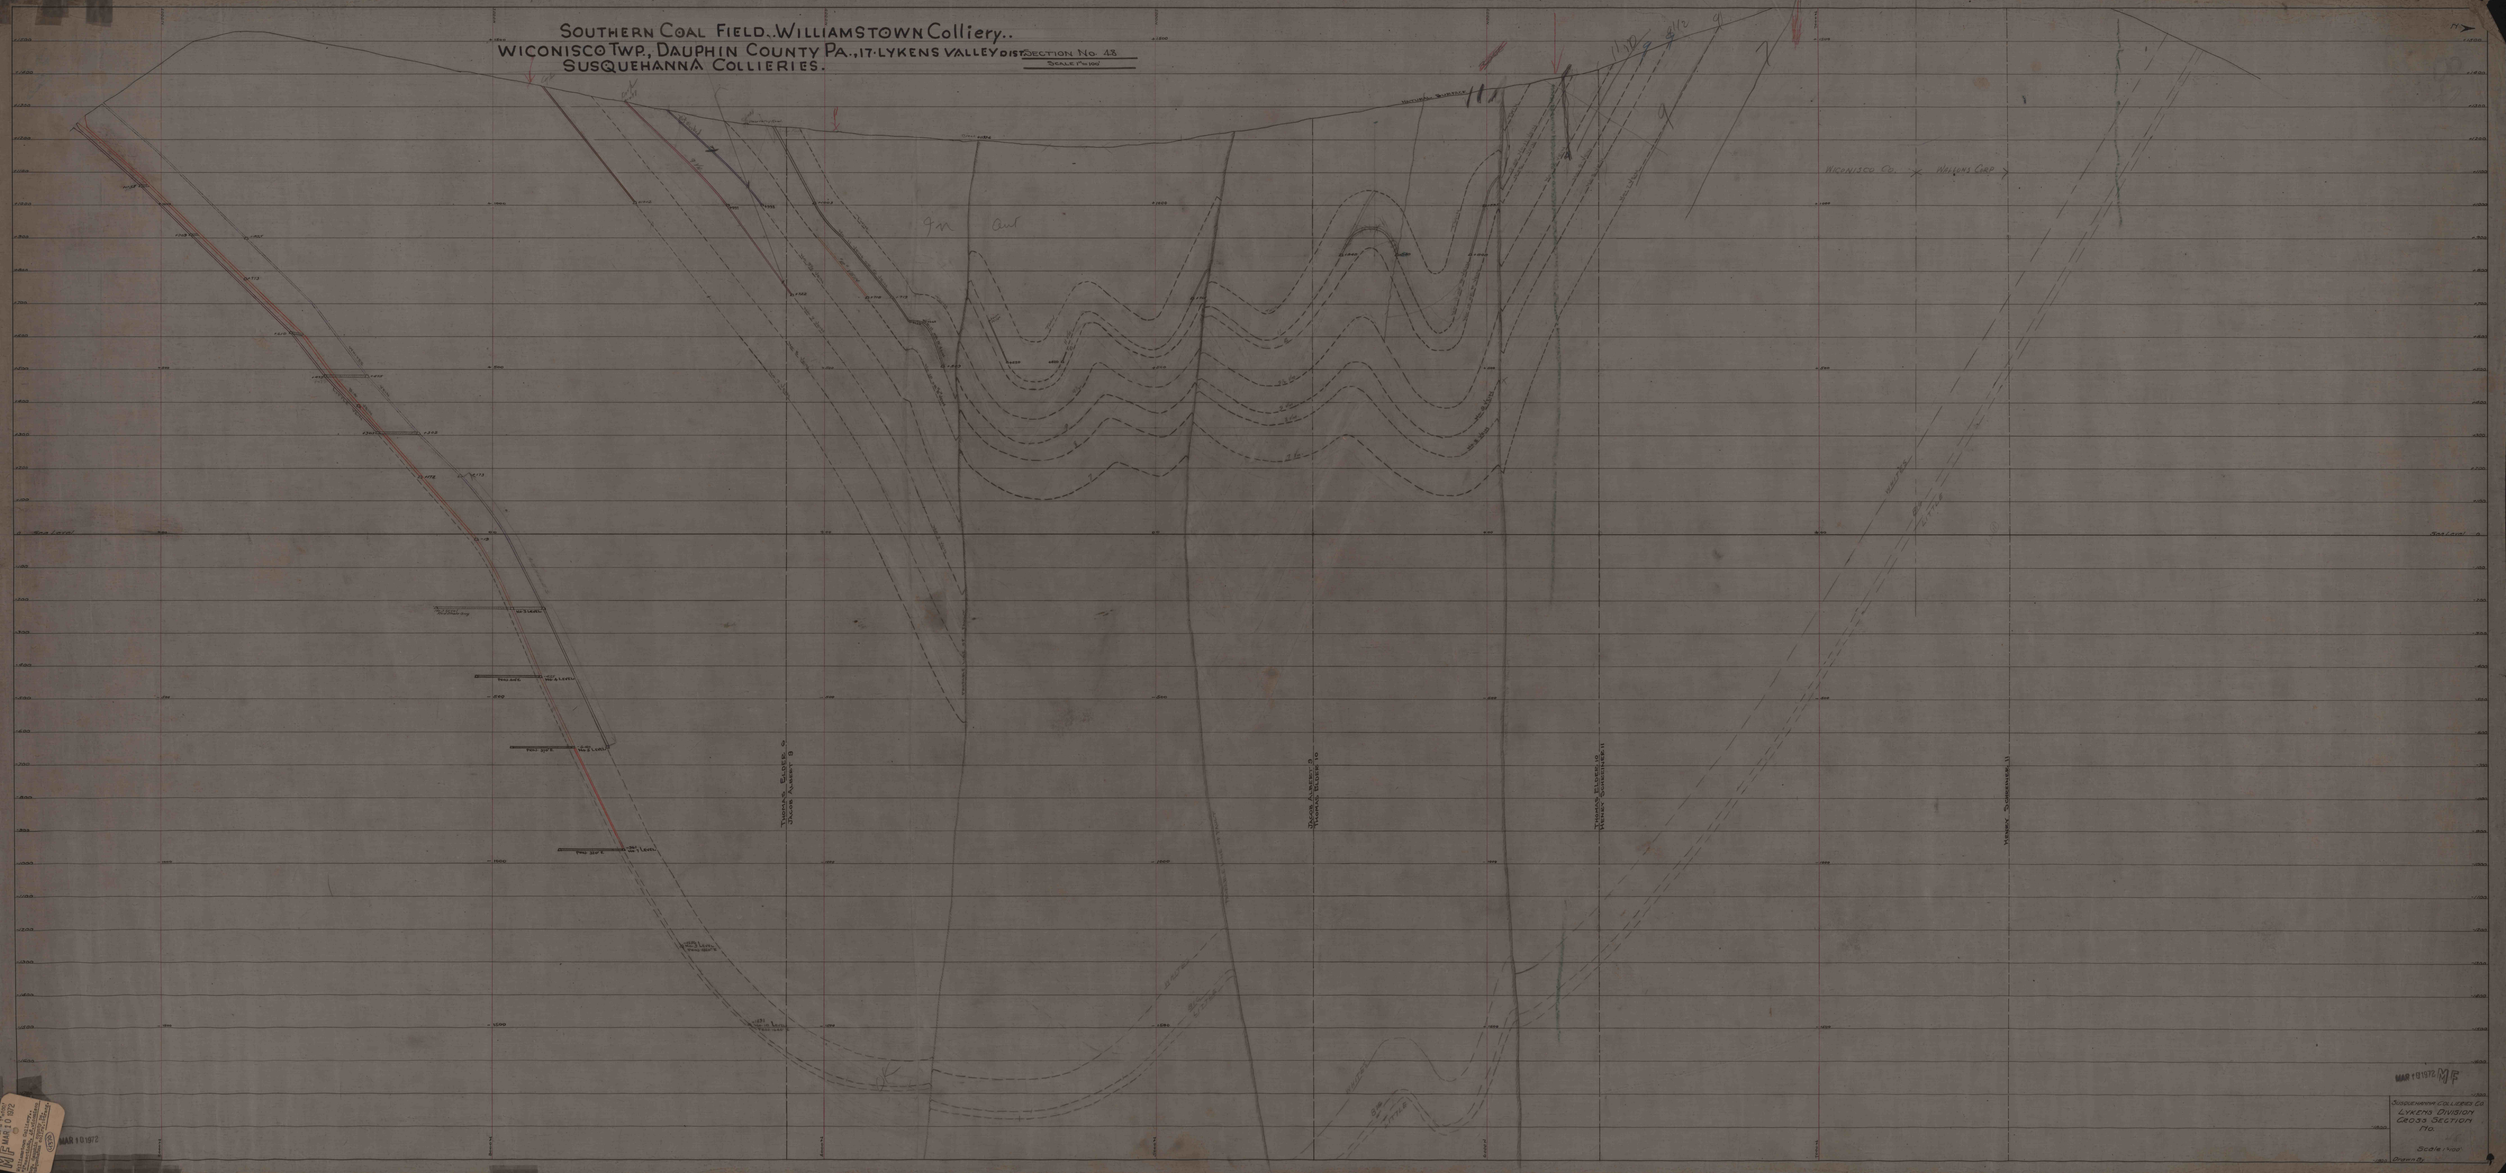

MAR 19 1972 MF

Susquehanna Collieries Co.
Lykens Division
Cross Section
No.
Scale 1:100
Drawn By

MAR 19 1972
