


SOUTHERN COAL FIELD

..SECTION NO 53..
..LOOKING WEST.. SCALE 1"=100'

WILLIAMSTOWN Colliery, WICONISCO
TWP, DAUPHIN COUNTY PA. SUSQ..
COLLIERIES.

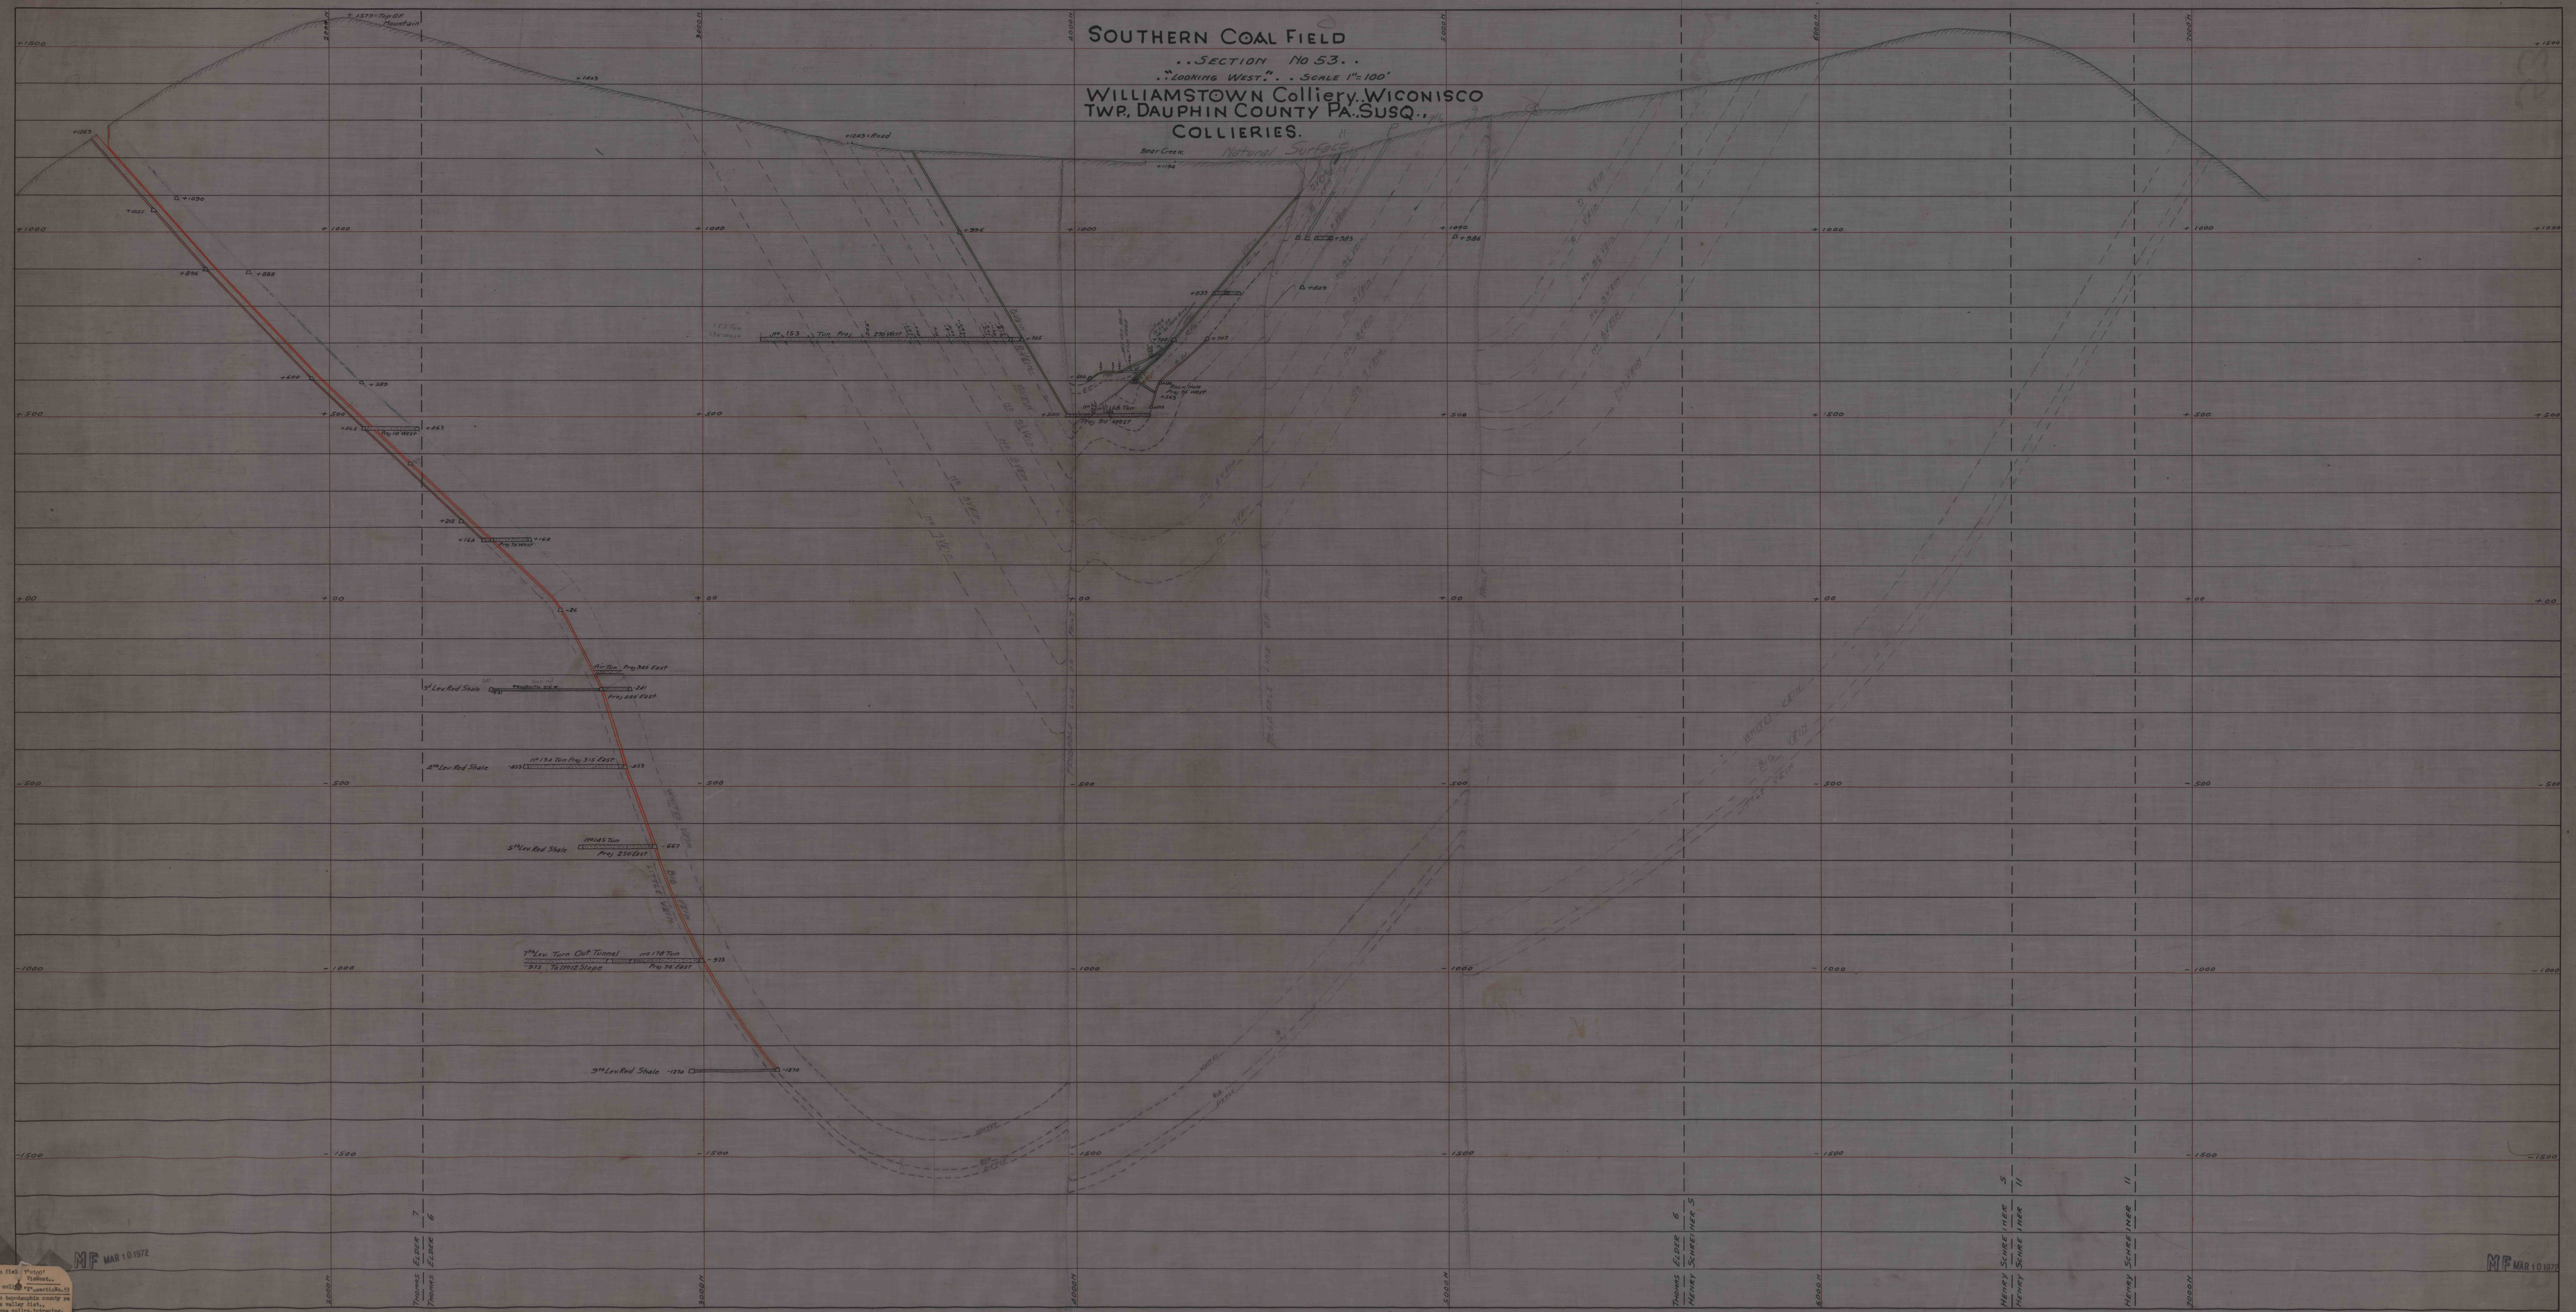

MP MAR 10 1972
4414 03

MP MAR 10 1972