


..southern coal field..
 wmstown colliery-wiconisco twp..
 dauphin county pa. 17 lykens valley
 district-susquehanna collr's.

\$ 75

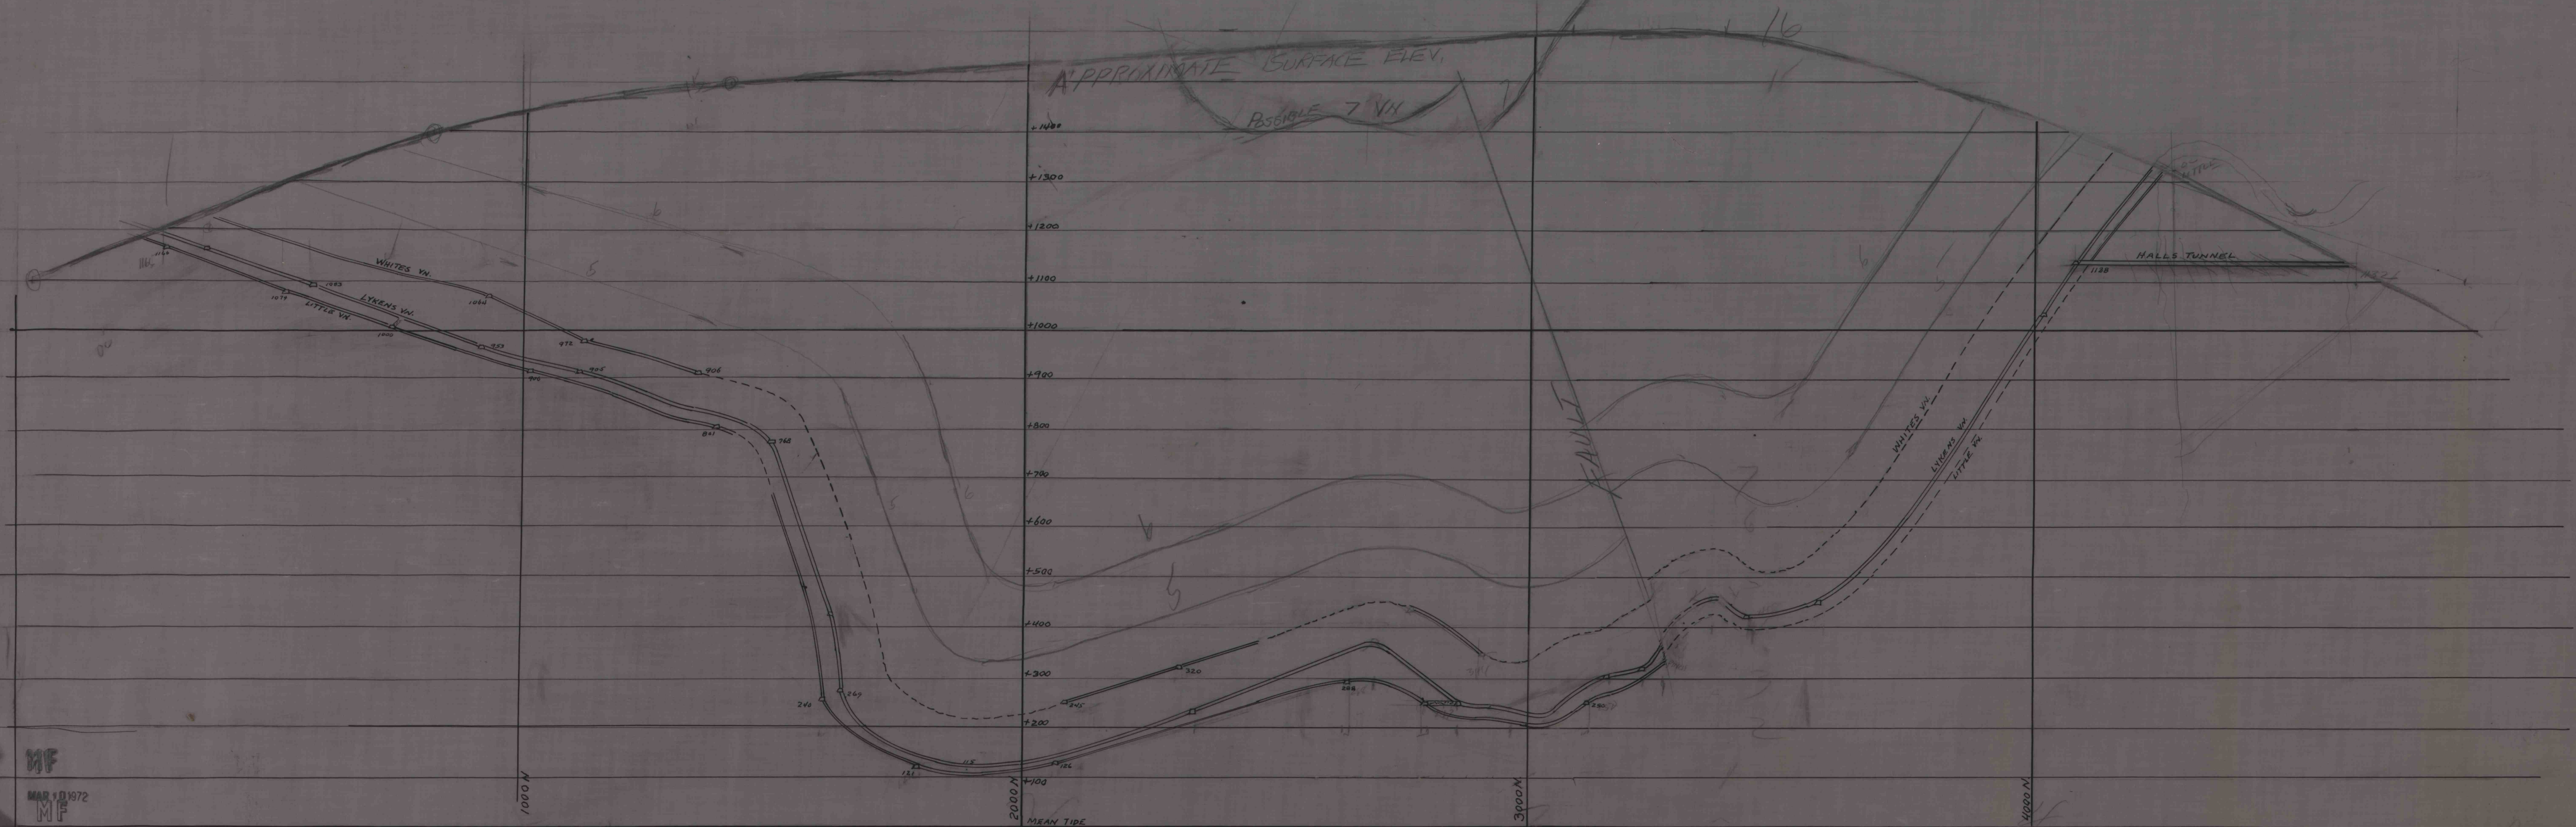

southern field
 10x10 1/2" x 1/2" 1"=100'
 Wmstown
 colly., 17 lykens valley
 dist., wiconisco twp.
 dauphin county pa.
 17 lykens valley dist.
 susquehanna collr's.
 tracing.
 441

MF

MAR 10 1972
 MF

700

1000