


.. SOUTHERN COAL FIELD..
WMS'TOWN COLLEY.. WICONISCO TWP.,
DAUPHIN COUNTY PA.. SUSQUEHANNA COLL'RS..

.. Cross Section No: 89..

.. Scale: 1"=100' ..

17-LYKENS VALLEY District.

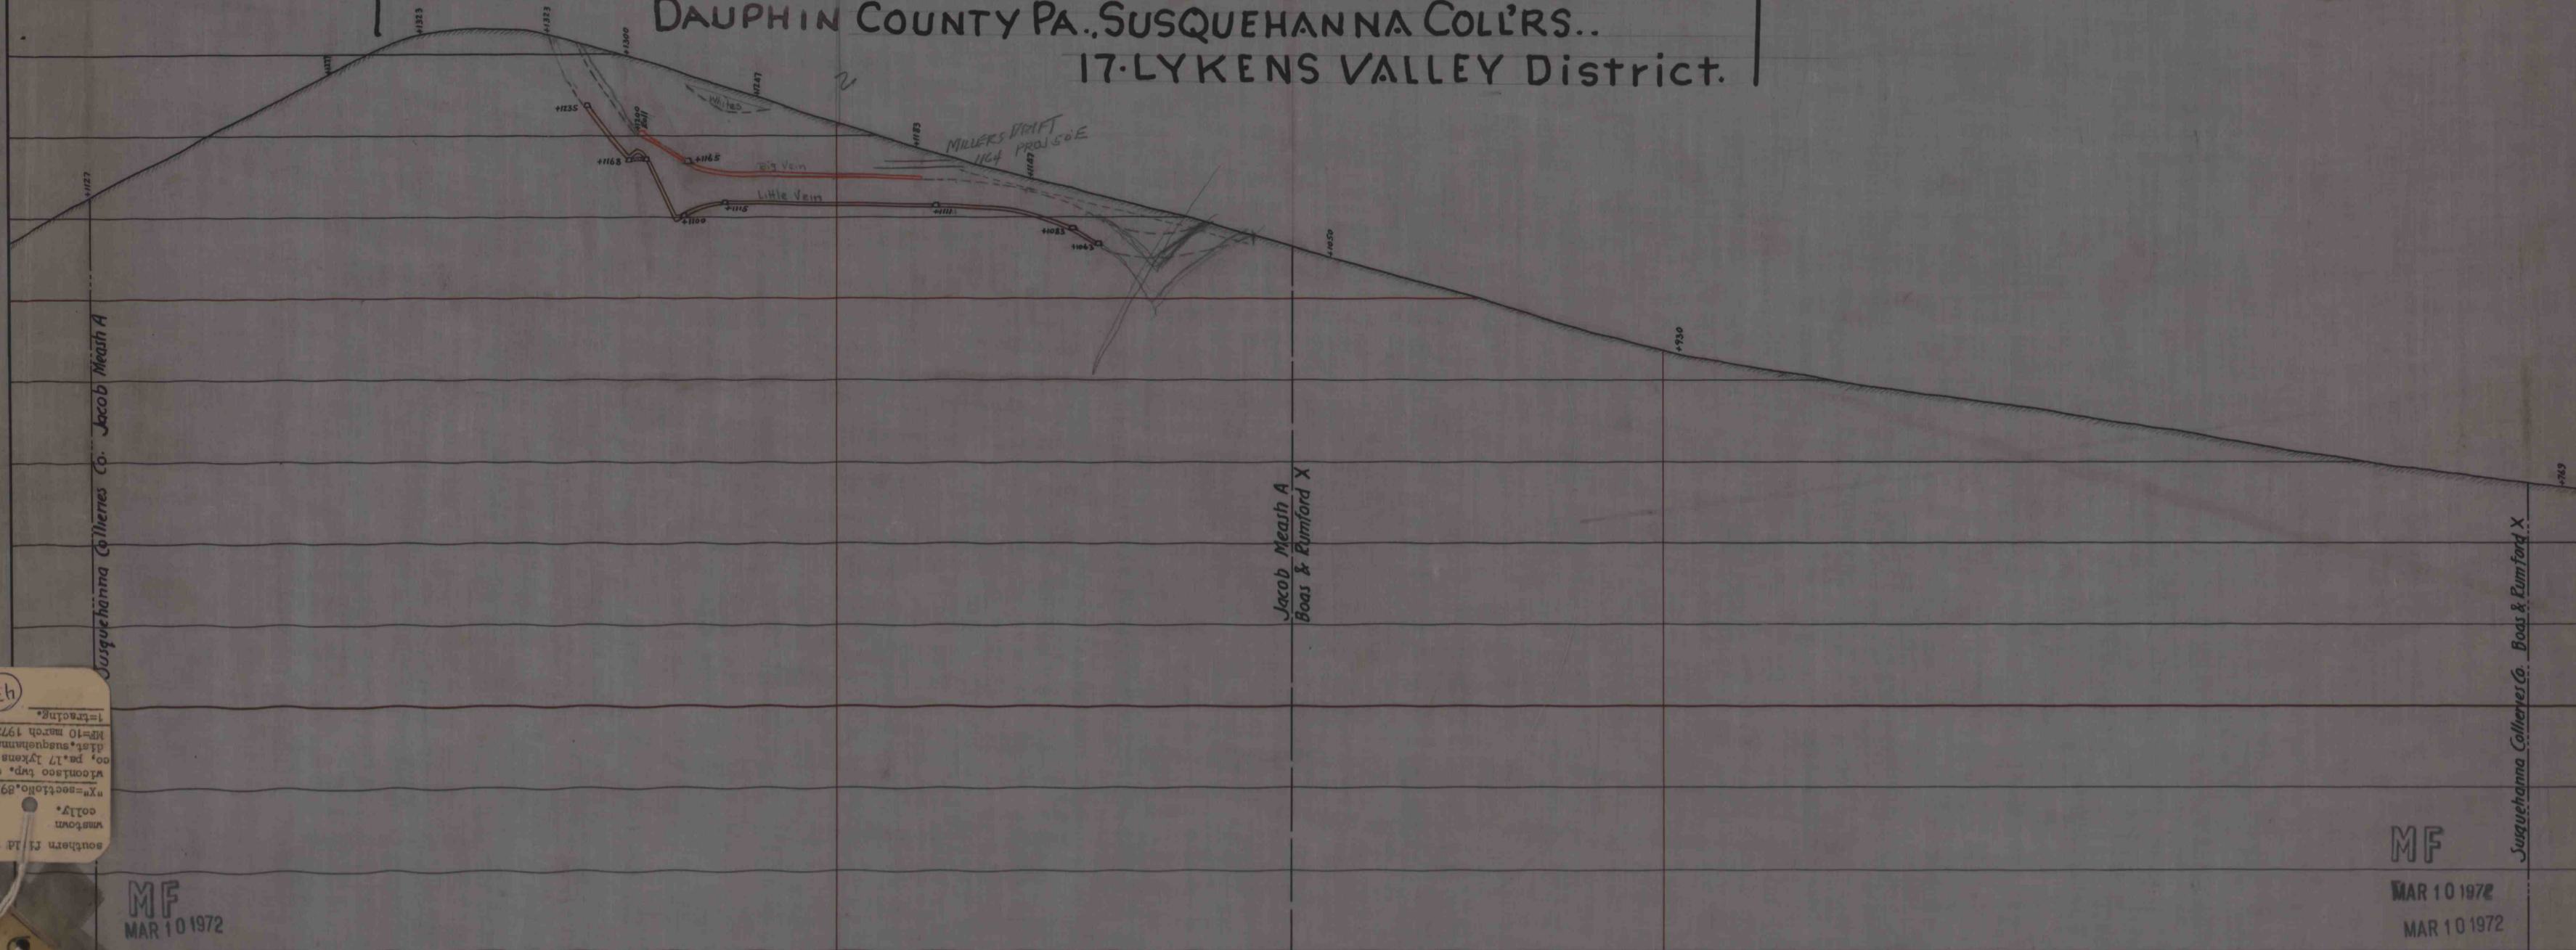

h347
 1"=100'
 Southern Coal Field
 Wms'town Colley
 "X"=section 89
 Wiconisco Twp. Dauphin
 Co., Pa. 17 Lykens Valley
 Dist. Susquehanna Colliers
 Co. March 1972, and
 1"=100'

MF
 MAR 10 1972

MF

MAR 10 1972
 MAR 10 1972

Susquehanna Colliers Co. Boas & Rumford X