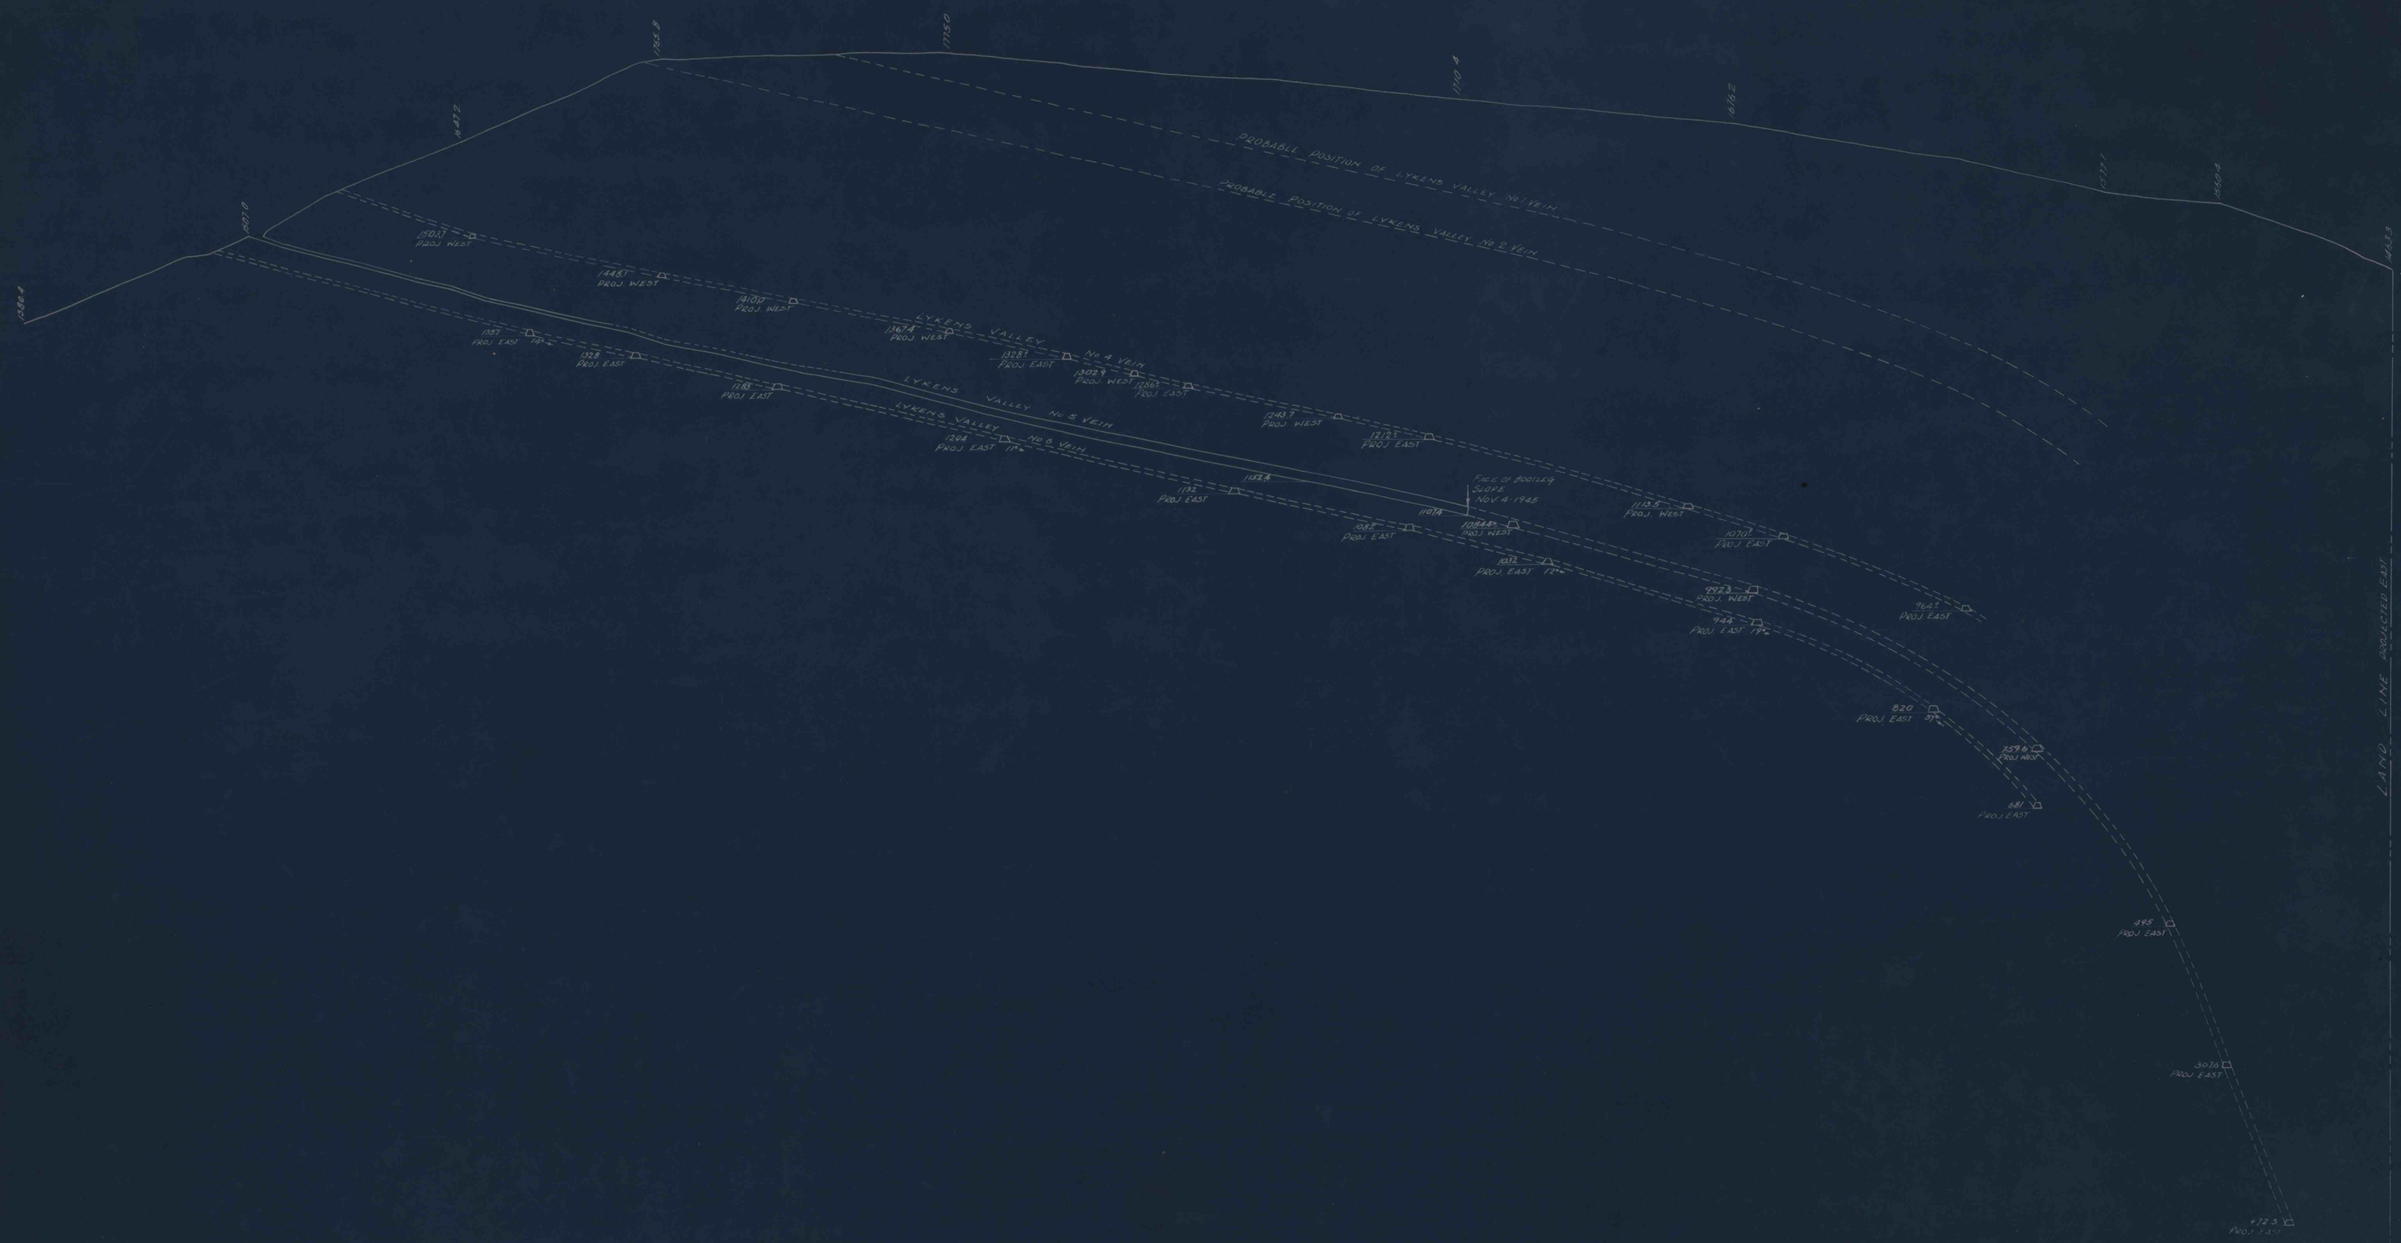

DATUM - MIDTIDE SECTION LOOKING WEST

CROSS SECTION THROUGH BARRIER PILLAR
BETWEEN
WILLIAMSTOWN AND BROOKSIDE COLLIERIES

SCALE 1" = 100 FT. NOVEMBER 4 - 1945

THOMAS J. LEWIS CONSULTING ENGINEER
FRACKVILLE PA.