


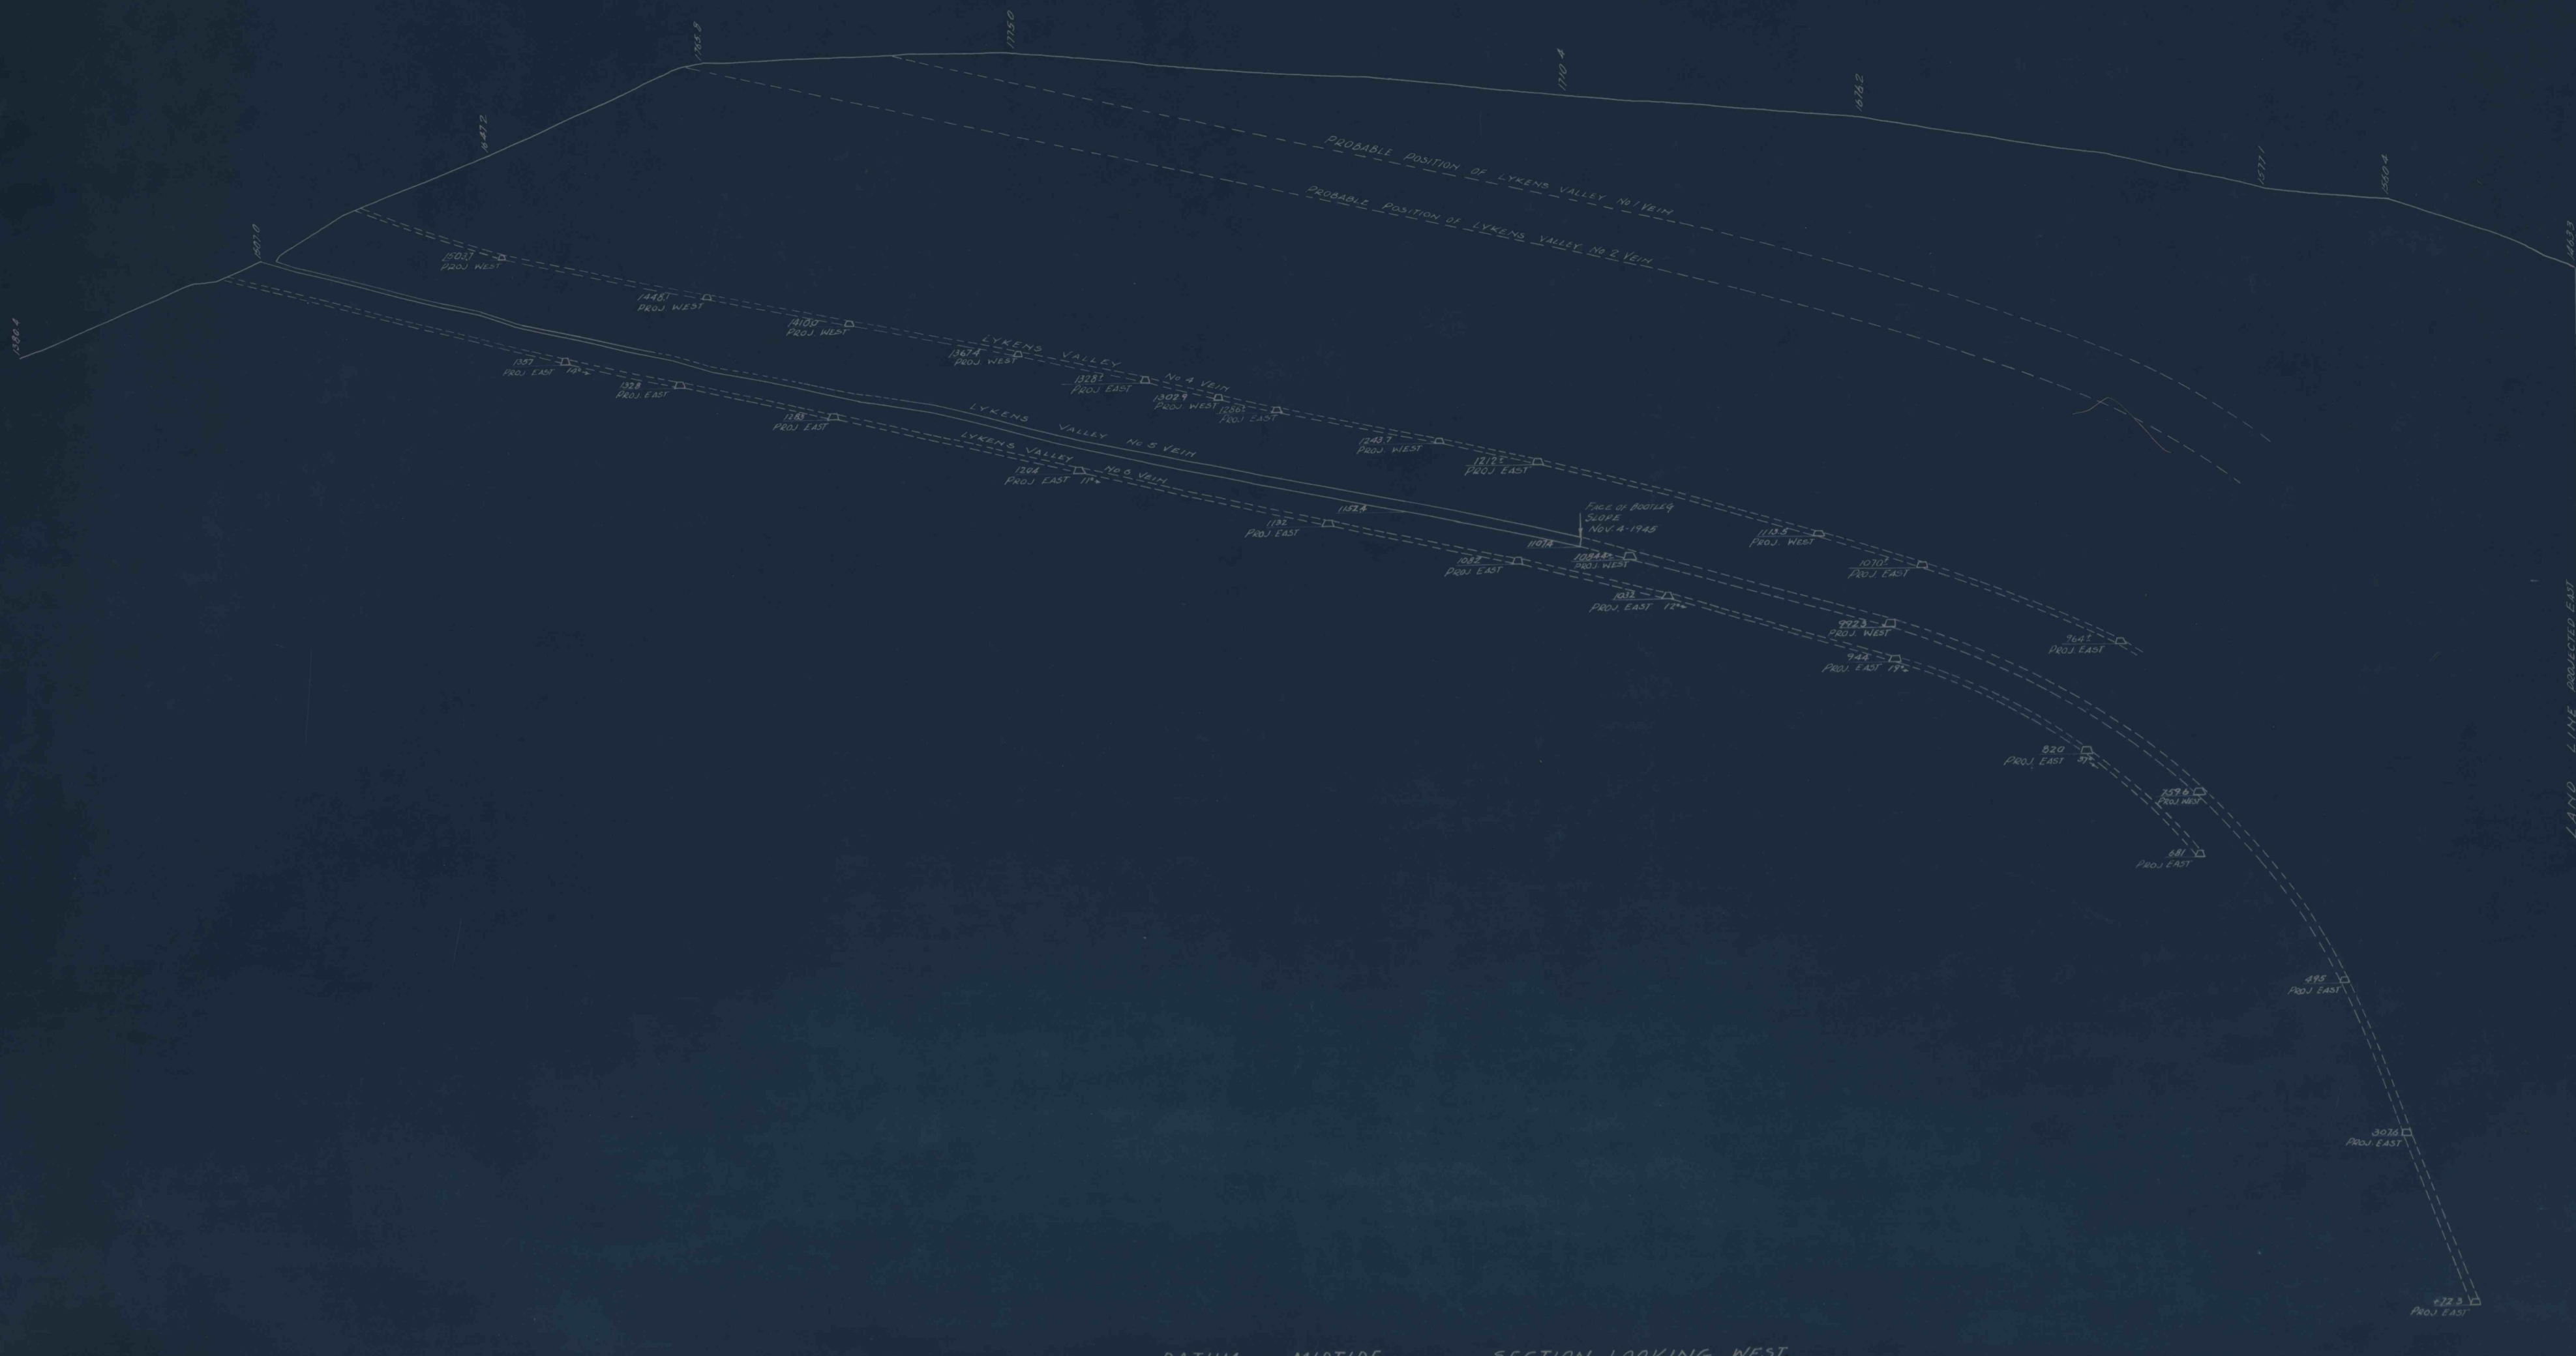

... DATUM - MDTIDE ... SECTION LOOKING WEST.

SOUTHERN COAL Field..
Wiconisco Twp, Dauphin County, PA..

CROSS SECTION THROUGH BARRIER PILLAR
 BETWEEN

WILLIAMSTOWN AND BROOKSIDE COLLIERIES

SCALE 1"=100 FT.

NOVEMBER 4-1945

THOMAS J. LEWIS CONSULTING ENGINEER

FRACKVILLE PA

SUSQUEHANNA COLLIERIES.

MF

MAR 10 1972

MAR 10 1972
 Southern MF
 section thru
 barrier pillar between
 Williamstown and
 Brookside collieries
 Wiconisco Twp, Dauphin
 County, Pa.
 dist. by Nov. 1945
 1 print.
 2 PLINTS