


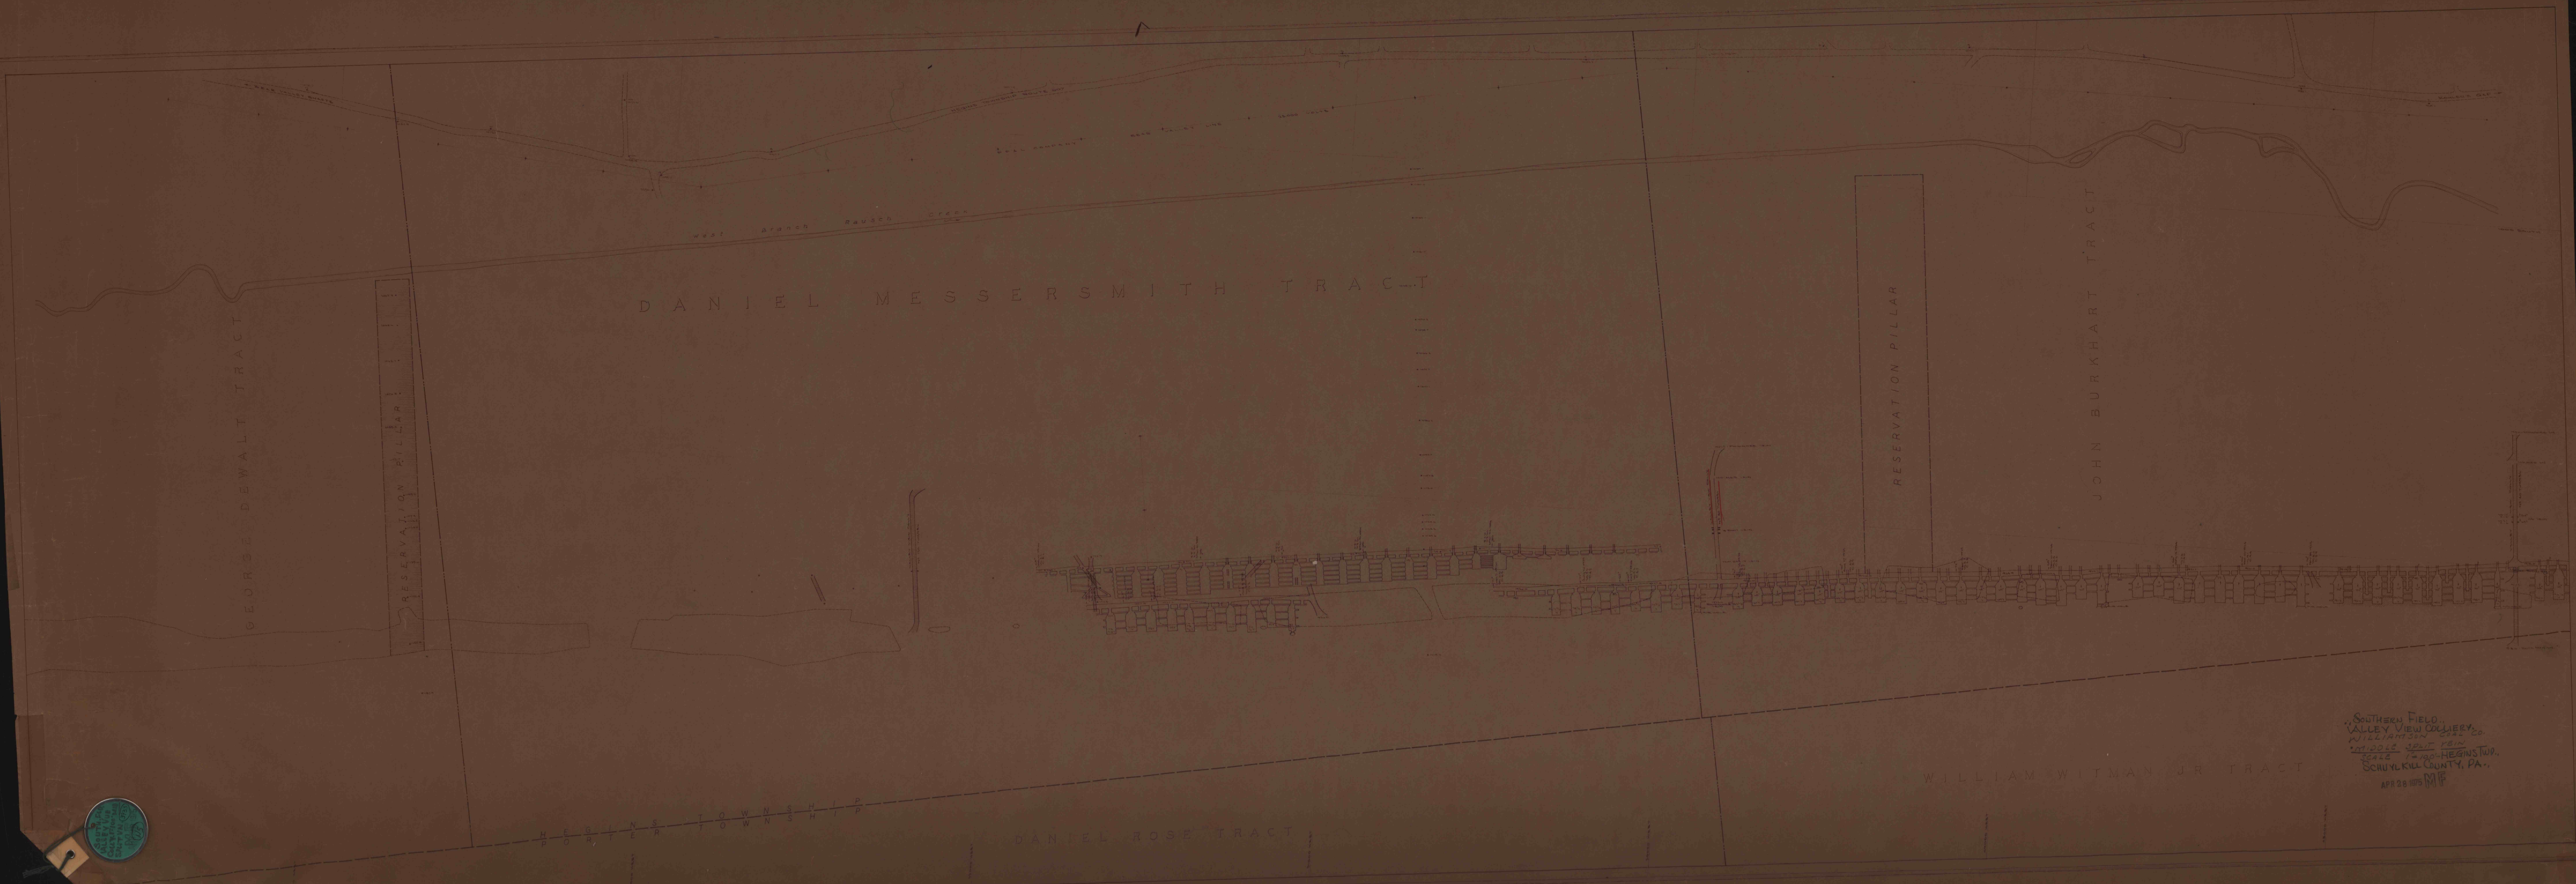

DANIEL MESSERSMITH TRACT

GEORGE DEWALT TRACT

RESERVATION PILLAR

RESERVATION PILLAR

JOHN BURKHART TRACT

DANIEL ROSE TRACT

WILLIAM WITMAN JR TRACT

SOUTHERN FIELD
WILLIAMSON CO.
SCHUYLKILL COUNTY, PA.
APR 28 1875