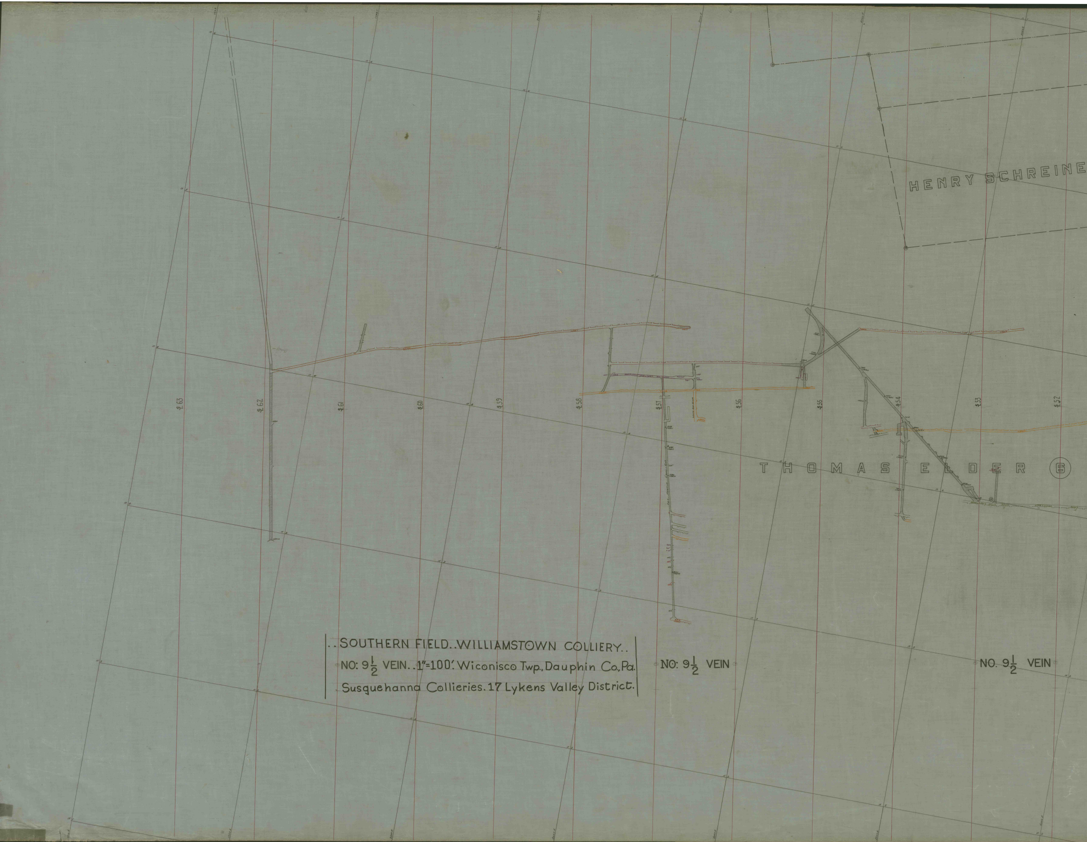
HENRY SCHREINE
THOMAS ELDER ⑥
S 63
S 62
S 61
S 60
S 59
S 58
S 57
S 56
S 55
S 54
S 53
S 52
NO: 9½ VEIN
NO. 9½ VEIN

..SOUTHERN FIELD..WILLIAMSTOWN COLLIERY..
NO: 9½ VEIN..1"=100'. Wiconisco Twp., Dauphin Co. Pa.
Susquehanna Collieries. 17 Lykens Valley District.

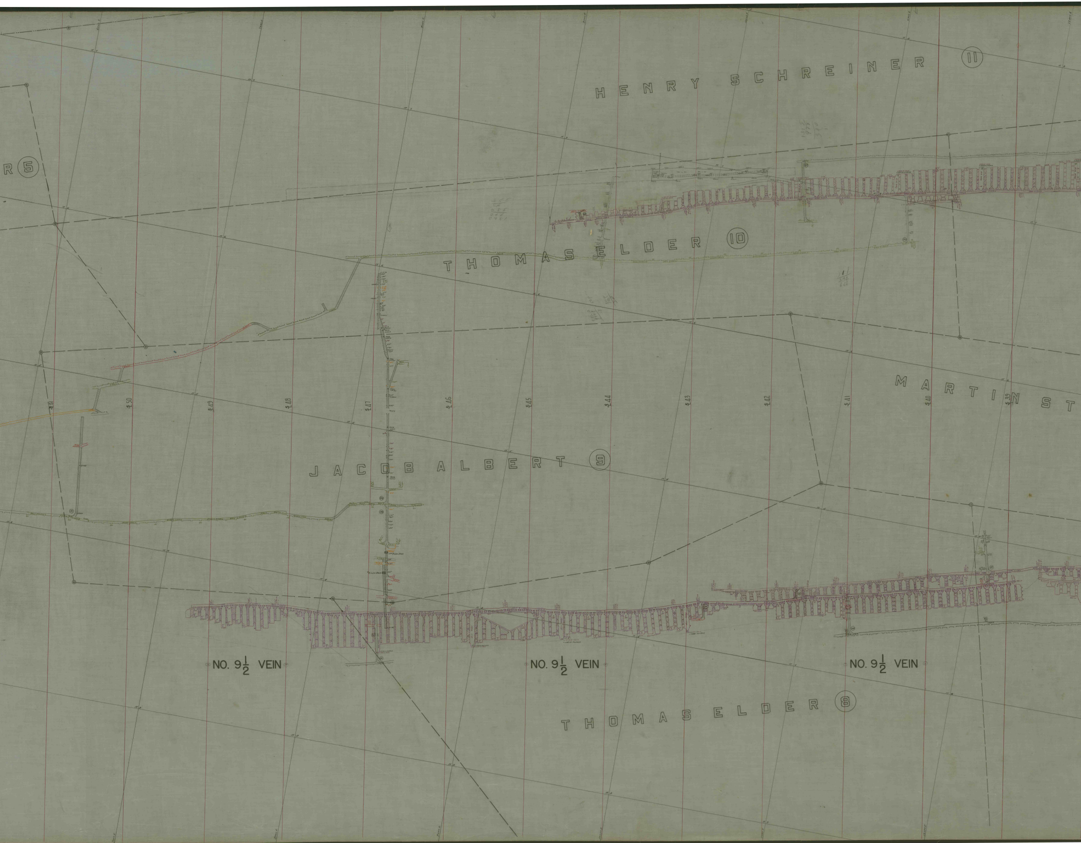

HENRY SCHREINER ⑪
R ⑤
THOMAS ELDER ⑩
JACOB ALBERT ⑨
MARTIN ST
℄ 51
℄ 50
℄ 49
℄ 48
℄ 47
℄ 46
℄ 45
℄ 44
℄ 43
℄ 42
℄ 41
℄ 40
℄ 39
NO. 9½ VEIN
NO. 9½ VEIN
NO. 9½ VEIN
THOMAS ELDER ⑧

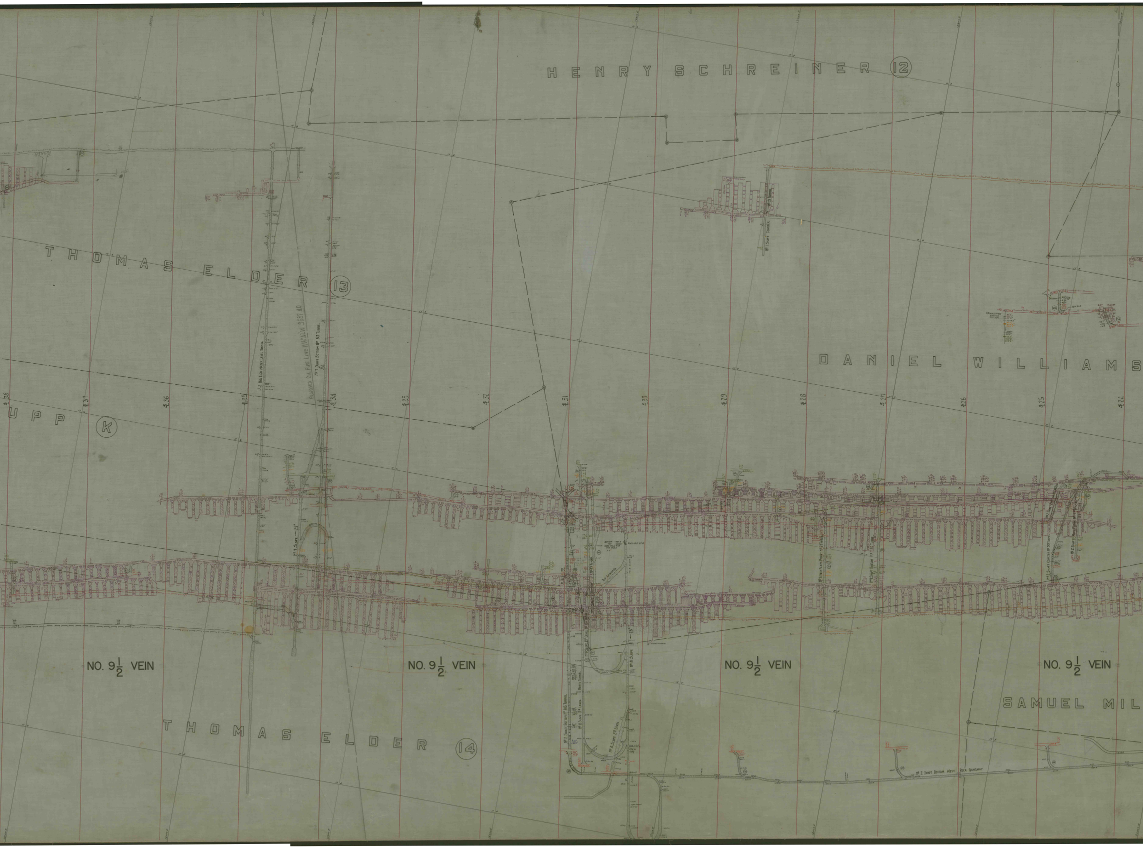
HENRY SCHREINER ⑫
THOMAS ELDER ⑬
DANIEL WILLIAMS
UPP Ⓚ
38
37
36
35
34
33
32
31
30
29
28
27
26
25
24
NO. 9½ VEIN
NO. 9½ VEIN
NO. 9½ VEIN
NO. 9½ VEIN
SAMUEL MIL
THOMAS ELDER ⑭

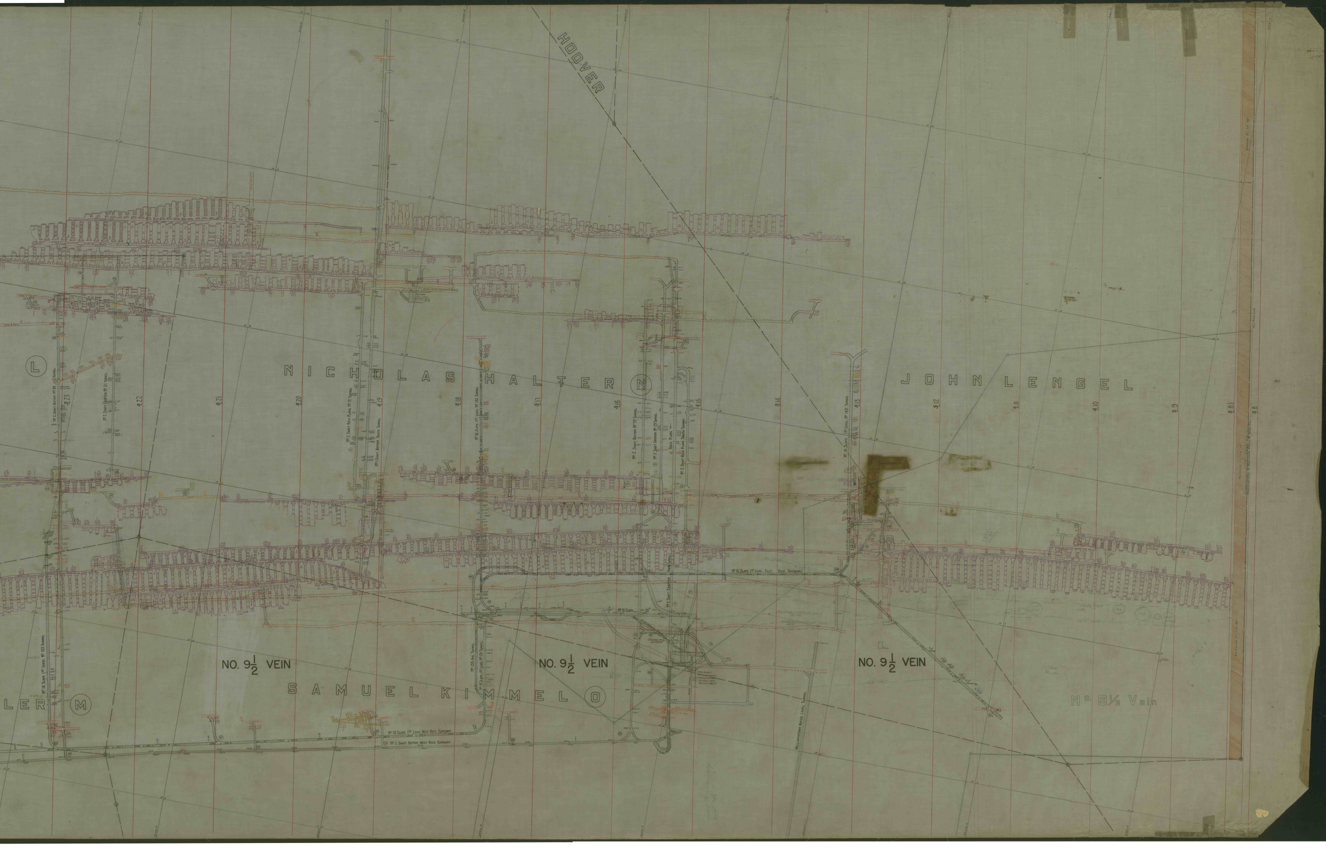
HOOVER
NICHOLAS HALTER
N
JOHN LENGEL
L
LER
M
SAMUEL KIMMEL
O
NO. 9½ VEIN
NO. 9½ VEIN
NO. 9½ VEIN
No 9½ Vein
§23
§22
§21
§20
§19
§18
§17
§16
§15
§14
§13
§12
§11
§10
§9
§8½
§8
No 10 Slope 1st Level No 153 Tunnel
No 2 Shaft Bottom No 85 Tunnel
No 2 Shaft Counter No 85 Tunnel
No 2 Shaft Rock Plane No 31 Tunnel
No 1 Shaft Bottom South Tunnel
No 10 Slope 1st Level No 132 Tunnel
No 153 Air Tunnel
No 10 Slope 1st Level No 133 Tunnel
No 2 Shaft Bottom No 79 Tunnel
No 2 Shaft Counter No 29 Tunnel
Rock Plane
No 2 Shaft Rock Plane South Tunnel
No 2 Shaft Counter
No 10 Slope 1st Level No 149 Tunnel
No 10 Slope 1st Level East Rock Gangway
No 10 Slope
No 10 Slope 1st Level West Rock Gangway
No 2 Shaft Bottom West Rock Gangway
Williamstown Water Level Tunnel