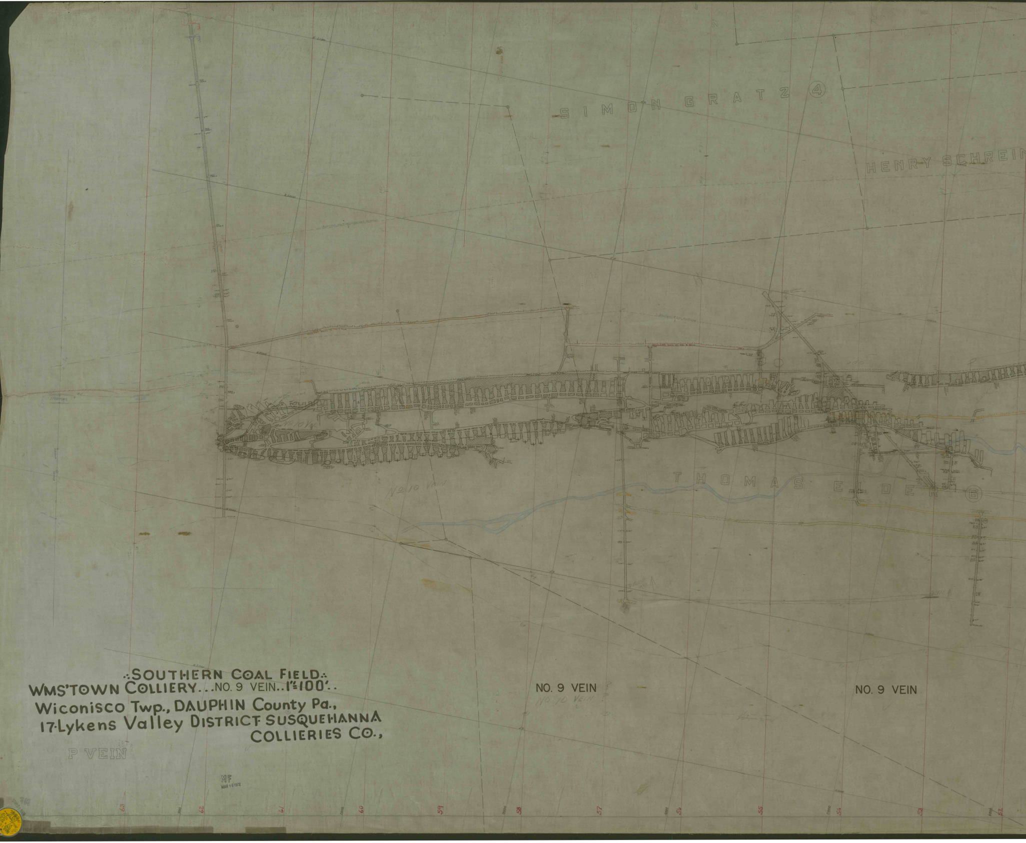
SIMON GRATZ ④
HENRY SCHREIN
THOMAS ELDER ⑥
No 10 Vn
No 10 Vein
NO. 9 VEIN
No 10 Vein ?
NO. 9 VEIN
P VEIN
63
62
61
60
59
58
57
56
55
54
53
52

∴SOUTHERN COAL FIELD∴
WMS'TOWN COLLIERY...NO. 9 VEIN..1"=100'..
Wiconisco Twp., DAUPHIN County Pa.,
17·Lykens Valley DISTRICT· SUSQUEHANNA
COLLIERIES CO.,

MF
MAR 10 1972

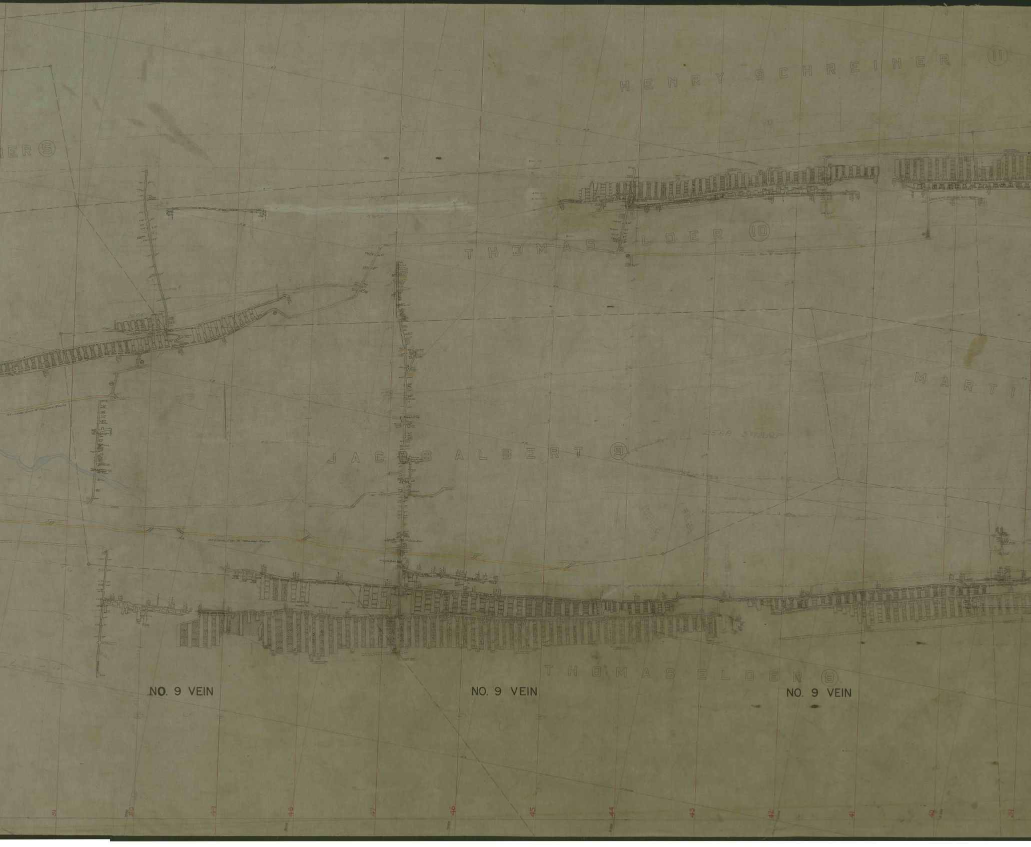
ER ⑤
HENRY SCHREINER ⑪
THOMAS ELDER ⑩
MARTI
BEAR SWAMP
JACOB ALBERT ⑨
THOMAS ELDER ⑧
NO. 9 VEIN
NO. 9 VEIN
NO. 9 VEIN
51
50
49
48
47
46
45
44
43
42
41
40
39

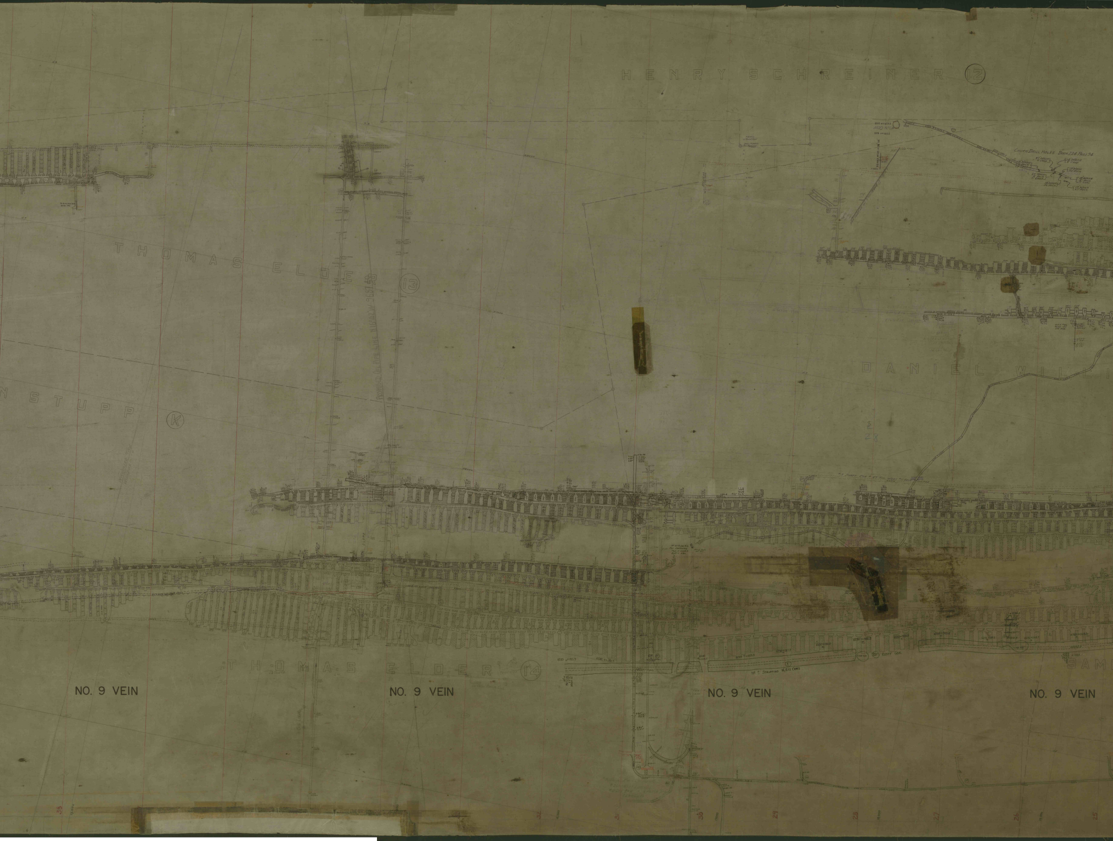
HENRY SCHREINER ⑫
CHURN DRILL HOLES BOOK 224 PAGE 94
27' WASH 2' CROP
5½' WASH 2' CROP
15' WASH 3.5' ROCK
18' WASH 3' ROCK 3' COAL
15' WASH 6.7' ROCK
25' WASH 2' ROCK 11' CROP
18' WASH 3.6' ROCK
THOMAS ELDER ⑬
N STUPP Ⓚ
DANIEL WILL
THOMAS ELDER ⑭
SAM
No 2 STRIPPING 16,511 CARS
NO. 9 VEIN
NO. 9 VEIN
NO. 9 VEIN
NO. 9 VEIN

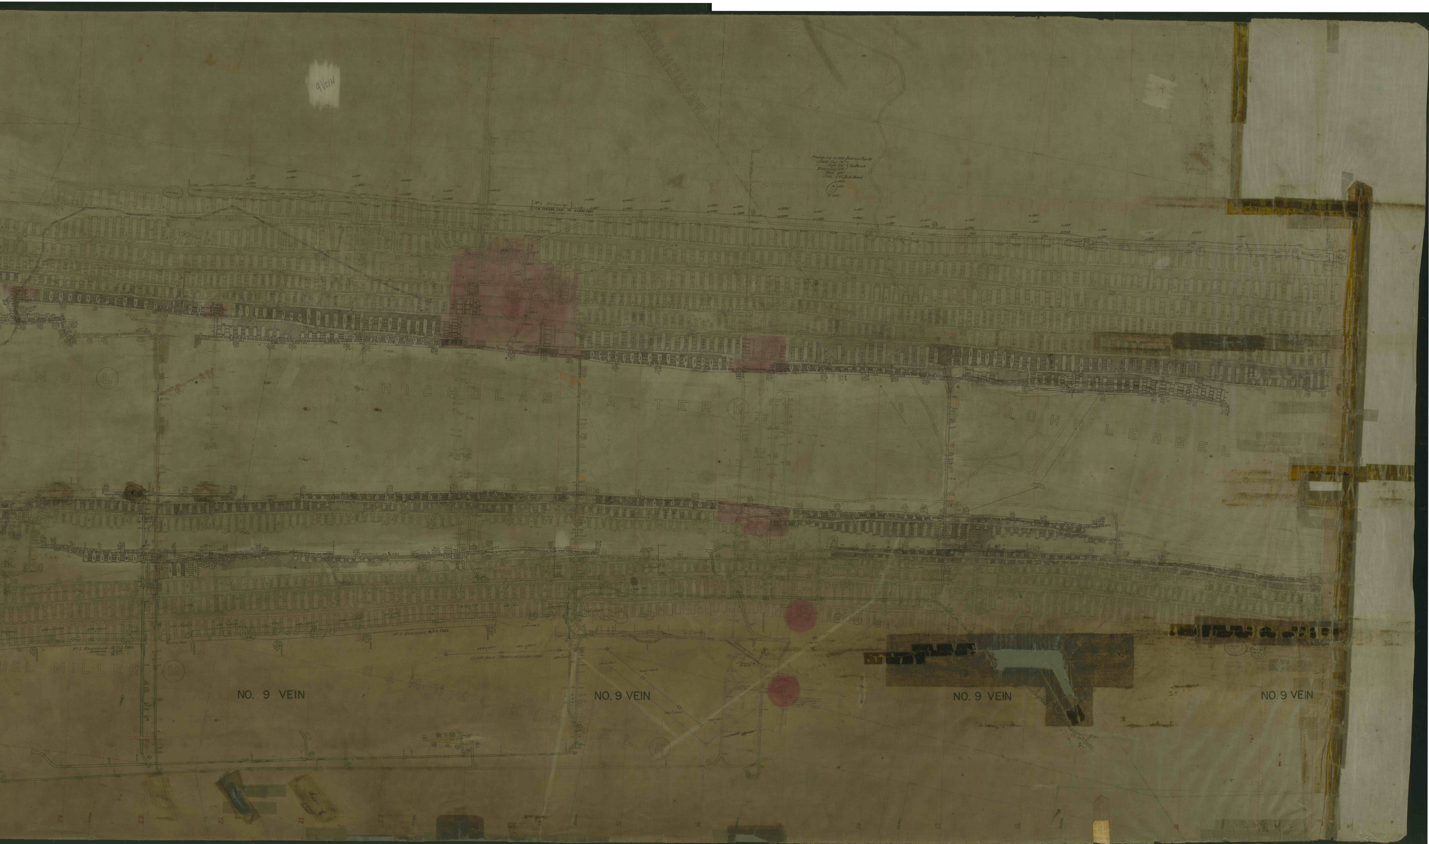
9 VEIN
JOHN HOOVER
Proving July 19, 1934 Book 33A Page 63
Shelly Coal 7'6"
Slate 0'6"
Top Bench
Dirty Coal 4'8"
Rock 4'0"
Coal 3'0" Bott. Bench
No 1 Stripping
12,778 STACKER CARS OR 23,800 CARS
AMS L
NICHOLAS HALTER N
JOHN LENGEL
No 2 STRIPPING 13,863 CARS
" DEEPENING 2,648 "
TOTAL 16,511 "
RUSTY COAL
No 2 STRIPPING 16,511 CARS
22,000 VOLT TRANSMISSION LINE
UEL MILLER M
SAMUEL KIMMEL
NO. 9 VEIN
NO. 9 VEIN
NO. 9 VEIN
NO. 9 VEIN