


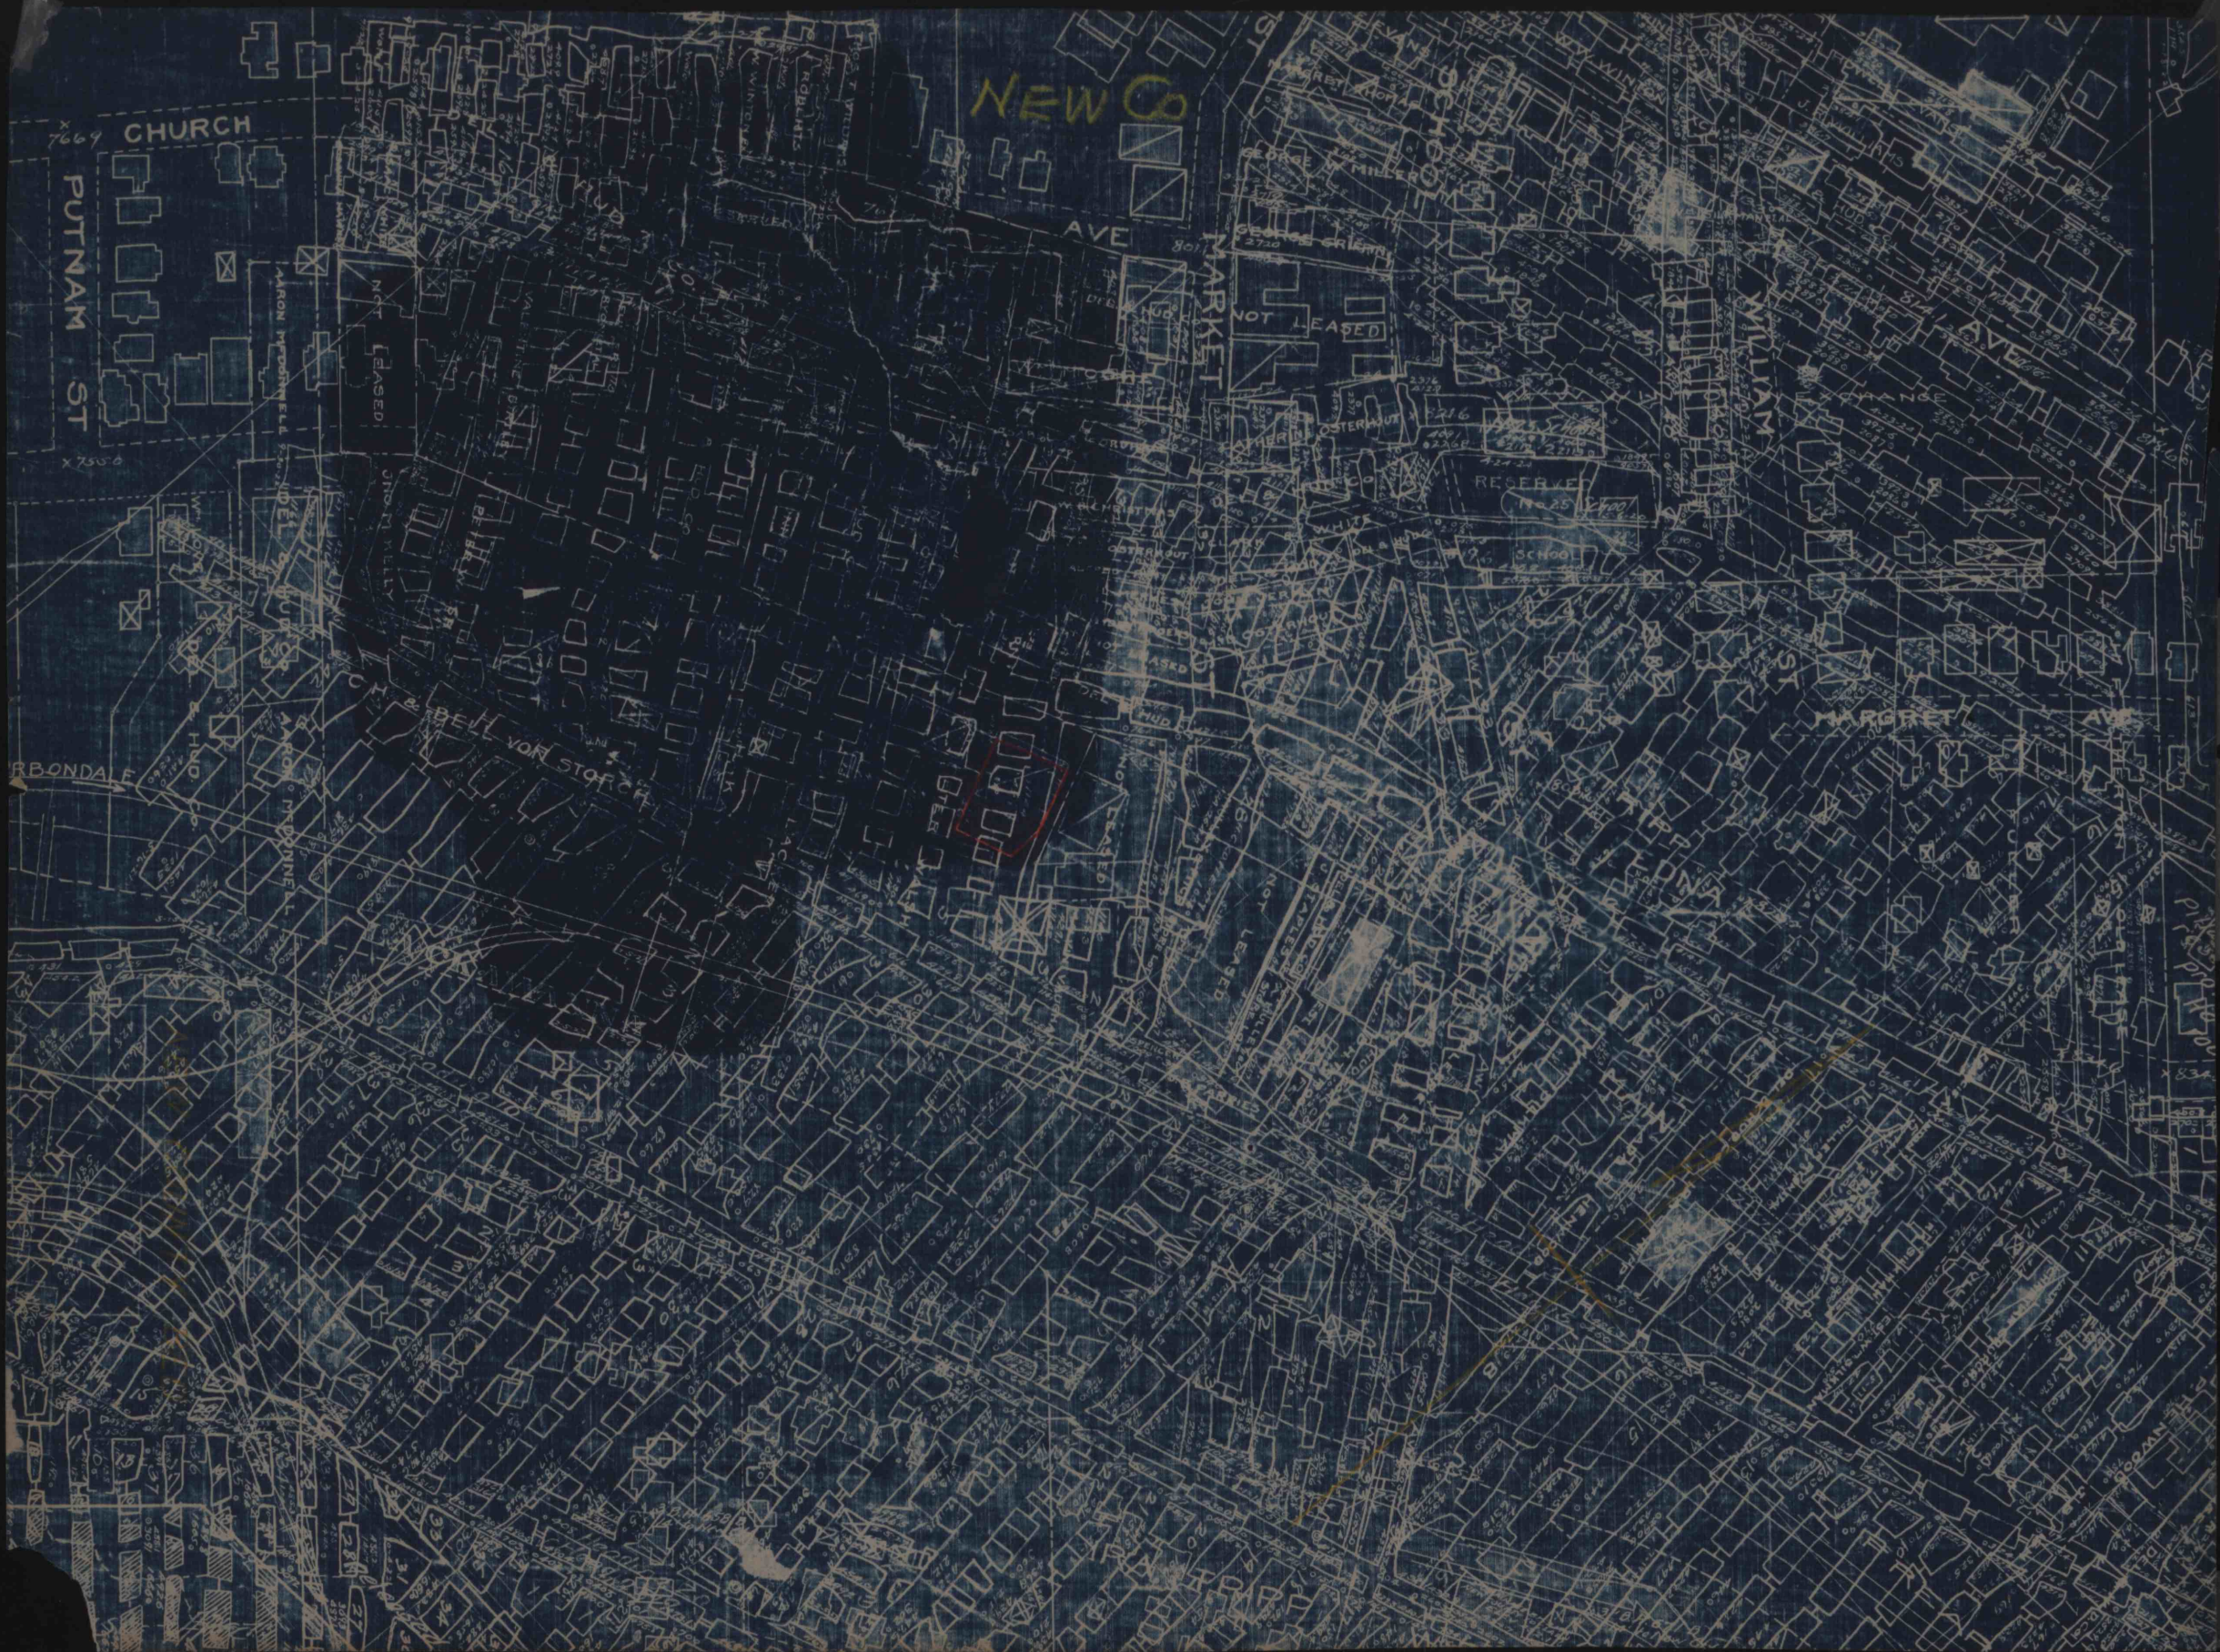

NEW CO

CHURCH

POTNAM ST

X 750' 0"

AVE

MARKET

NOT LEASED

WILLIAM

ST

MARGARET

RBONDALF

REBEL VOR STOR

RESERVE

NO 25

SCHOOL




















