


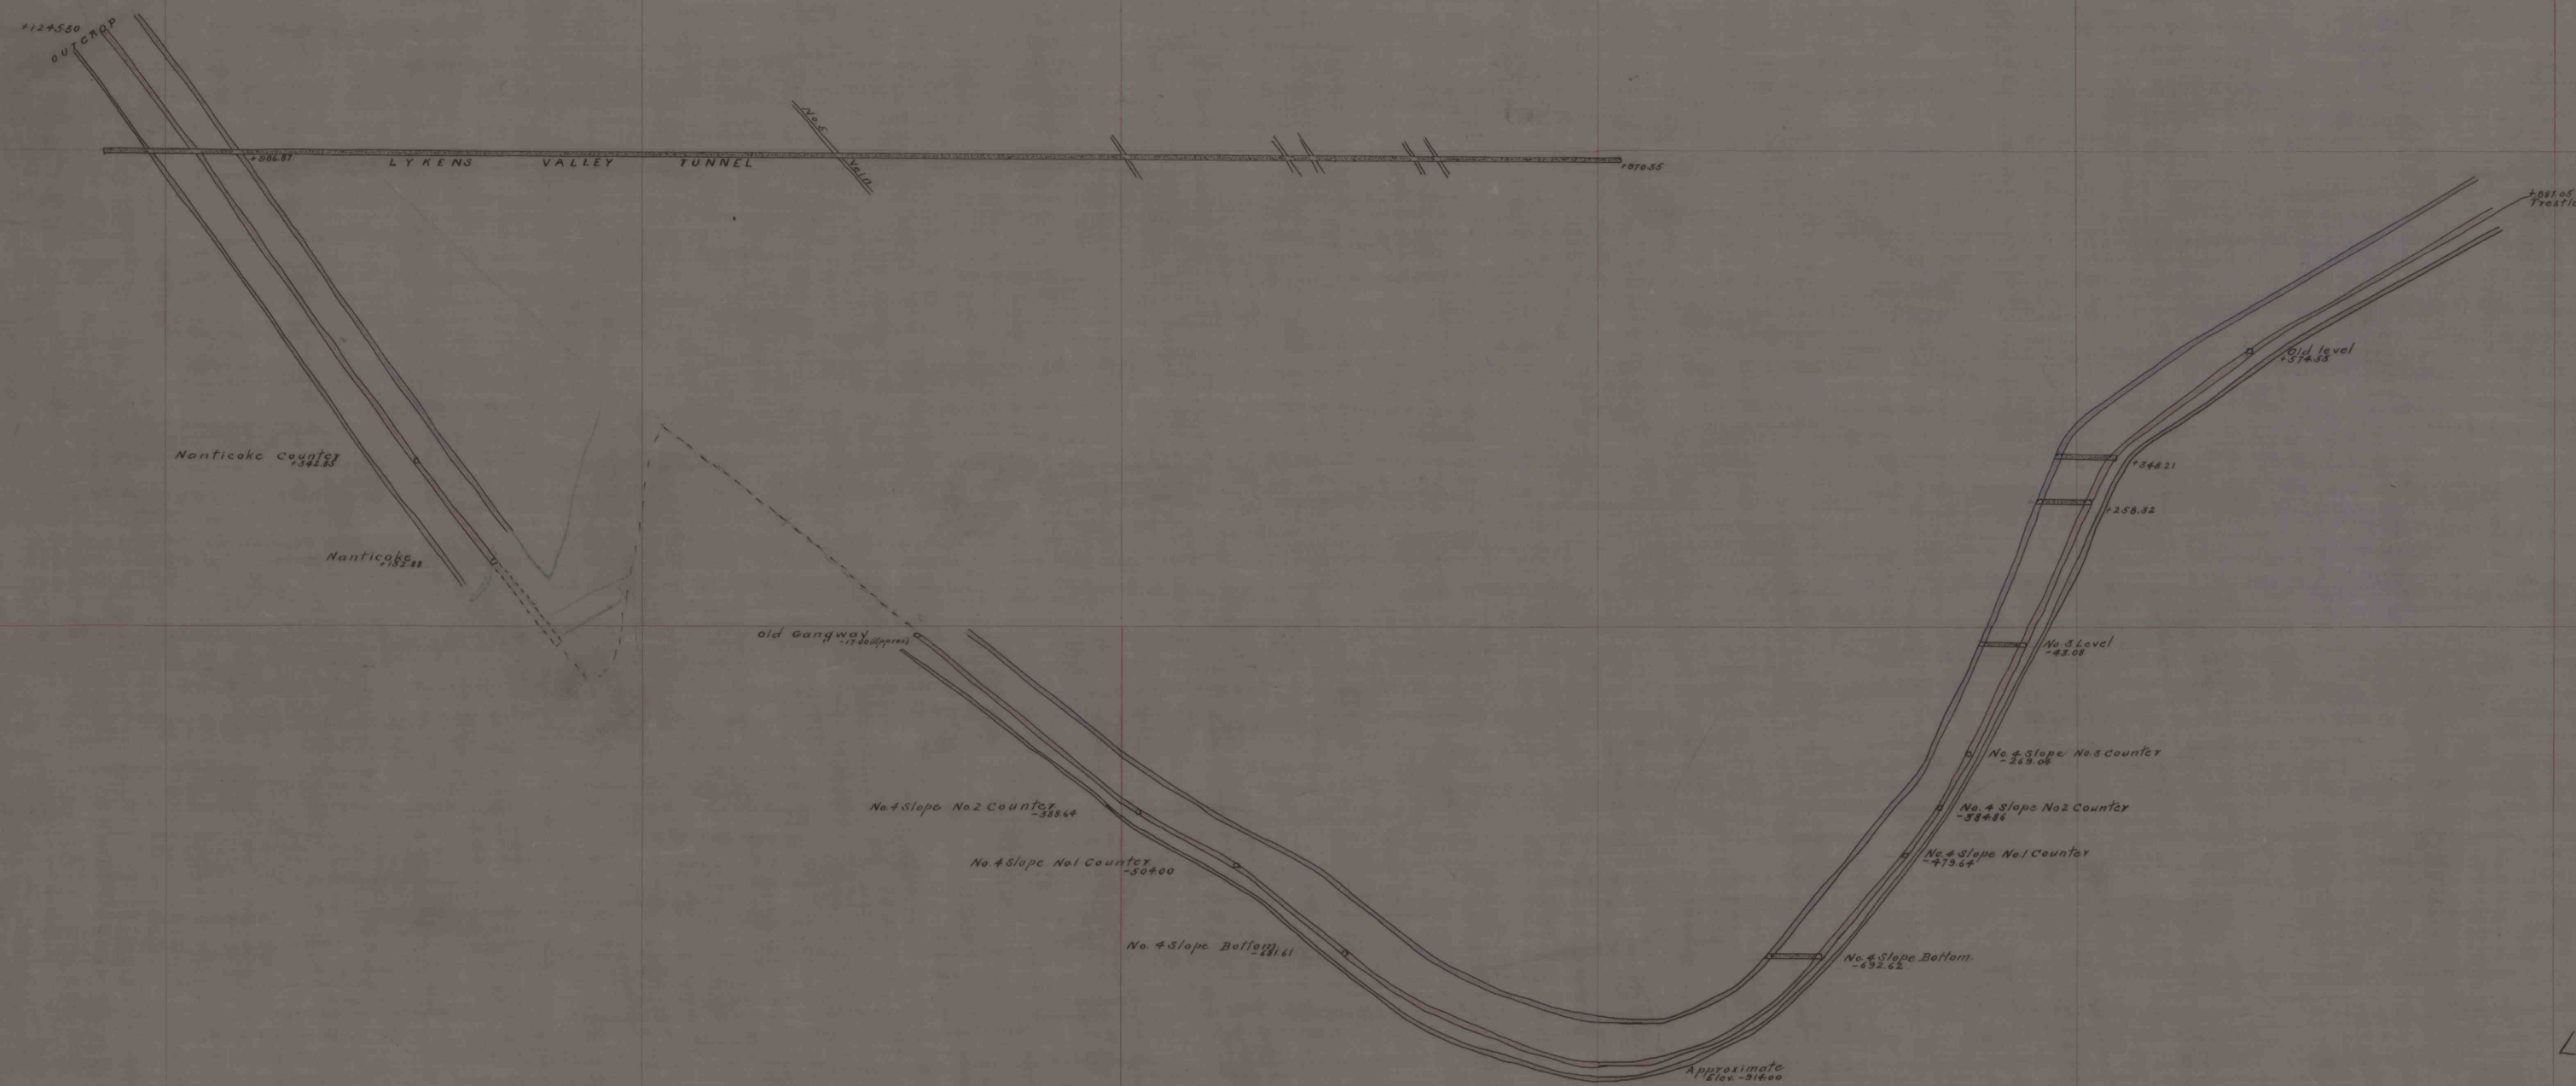

SECTION
 through
 LYKENS VALLEY SLOPE
 and
 BEAR GAP TUNNEL
 Scale 200' = 1" Dec 12 '98

Southern Field..
 Wmstown Coll'y. .. WICONISCO TWP. DAUPHIN COUNTY PA..
 BEAR GAP SECTIONS, .. 17. LYKENS VALLEY DISTRICT..
 SUSQUEHANNA COLLIERIES CO.,

1 of 5.

JUN 9, 1972

MF

