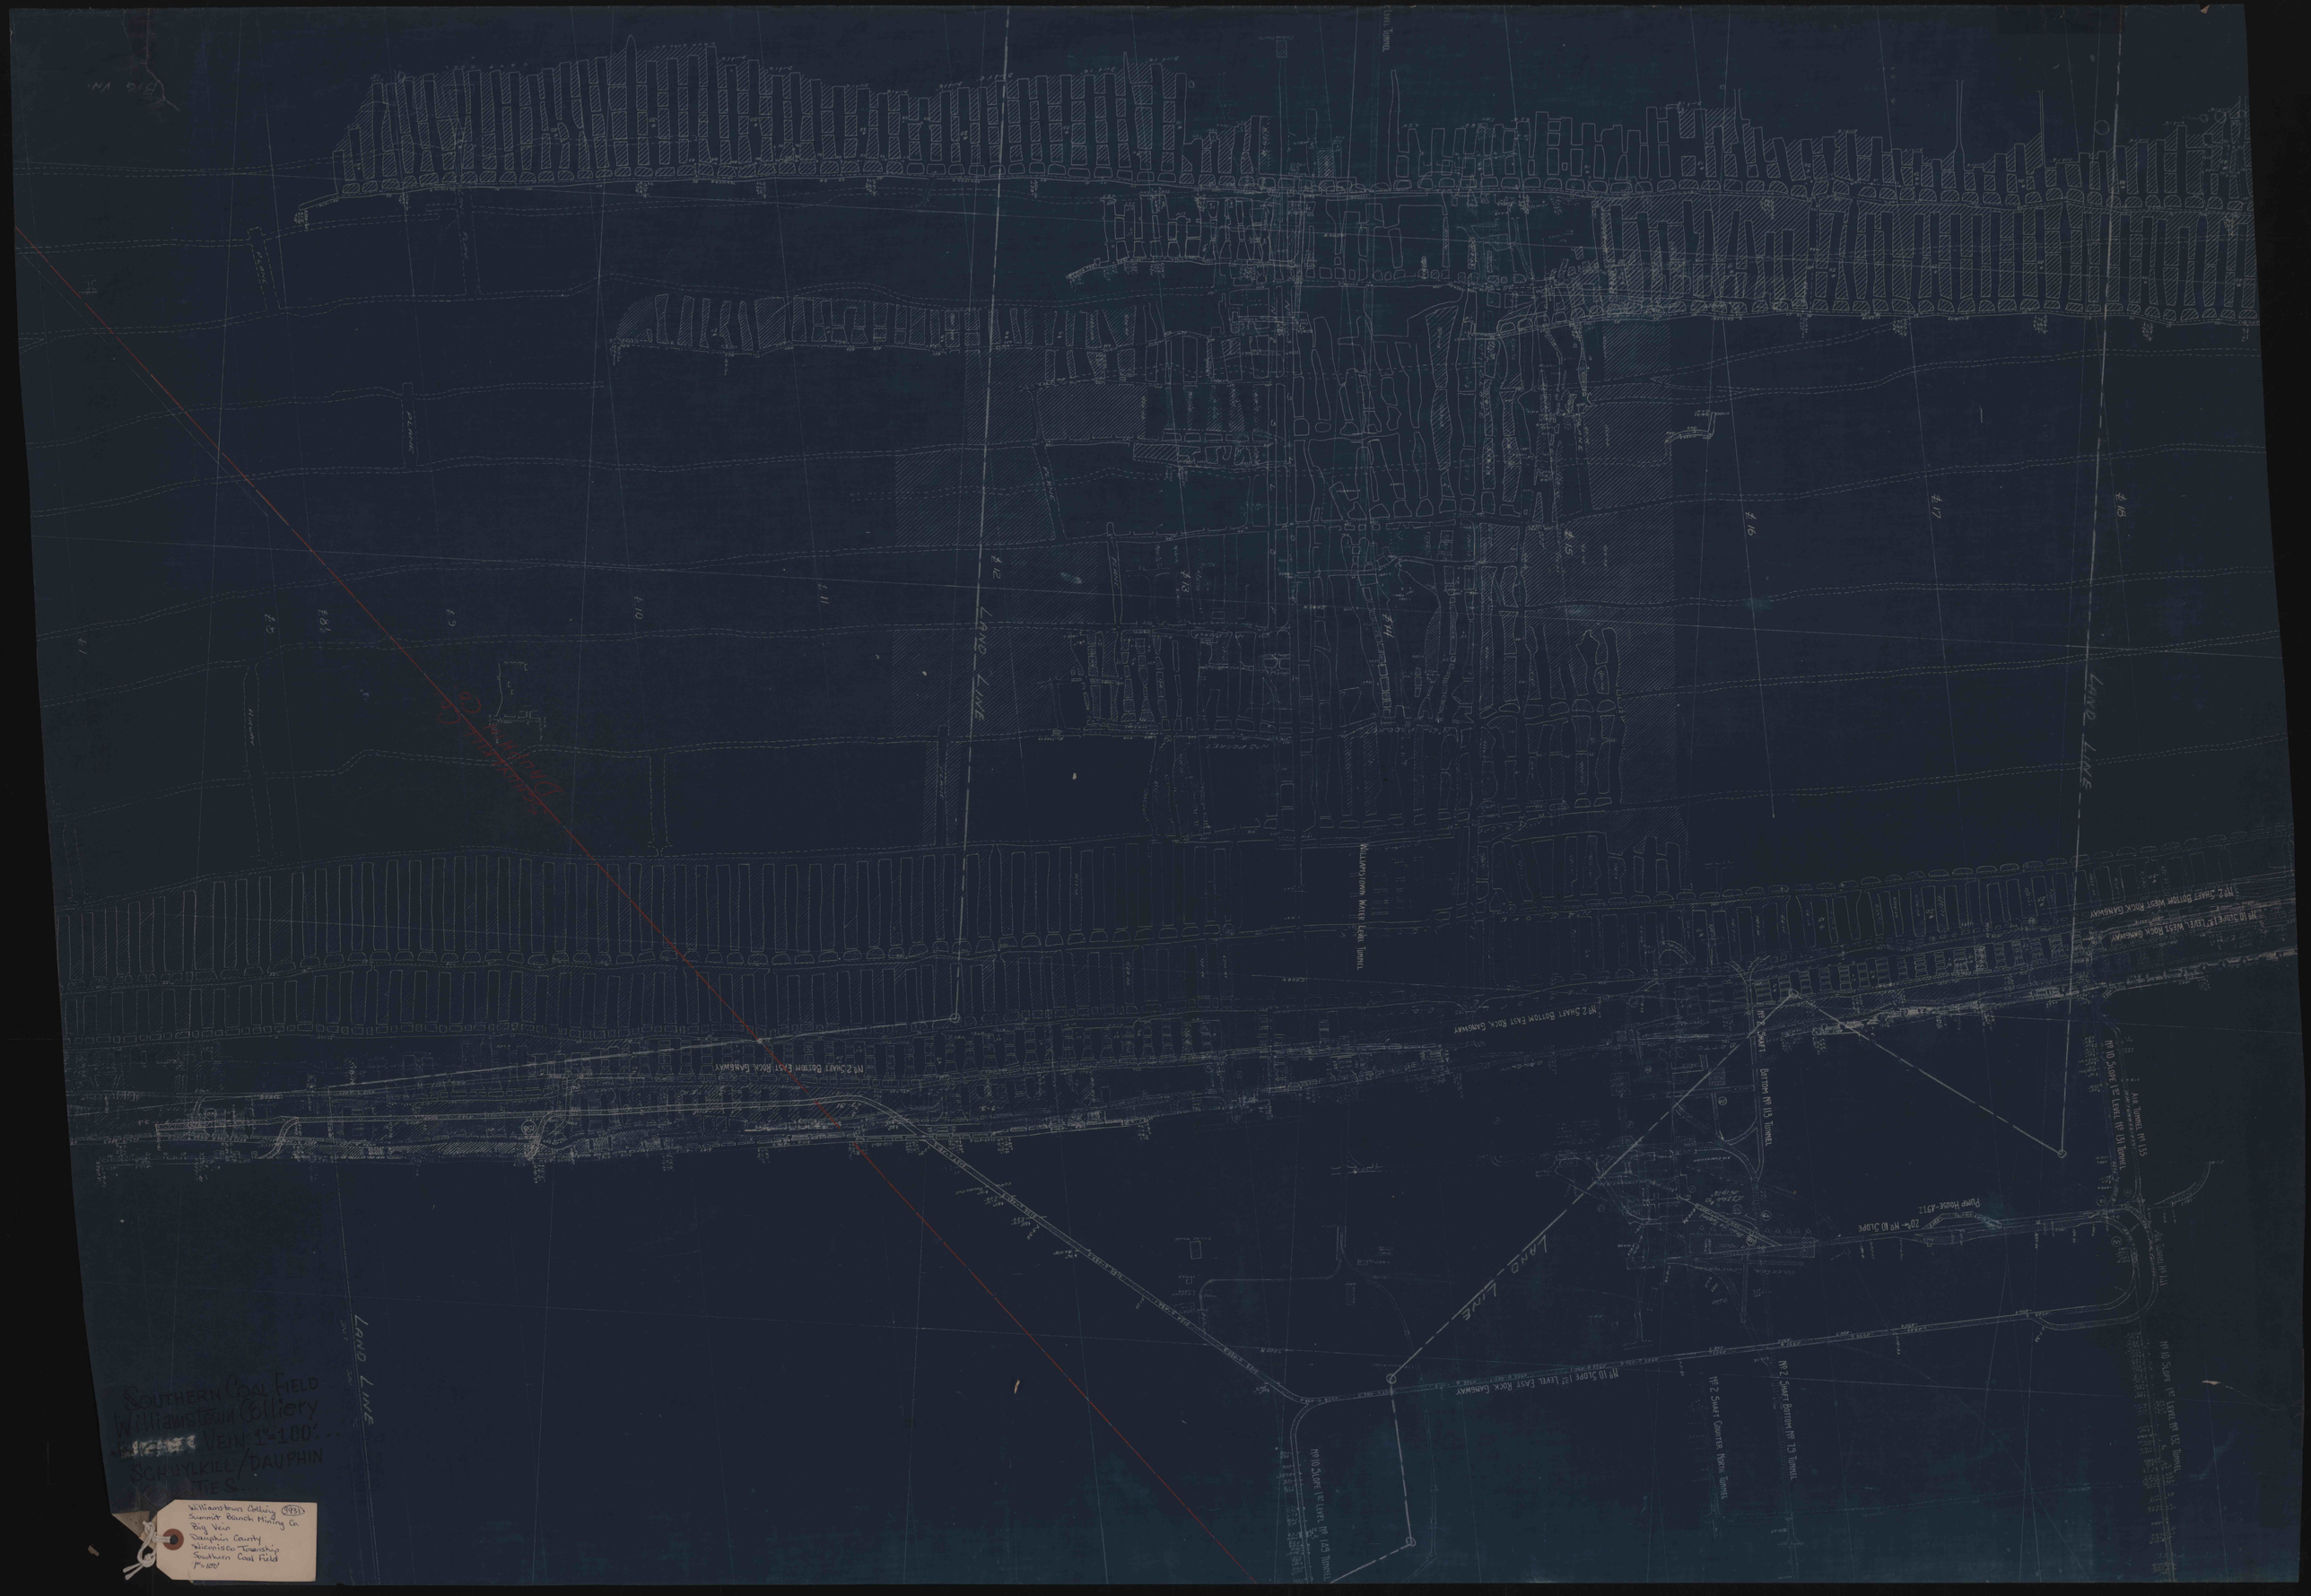
Land Line
Williamstown Water Level Tunnel
No 2 Shaft Bottom East Rock Gangway
No 2 Shaft Bottom West Rock Gangway
No 10 Slope 1st Level West Rock Gangway
No 10 Slope 1st Level East Rock Gangway
No 2 Shaft Bottom No 13 Tunnel
No 2 Shaft Bottom No 15 Tunnel
No 2 Shaft Counter North Tunnel
No 10 Slope 1st Level No 13 Tunnel
No 10 Slope 1st Level No 15 Tunnel
No 10 Slope 1st Level No 17 Tunnel
No 10 Slope 1st Level No 19 Tunnel
Air Tunnel No 15
20'- No 10 Slope
Pump House-4912
Southern Coal Field
Williamstown Colliery
Big Vein 1"=100'
Schuylkill/Dauphin
Counties
Williamstown Colliery (1931)
Summit Branch Mining Co.
Big Vein
Dauphin County
Wiconisco Township
Southern Coal Field
1"=100'