


93520

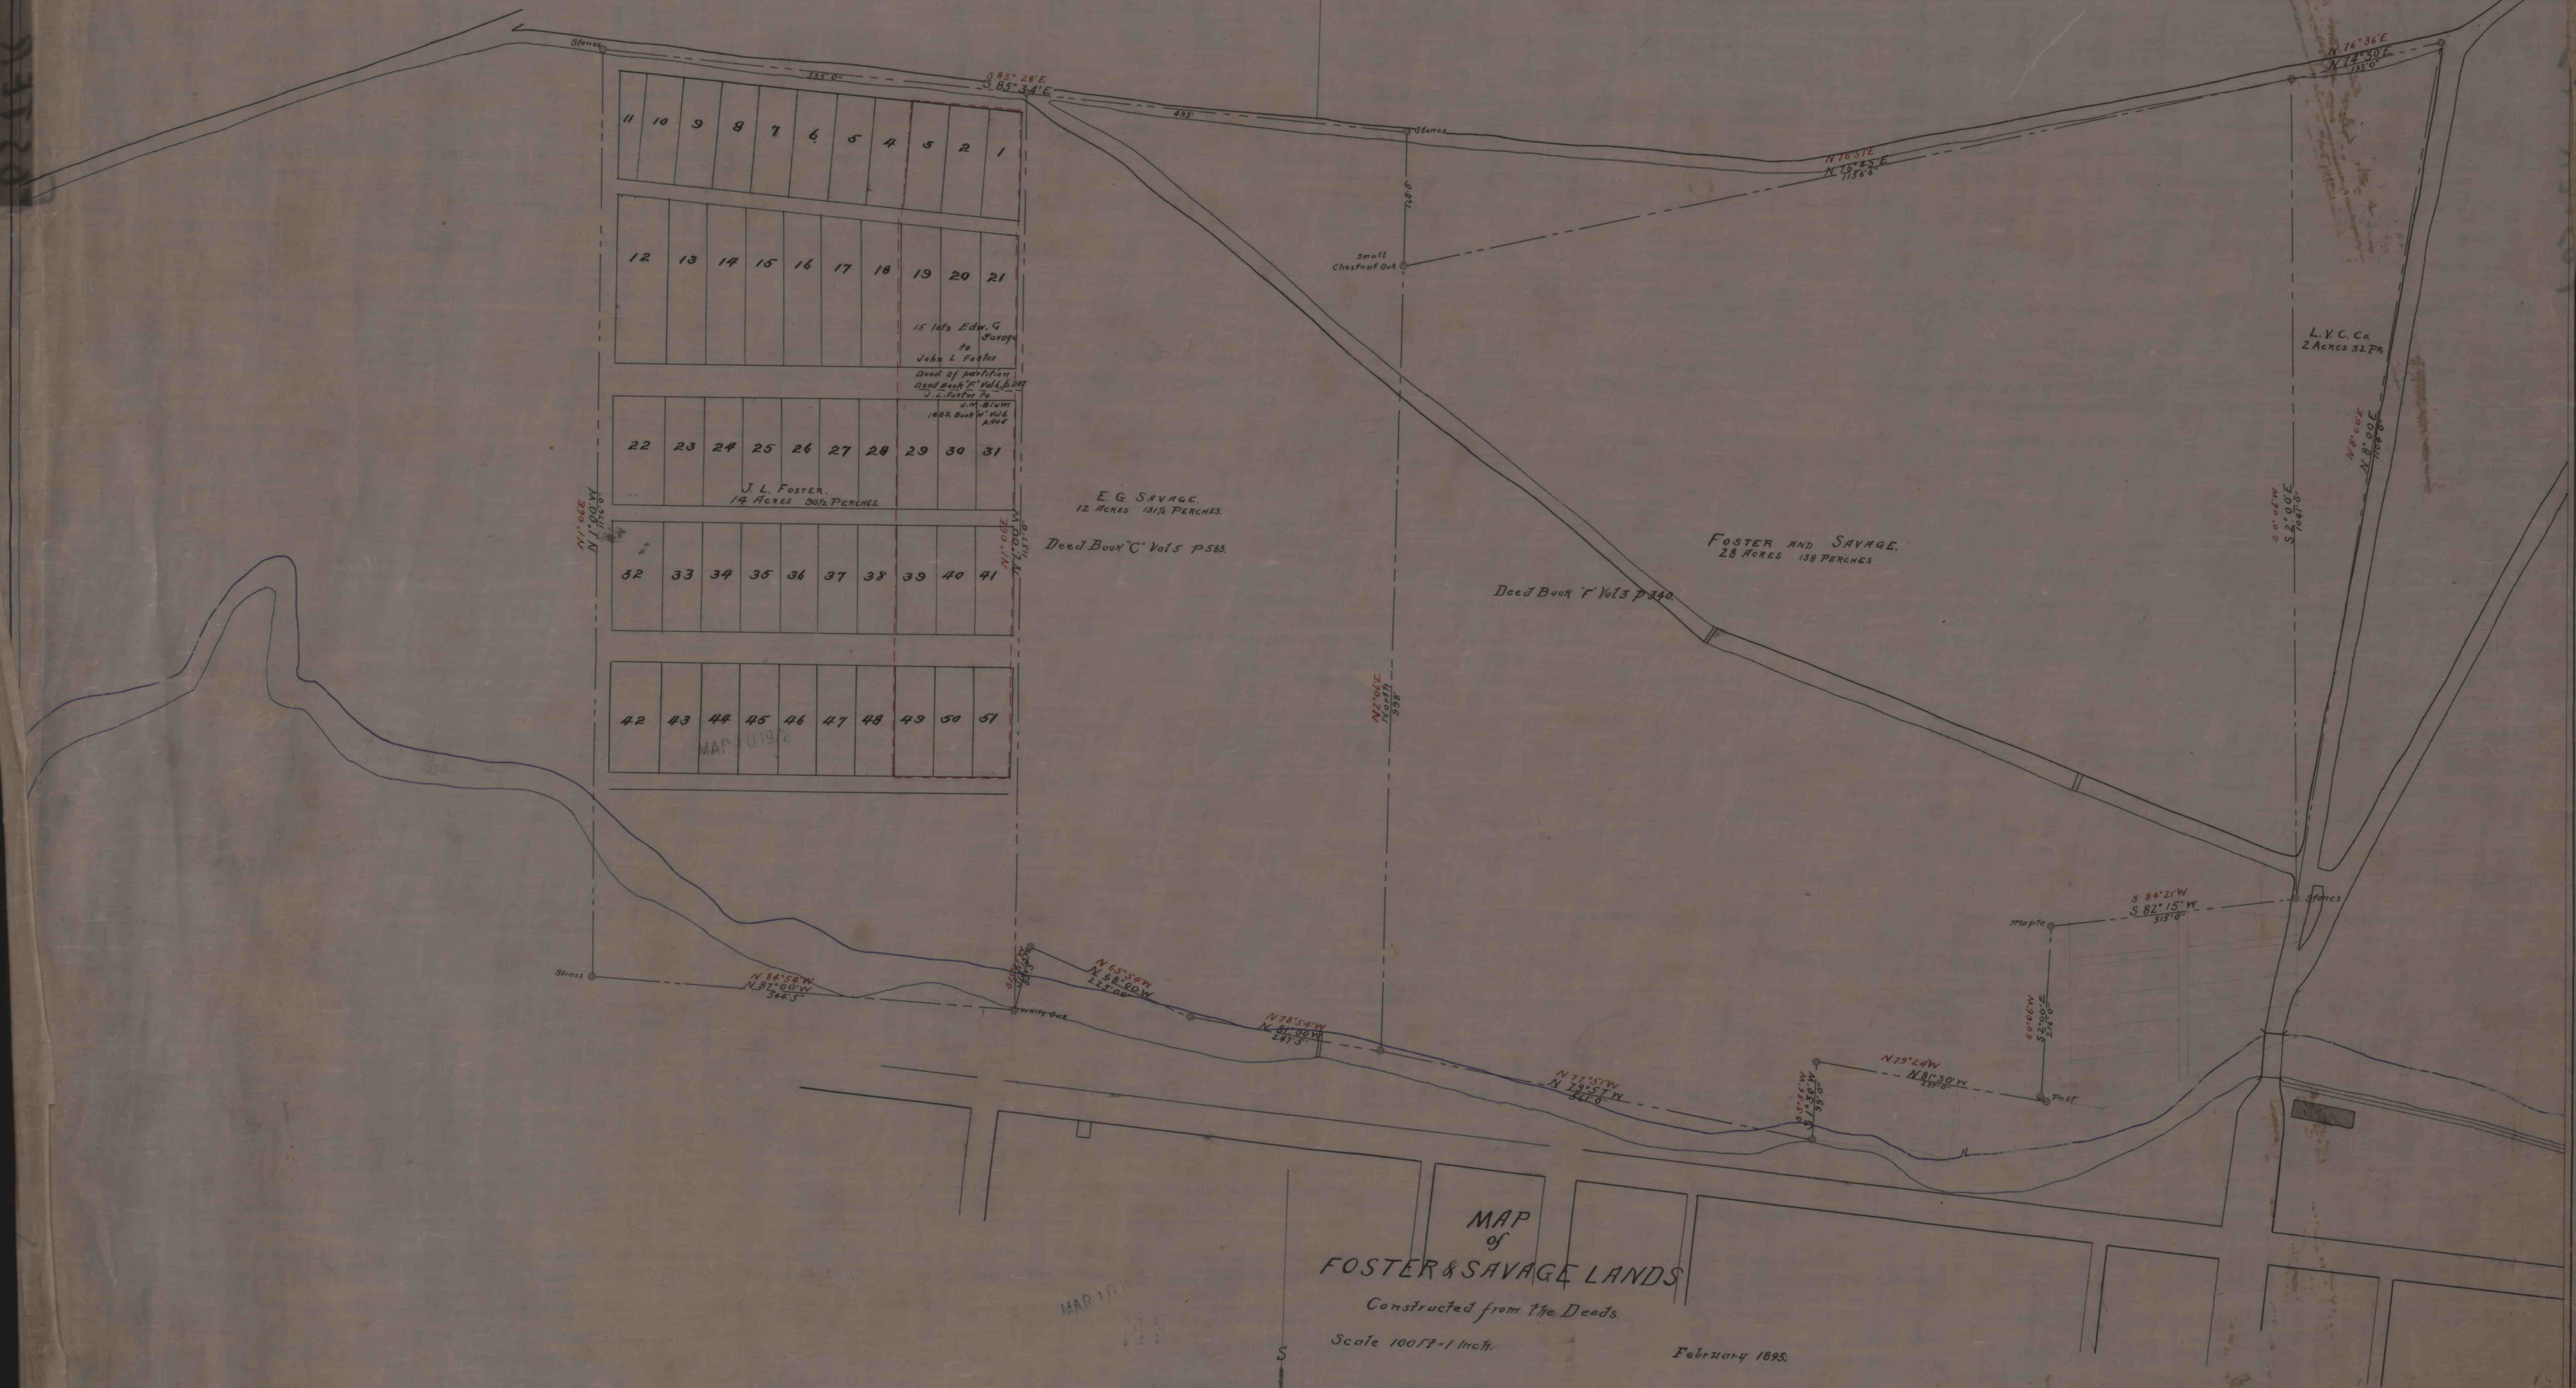

MAP of
FOSTER & SAVAGE LANDS

Constructed from the Deeds.
Scale 100 FT = 1 inch. February 1895.

NOTE- Courses in red are
meridian of 1895.

MF MAR 10 1892