


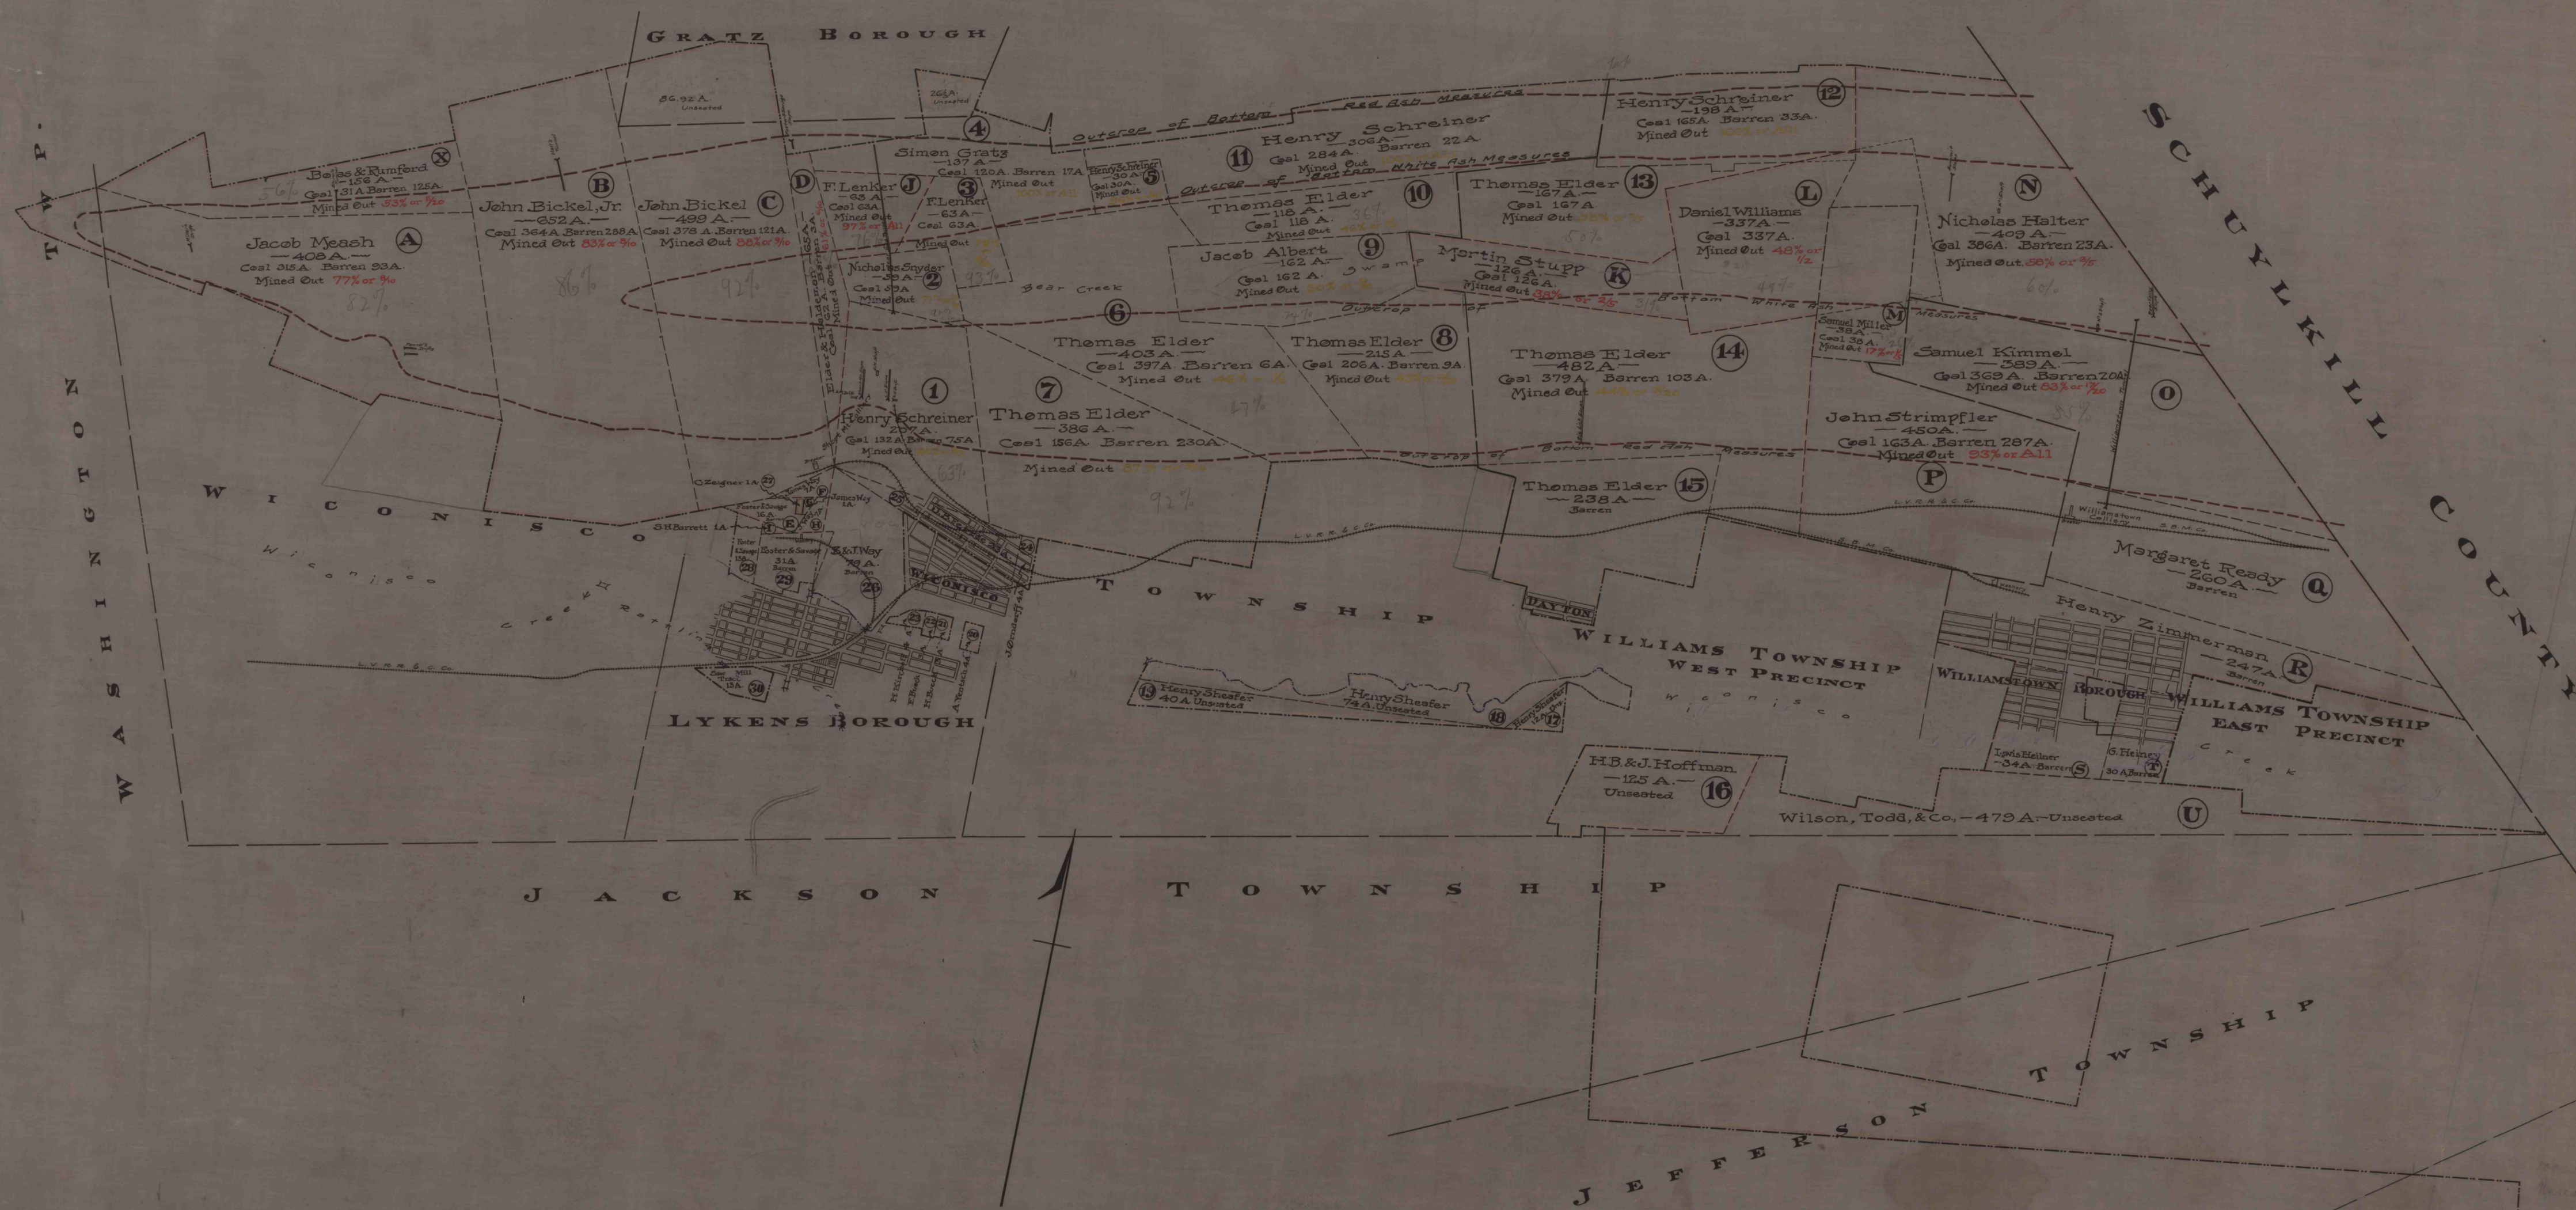

— Note —

S.B.M. Co. Tracts are enclosed in Red & Lettered
S.B.M. Co. Tracts are enclosed in Yellow & Numbered
Townships & Boro's are enclosed in White

Map of Lands of Summit Branch Mining Co.
and Summit Branch Mining Co., Ltd. Located in
Delphin County, Pa.
Scale 1250 ft. = 1 in.
L. H. H. Co., Inc., Mar. 11, 1913.
MAR 10 1912 SET: 1 of 14.
TRACINGS... C. P. Kutzner Dist. Eng'r.