


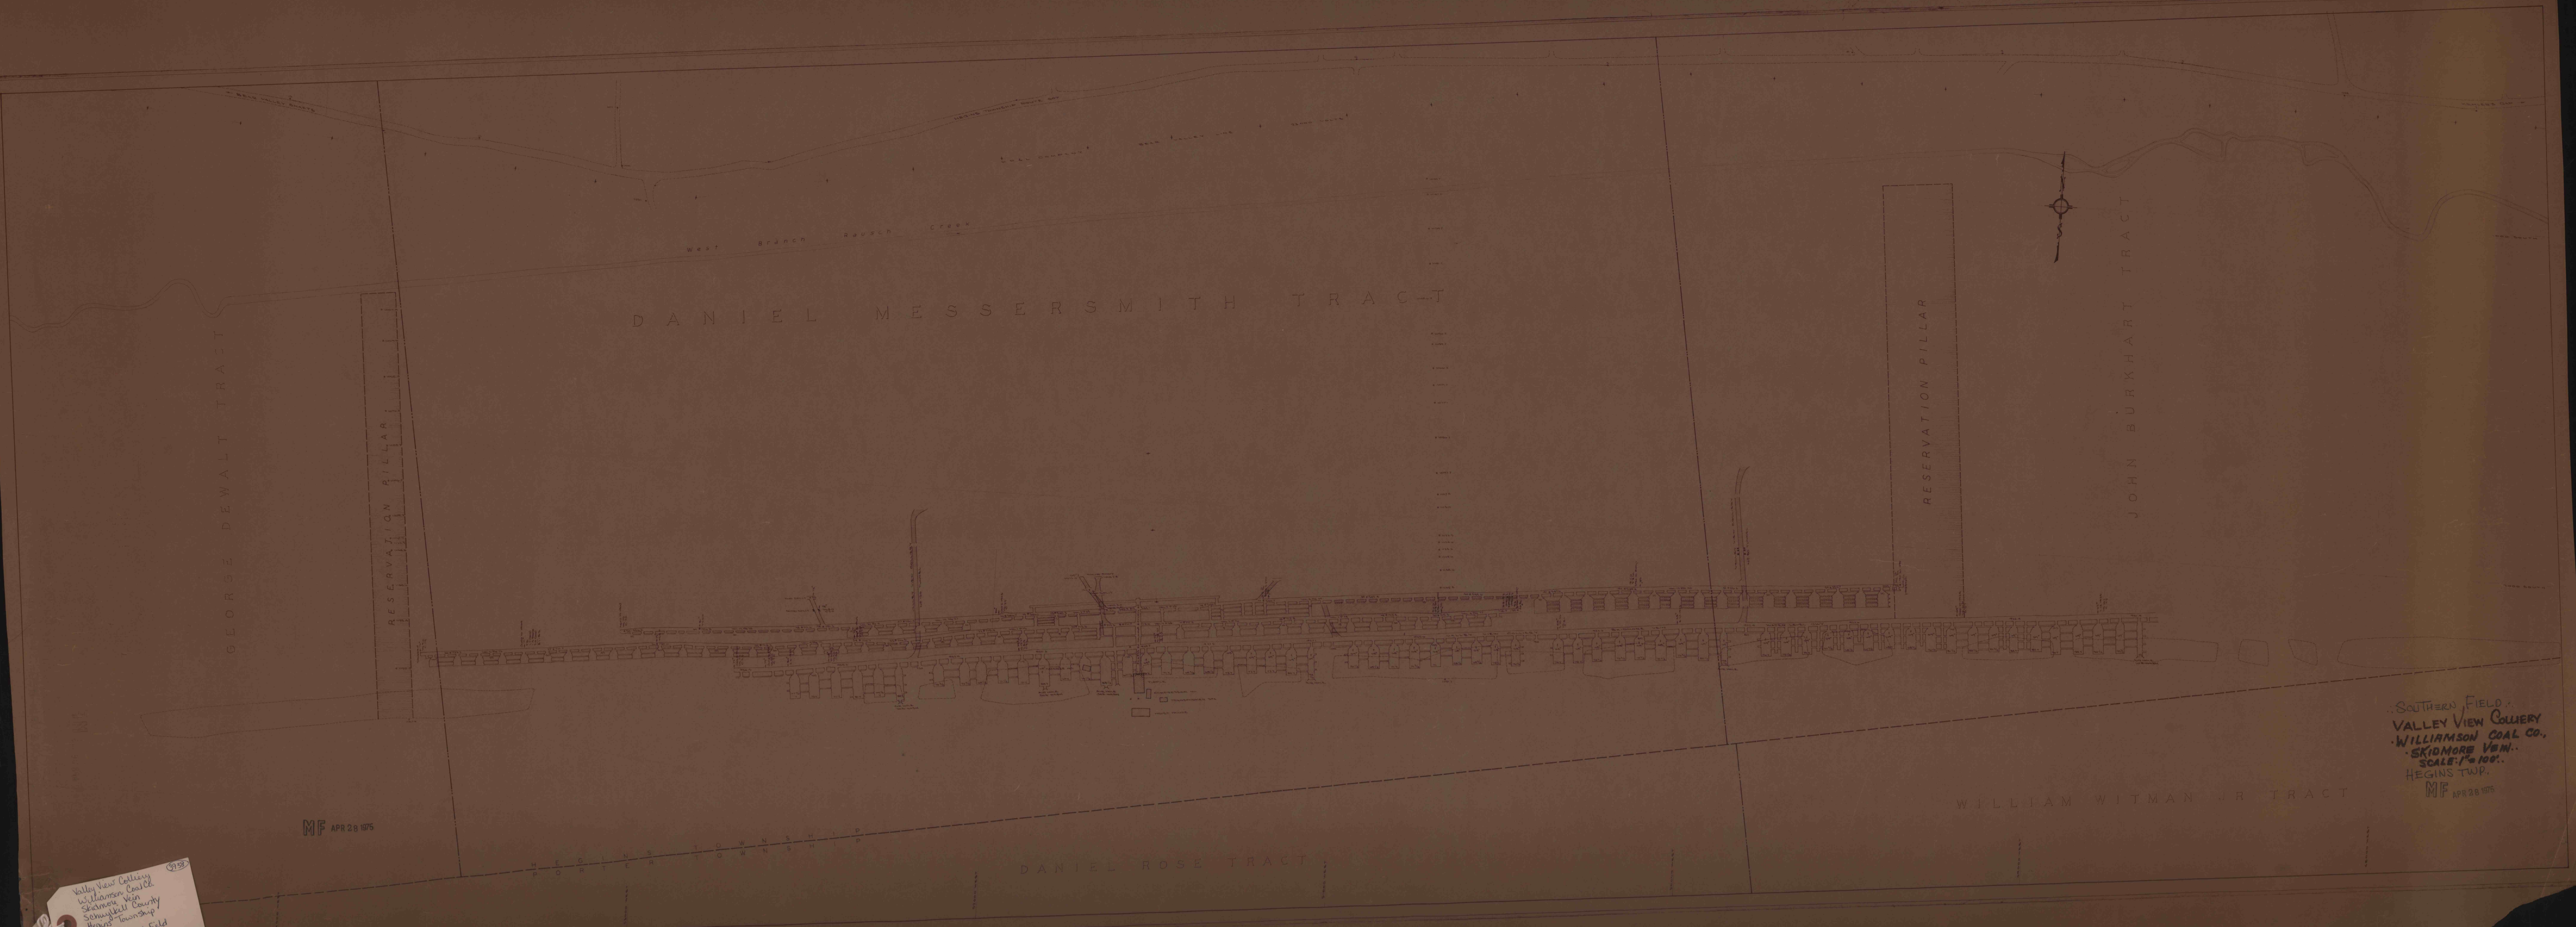

MF APR 28 1975

SOUTHERN FIELD
VALLEY VIEW COLLIERY
WILLIAMSON COAL CO.
SCALE: 1" = 100'.
MF APR 28 1975

Valley View Colliery
Williamson Coal Co.
Southern Coal Field
