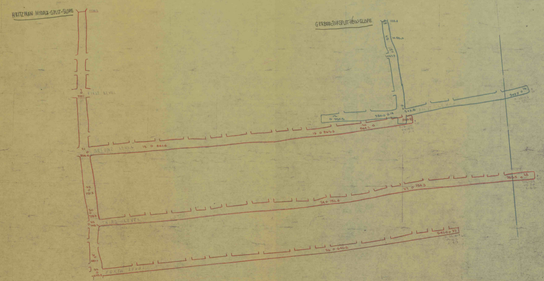

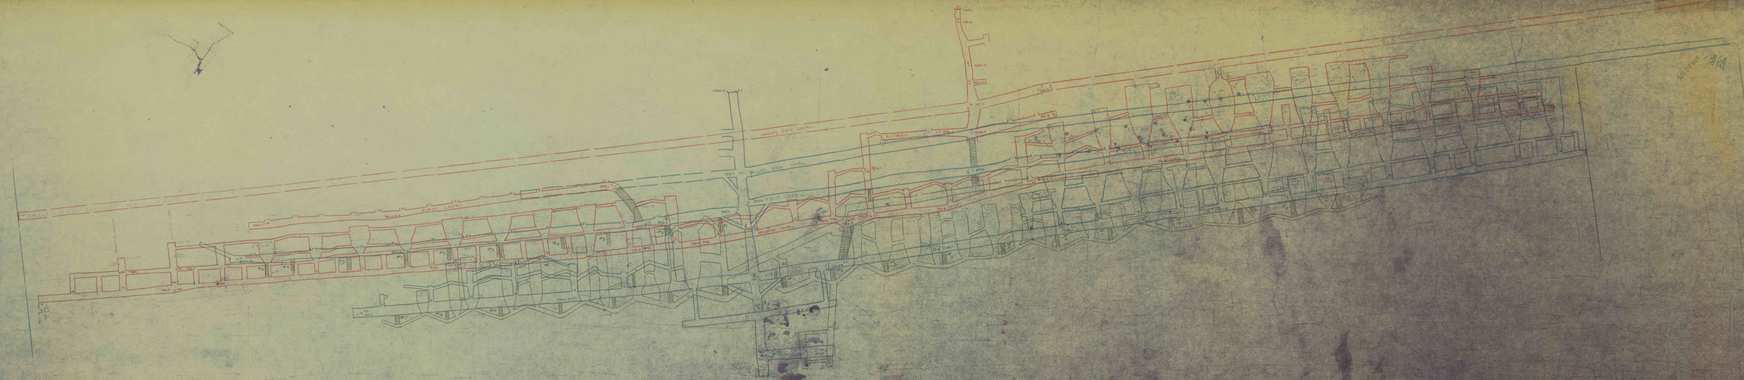

SOUTHERN FIELD
VALLEY VIEW COLLIERY 1:50' PARKWAY
MIDDLE SPLIT VEIN (ANTHRACITE) BERLIN TWP.
SCHUYLKILL COUNTY, PA.
2 OF 2 PAPERS.