


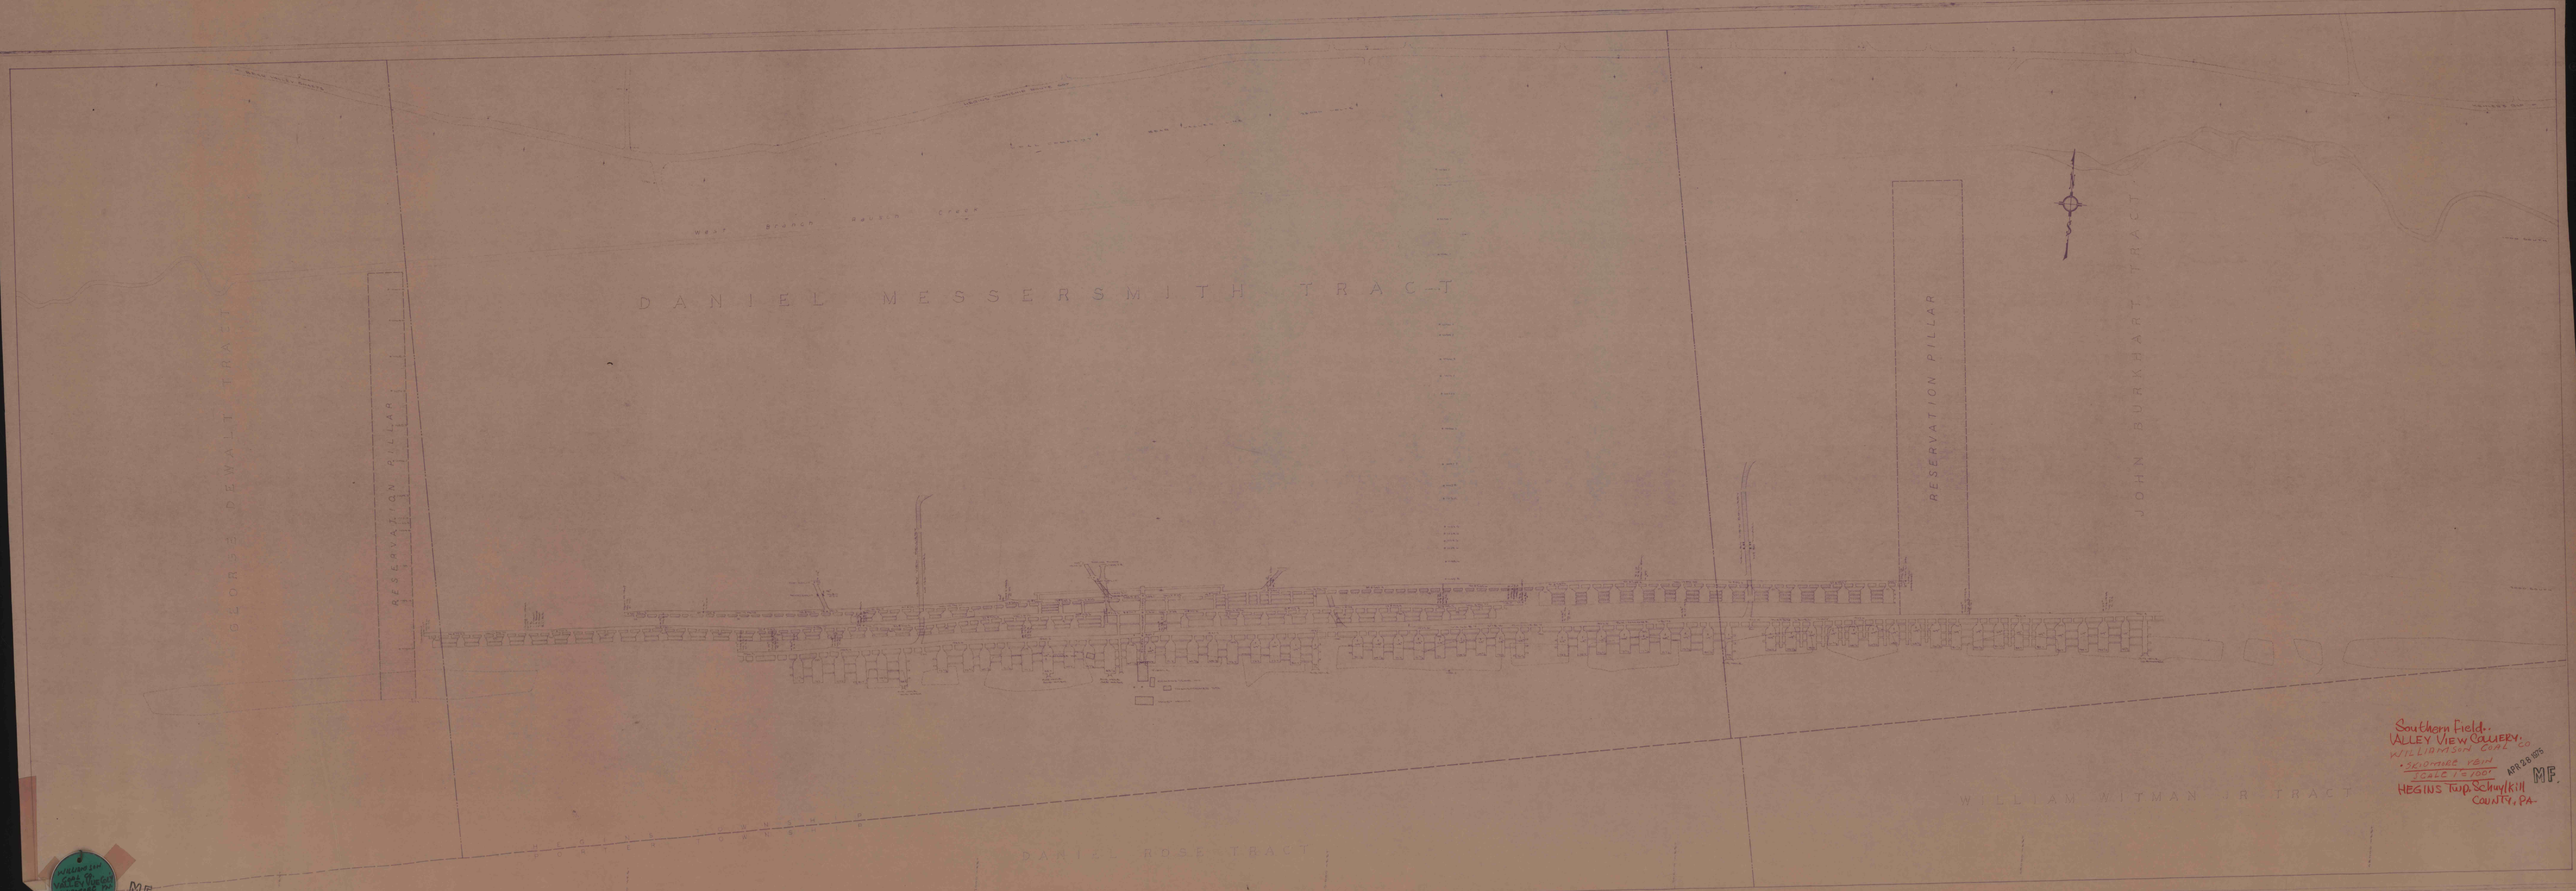

Southern Field,
WILLIAMSON COAL CO.
• SKIDMORE REIN
SCALE 1"=100'
APR 28 1975
HEGINS Twp. Schuylkill
COUNTY, PA.
MF.

WILLIAMSON
COAL CO.
SKIDMORE REIN
APR 28 1975
MF.