

DANIEL MESSERSMITH TRACT

GLORSE DEWALT TRACT

RESERVATION PILLAR


RESERVATION PILLAR

JOHN BURKHART TRACT

WILLIAM WITMAN TRACT

DANIEL ROSE TRACT

WEST BRANCH RAUCH CREEK

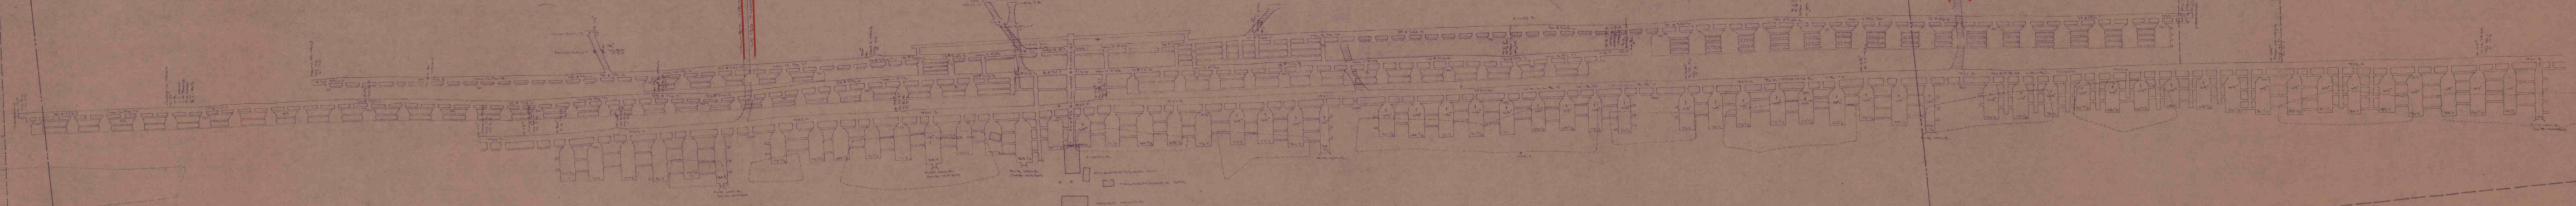

MF
APR 28 1975

Southern Field,
ALLEY VIEW COALERY,
WILLIAMSON CO., MO.
*SKIDMORE BLDG. HOSING TWP.
SCALE 1/4" = 100'. SCH. COUNTY MAP.
MF APR 28 1975