


SHADE COAL COMPANY
BUCK MOUNTAIN VEIN SLOPE

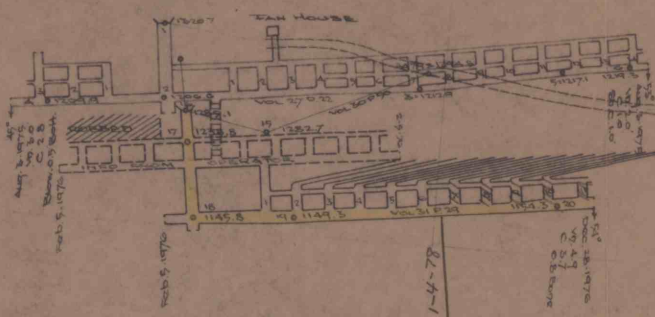

H&W NO 2 SLOPE

H&W NO 1 SLOPE

SHADE

DANIEL MESSERMITH TRACT

RAILWAY ANTHRACITE

BEAR VALLEY ROAD

SHADE COAL COMPANY
BUCK MOUNTAIN VEIN
SOUTHERN ANTHRACITE
COAL FIELD
HEGINS TOWNSHIP
SCHUYLKILL COUNTY
SCALE: 1" = 100'

SHADE COAL COMPANY - BEAR VALLEY		
HEGINS TOWNSHIP, SCHUYLKILL COUNTY		
SCALE: 1" = 100'	APPROVED BY	DRAWN BY A.C.C.
DATE: Aug 5, 1975	South Dip Buck Mountain Vein - North Line Bear Valley	
Syncline - G.M.P. Land Corp. Property		
Revised - Dec 28, 1975		

April B. Reed