


RECEIVED

04 OCT 14 AM 7:13

DEP. M.T. SAFETY
POTTSVILLE OFFICE

CHESTNUT COAL
No. 11 Slope
Zerbe Twp.
Northumberland County
No. 6 Vein
Sept. 16, 2004 - FINAL MAP
Scale: 1" = 100'
5022

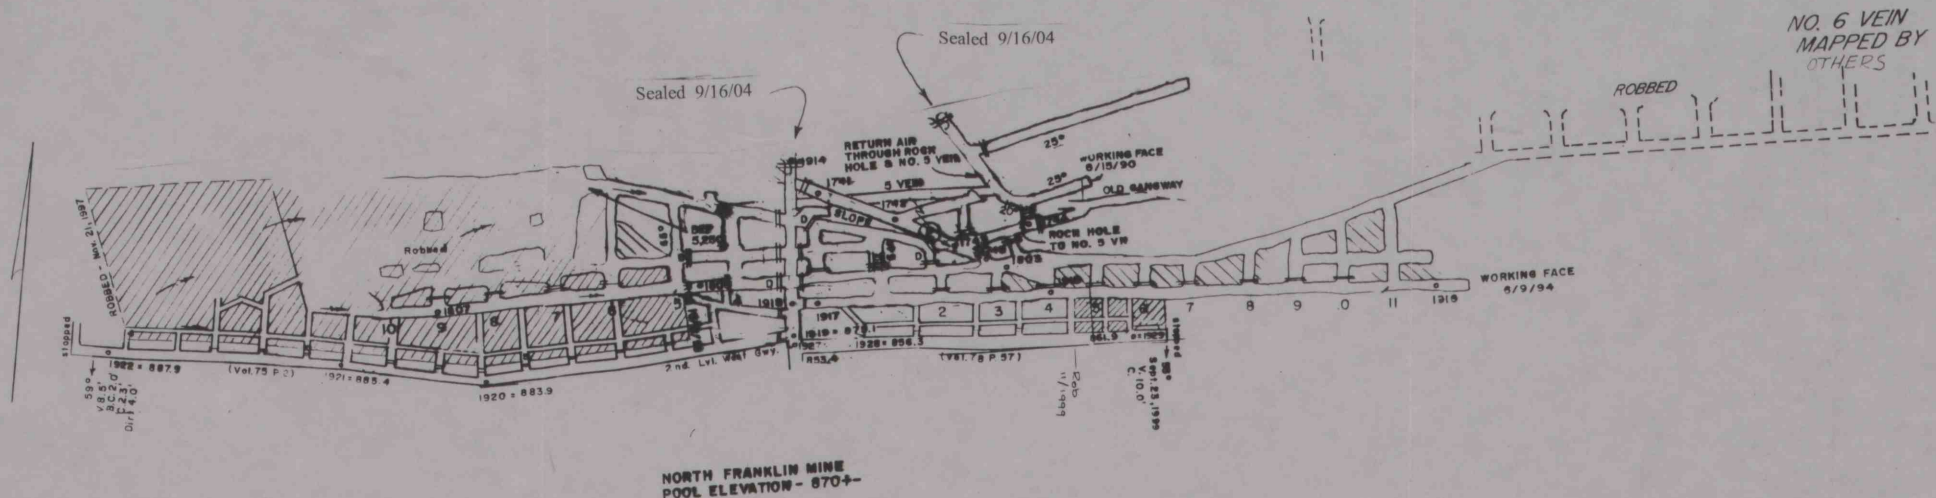

No. 11 Slope
MSHA I.D.#36-07059
DEP U.M.P.#49851308

Surveyor Certification

I hereby certify that to the best of my knowledge that the areas that I have surveyed are true and correct. All other information shown have been derived from the best available information, but can not be field checked. Therefore, surveyor makes no certification to their accuracy. All survey work was completed prior to June 1, 2004 and surveyor is only certifying this information in verification of his records.

David L. Williams
Surveyor

Statement for Final Mine Map

Date: 10-13-04

This map represents a complete and accurate representation of all underground mine excavations by our company and that the map is the "Final" mine map for this operation.

Robert J. Shinn
Signature of Company or Corporate Officer

FINAL MINE MAP CHESTNUT COAL

LOCATED IN

ZERBE TOWNSHIP
NORTHUMBERLAND COUNTY
PENNSYLVANIA

SCALE: 1 INCH = 100 FEET SEPT. 16, 2004